


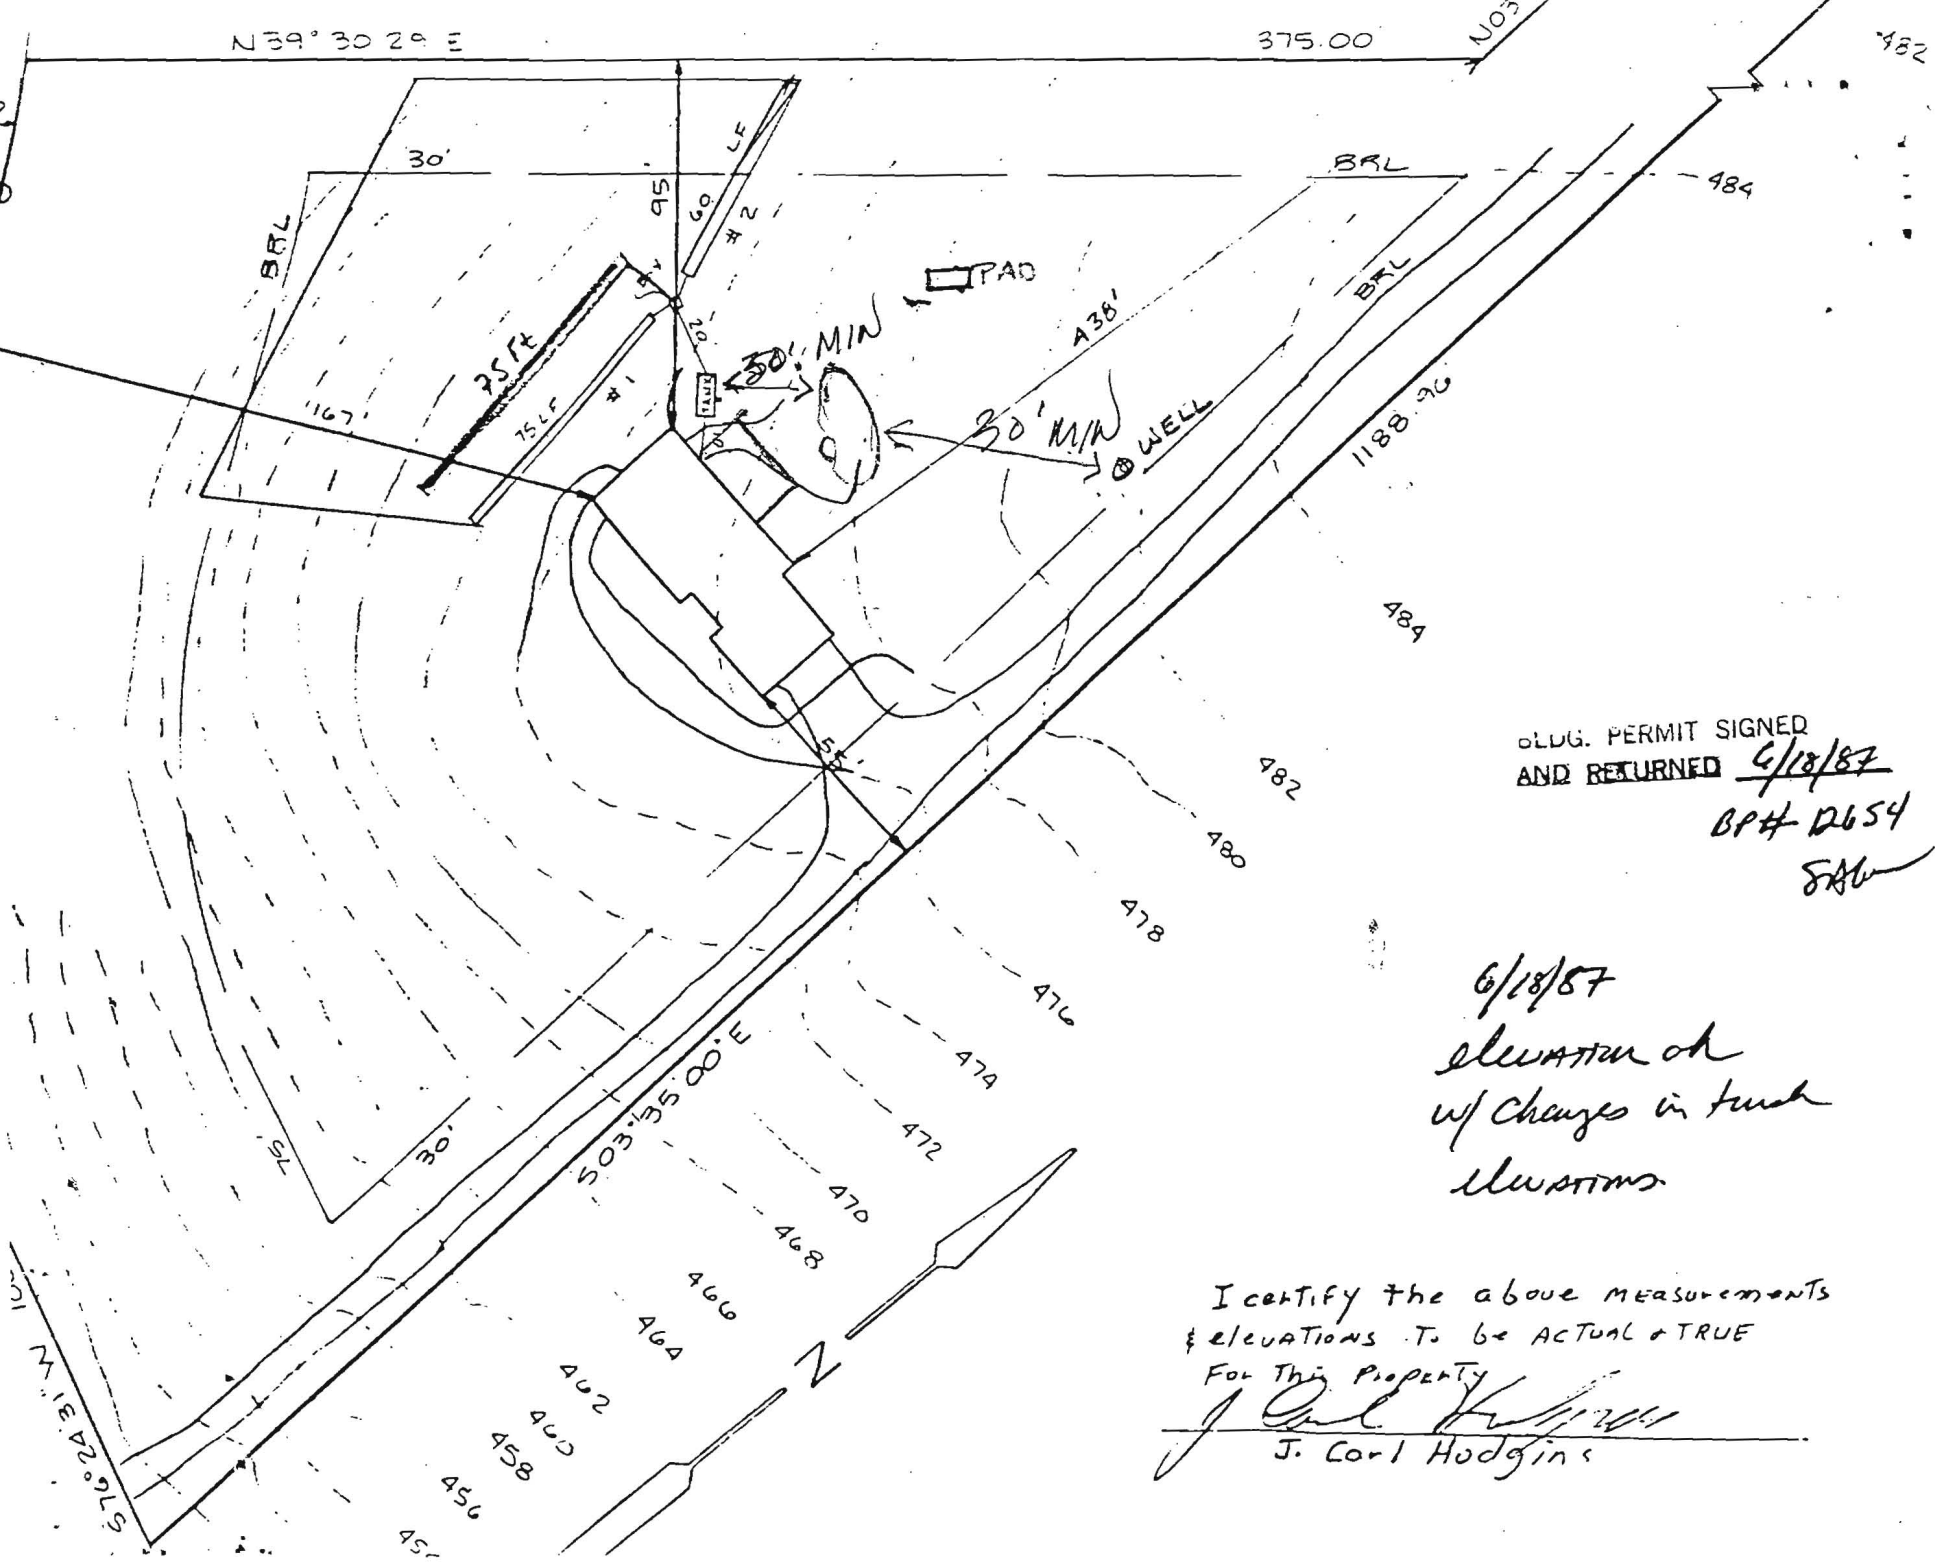

BLDG. PERMIT SIGNED
 AND RETURNED 6/18/87
 BP# D654
 SAG

6/18/87
 elevation ok
 w/ changes in trench
 elevations

I certify the above measurements
 & elevations to be ACTUAL & TRUE
 For This Property
 J. Carl Hodgins

LOT 1 BRUFFEY PROPERTY
TAX MAP 27
5TH ELECTION DIST.
HOWARD CO., MD.
1" $\pm$ APPROX 50'

