

PERMIT

SEWAGE DISPOSAL SYSTEM

MARYLAND STATE DEPARTMENT OF HEALTH

HOWARD COUNTY

INDEXED

ELLICOTT CITY

DISTRICT 4

DATE 8/15/71

Facilla Builders

IS PERMITTED TO INSTALL X ALTER

ADDRESS 10014 Norrell Avenue, Glendale, Maryland

PHONE 290-6509

A SEWAGE DISPOSAL SYSTEM LOCATED AT

SUBDIVISION Warfield Estates

3462
ROAD Shady Lane

LOT 3, Blk. B, Sec.

PROPERTY OWNER William Traynham
Maple Hill Farms Associates

ADDRESS

SPECIFICATIONS - 3 bedrooms

DRAIN FIELD DEPTH FEET. BOTTOM AREA SQ. FT.

SEEPAGE PITS ABSORBENT SIDE-WALL AREA SQ. FT.

SEPTIC TANK CAPACITY 1,000 GALLONS

FOR GARBAGE GRINDER, INCREASE DISPOSAL AREA 22% & TANK CAPACITY 50%.

OTHER Dry well - 360 sq. ft. sidewall area below inlet with inlet no deeper than

4 ft. and bottom no deeper than 11 ft. Place the dry well 150 ft. from the front

lot line and 50 ft. from the left side of the lot as seen when facing the lot from

Shady Lane.

NOTE: ALL PIPE FROM HOUSE TO SEPTIC TANK MUST BE CAST IRON.

PERMIT VOID AFTER THREE YEARS.

NOTE: INSTALL STAND PIPE ON SEPTIC TANK AND DRY WELL.

PLANS APPROVED BY Raymond Hodges

DATE 8/9/71

FILL SEPTIC TANK AND DISTRIBUTION BOX WITH WATER BEFORE CALLING FOR AN INSPECTION. COVER NO WORK UNTIL INSPECTED AND APPROVED.

NEITHER THE HOWARD COUNTY COMMISSIONERS NOR THE HEALTH DEPARTMENT IS RESPONSIBLE FOR THE SUCCESSFUL OPERATION OF ANY SYSTEM.


BLDG. PERMIT SIGNED
AND RETURNED 8/14/73

Serial # 55795
2 car garage

BLDG. PERMIT SIGNED
AND RETURNED 8/15/73

Serial # 55797
3 deck

12
 10
 20
 125
 18
 11
 10
 15
 20
 5
 300

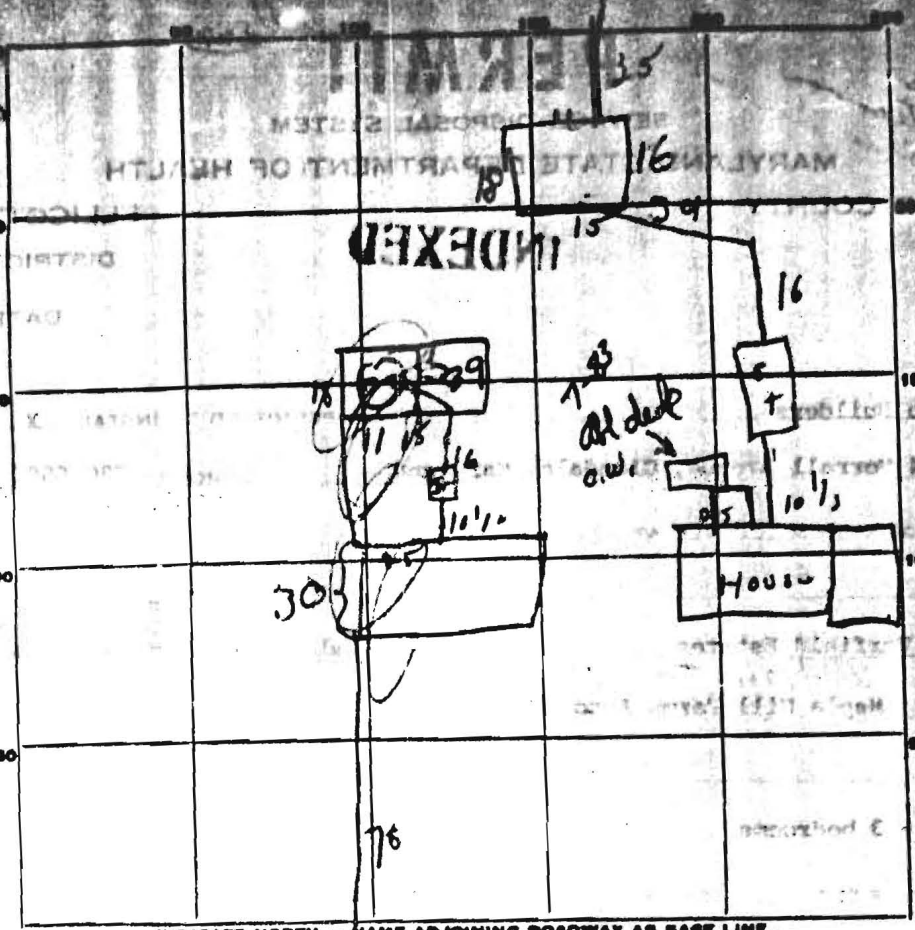

10/10/83
 15.
 garage
 10' x 10'
 content

INDICATE NORTH - NAME ADJOINING ROADWAY AS BASE LINE.
 Shady Lane

PERMIT CARD _____
 SEPTIC TANK, LEVEL OK CLEANOUTS OK
 DISTRIBUTION BOX, LEVEL _____
 TILE FIELD, DEPTH _____ FT. TRENCH WIDTH _____ FT.
 GRAVEL DEPTH _____ IN. TOTAL LENGTH _____ FT.
 NUMBER OF TRENCHES _____ TOTAL BOTTOM AREA _____
 SEEPAGE PITS, INSIDE DIAMETER 60 FT. DEPTH BELOW INLET 5 FT.
 ABSORBENT AREA 300 SQ. FT.

REMARKS 6-2-72 - trench 30 ft long - 18" wide - 5 ft deep below dry well
did 2 ft of gravel in trench

DATE SYSTEM APPROVED 7/21/72 INSPECTOR [Signature]