

X Perc 4 min  
160 ft/s  
Inlet 3.0'  
Bottom 9.0


INDICATE NORTH. - NAME ADJOINING ROADWAY AS BASE LINE.

SILHOP Rd.

DATE	TEST NO.	DEPTH	PRE-WET		TEST - 1" DROP		TIME
			START	STOP	START	STOP	
9/2/88	A S	3.5"	10:16	10:18	10:18	10:20	2 MIN
		7.5"	10:15	10:17	10:17	10:21	4 MIN
	A V	13"	UNIFORM soil below 3.5'				
	B S	3.5	10:24	10:26	10:26	10:28	2 MIN
		7.5	10:24	10:26	10:26	10:31	5 MIN
	B V	13"	UNIFORM soil below 3.5'				
	C V	13"	CLAY REP Brown				
		Similar to H A w/ 3.5" OR CLAY					

REMARKS Deep syst repair OK / shall

TYPE OF SOIL Chesapeake loam

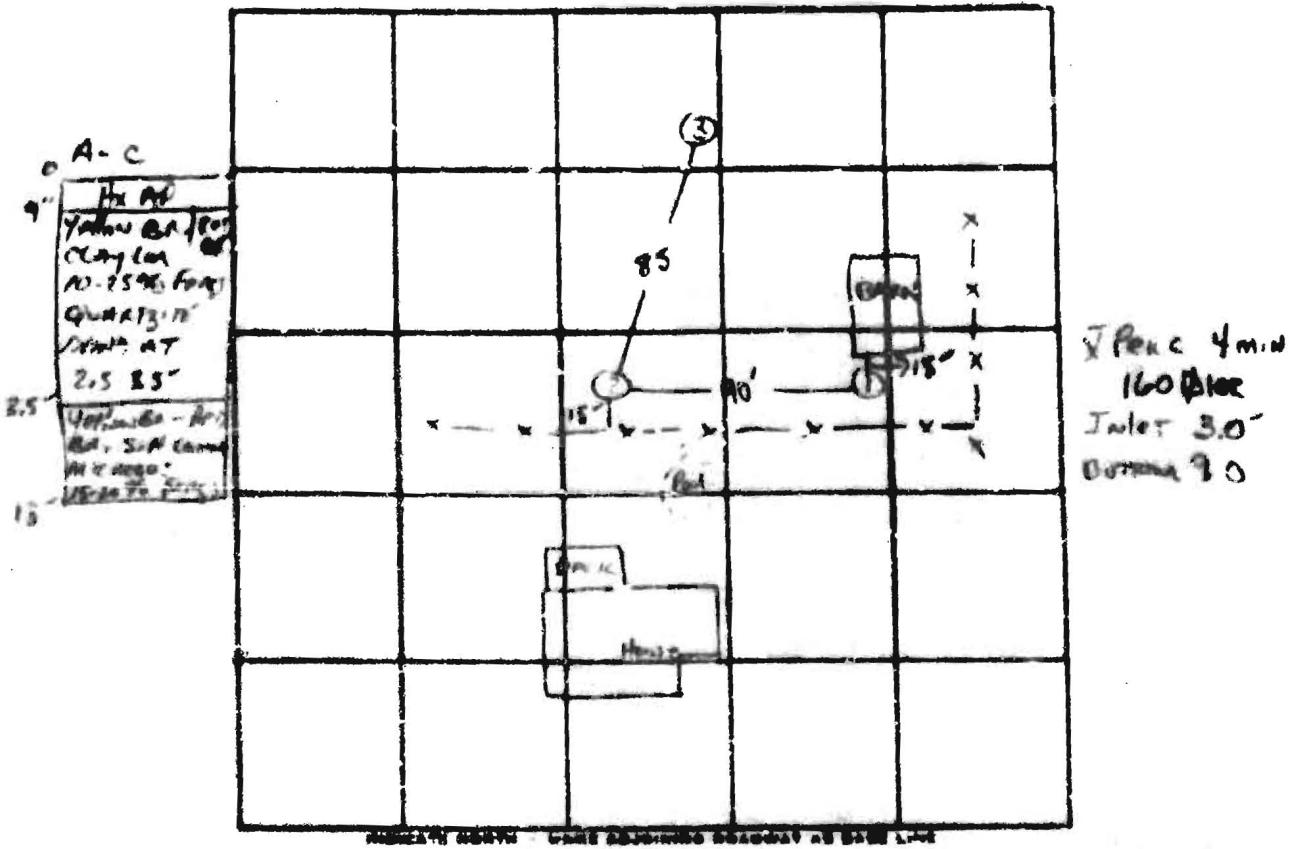

DEPT. OF STATE PREDICTS FOR 1951

TYPE OF DISEASE Chronic Granulitis