

4/22/81

after 1/23/81
as soon as possible

PERMIT

SEWAGE DISPOSAL SYSTEM

MARYLAND STATE DEPARTMENT OF HEALTH

HOWARD COUNTY

ELLCOTT CITY

DISTRICT 012

INDEXED

DATE 1/22/81

FOR FROM IS PERMITTED TO INSTALL 2 ALTER

ADDRESS 1775 Philadelphia Road, Slacks, Md. 21737 PHONE 284-2272

SUBDIVISION Glenwood Estates ROAD 3690 Sully Road LOT 42

PROPERTY OWNER Richard Johnson Henry White

ADDRESS 3450 336 Columbia Road, Laurel, Md. 20719 PHONE: 304-6373 or 638-2092

SPECIFICATIONS 2 Pederson

SEPTIC TANK CAPACITY 1000 GALLONS
DRAIN FIELD DEPTH FEET BOTTOM AREA 90 FT
DEEP TRENCH DEPTH FEET BOTTOM AREA 90 FT
SLOPE OF PYS ACCORDENT SIDE WALL AREA 90 FT
INLET PIPE FT BELOW ORIGINAL GRADE MAXIMUM DEPTH FT BELOW ORIGINAL GRADE
EFFECTIVE DEPTH AT FT BELOW ORIGINAL GRADE
LOCATE DISPOSAL AREA FT FROM LOT LINE AND FT FROM LOT LINE AS SHOWN

FRENCH SYSTEM - We have 100 linear feet of trench or 3 - 30 ft. long trenches. Inlet to trench to be no deeper than 4 ft. below original grade. Effective depth begins at 6 ft. below original grade. Maximum depth permitted for trench is 40 1/2 ft. below original grade. Place the trench 17 1/2 ft. from the front property line and 16 ft. from the right lot line as soon when facing the property from Sharp Road. Place the trench parallel to Sharp Road running Northwest. Call for inspection of trench before gravel is installed.
per change has to original plan E.S.

PLANS APPROVED BY Frank A. Giamatti DATE 4/26/78 & 1/22/81

COVER NO WORK UNTIL INSPECTED AND APPROVED
NEITHER THE HOWARD COUNTY COUNCIL NOR THE HEALTH DEPARTMENT IS RESPONSIBLE FOR THE SUCCESSFUL OPERATION OF ANY SYSTEM
NOTE IF TRENCH IS USED CALL FOR INSPECTION BEFORE PLACING GRAVEL IN TRENCH
NOTE NO DRY WELL SHALL EXCEED 18 FEET IN DIAMETER
NOTE ALL PIPE FROM HOUSE TO DISPOSAL AREA MUST BE CAST IRON
PERMIT VOID AFTER THREE YEARS
NOTE INSTALL STAND PIPE ON SEPTIC TANK AND DRY WELL STAND PIPES MUST BE 6 INCHES IN DIAMETER CAST IRON, CONCRETE OR TERRAZO
COTTA ACCEPTED

INSTALLER IS RESPONSIBLE FOR OBTAINING FINAL APPROVAL ON THIS PERMIT.

MD - 23

RECEIVED PERMIT
AND RETURNED 9/4/81
2nd 120771 - pmt

120105

Kevin

called

4/14/05

4/18/05


PLEASE CALL:

HOLLY FARNELLA-410-442-2203

RE: 3650 SHARP ROAD

WANTS TO TEAR DOWN EXISTING
HOUSE, BUILD A NEW HOUSE
+ USE THE SEPTIC AREA
(EXISTING) & MAYBE ONLY
REPLACE THE SEPTIC TANK

Sharon
Stephens

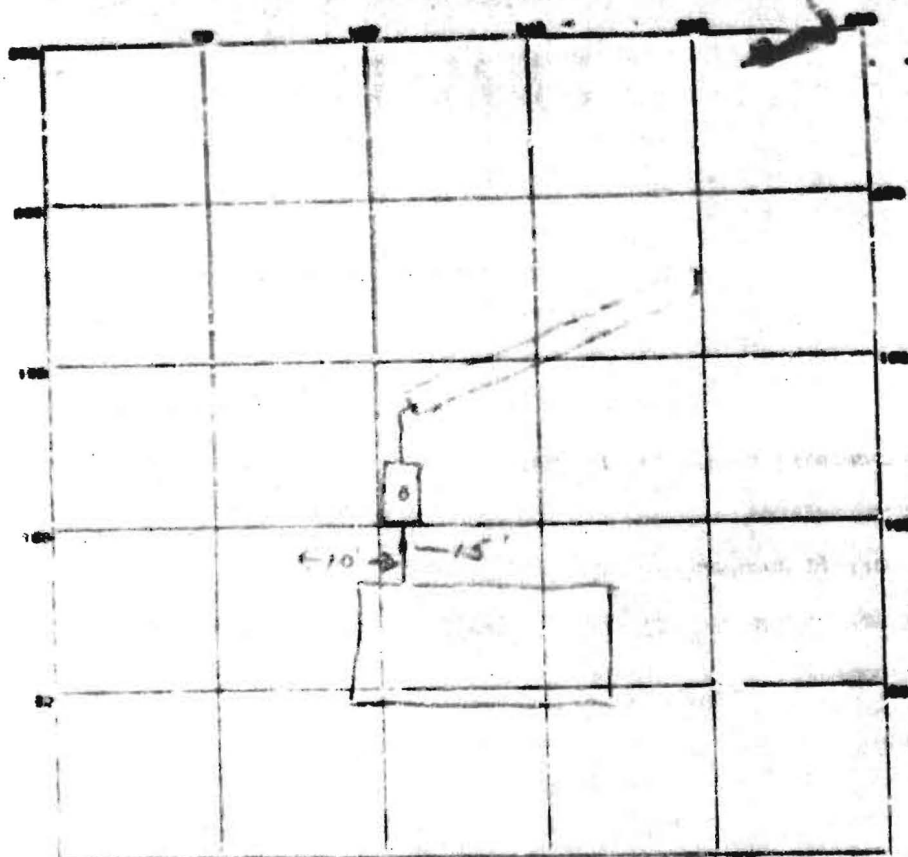

INDICATE NORTH - DASH ADJOINING ROADWAY AS BASE LINE

PERMIT 2-493

SEPTIC TANK, LEVEL

CLEANOUT

DISTRIBUTION BOX, LEVEL

TILE FIELD, DEPTH 14 1/2 FT. TRENCH WIDTH 2 FT.

GRAVEL DEPTH 8 IN. TOTAL LENGTH 100 FT.

NUMBER OF TRENCHES 1 TOTAL BOTTOM AREA 550

SEEPAGE PITS, INSIDE DIAMETER _____ FT. DEPTH BELOW INLET _____ FT.

ABSORBENT AREA 550 SQ. FT.


REMARKS 1/22/81 OK to add gravel in trench #8

1/23/81 OK to cover all with #4 SK

DATE SYSTEM APPROVED

INSPECTOR

R20107

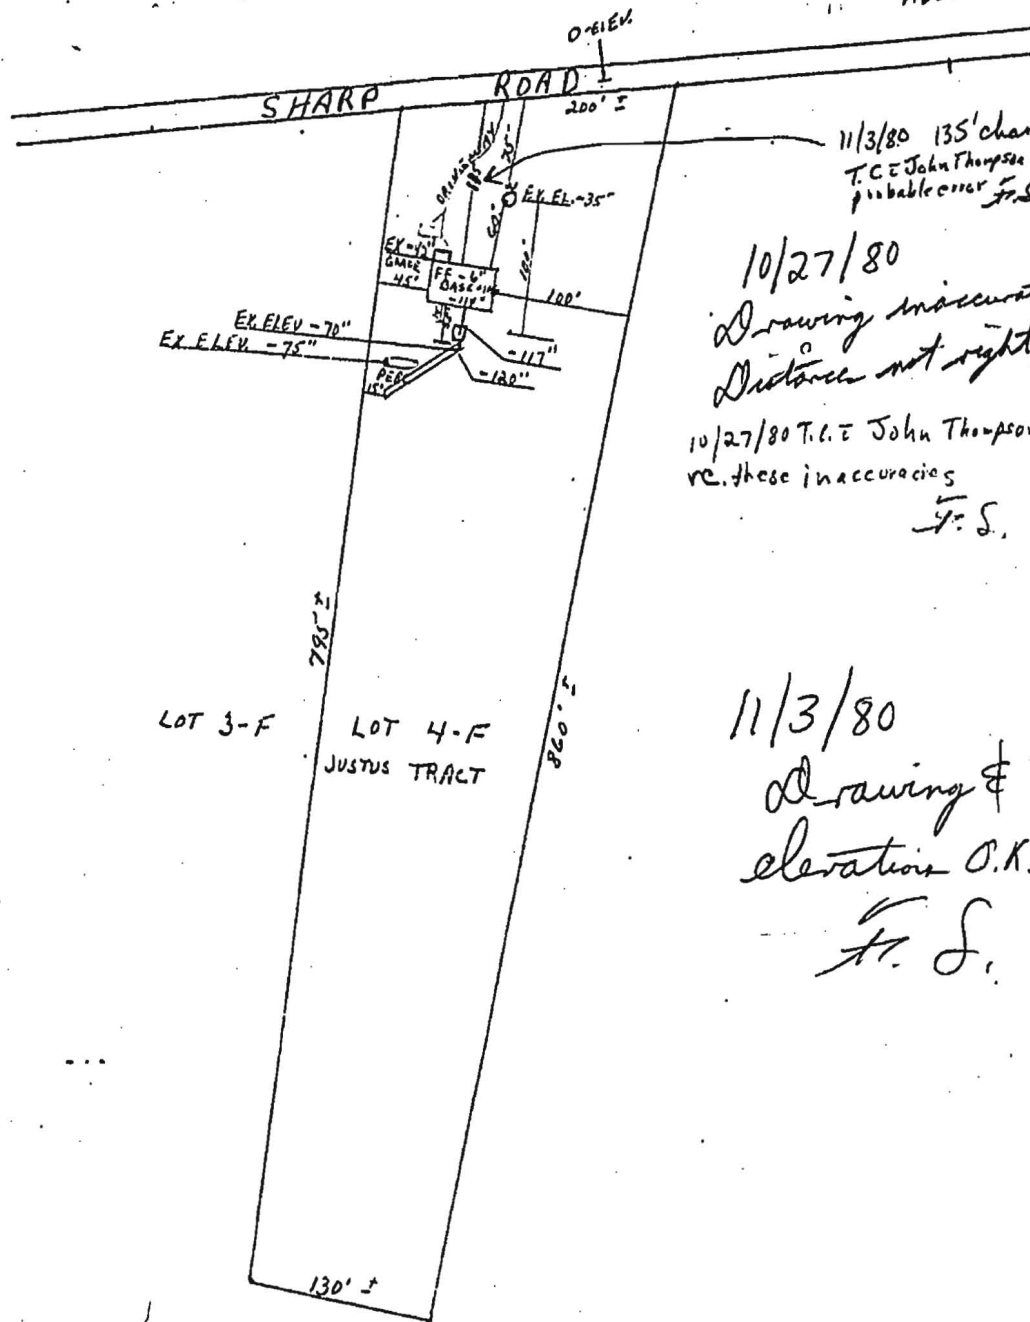

11/3/80 135' changed to 15'
T.C. & John Thompson re this
probable error F.S.

10/27/80
Drawing inaccurate
Distances not right F.S.
10/27/80 T.C. & John Thompson's partners
re these inaccuracies
F.S.

11/3/80
Drawing &
elevations O.K.
F.S.

SCALE 1" = 100'