

1/22/81
afternoon
1/23/81
as soon as possible

approved 1/23/81

5 days

PERMIT

P 31125

A 20109

SEWAGE DISPOSAL SYSTEM

MARYLAND STATE DEPARTMENT OF HEALTH

HOWARD COUNTY

ELLICOTT CITY

DISTRICT 4th

INDEXED

DATE 1/21/81

Jack Fyock

IS PERMITTED TO INSTALL ☒ ALTER

ADDRESS 13775 Triadelphia Road, Glenelg, Md. 21737 PHONE 988-9270

SUBDIVISION Glenwood Estates ROAD 3650 Sharp Road LOT 4F

PROPERTY OWNER Darrell Johnson *Darrell Johnson*

ADDRESS 8450 Old Columbia Road, Laurel, Md. 20810 Phone: 384-6373 or 498-3092

SPECIFICATIONS 3 bedrooms

SEPTIC TANK CAPACITY 1000 GALLONS

DRAIN FIELD DEPTH FEET, BOTTOM AREA SQ. FT.

DEEP TRENCH DEPTH FEET, BOTTOM AREA SQ. FT.

SEEPAGE PITS ABSORBENT SIDE-WALL AREA SQ. FT.

INLET PIPE FT. BELOW ORIGINAL GRADE. MAXIMUM DEPTH FT. BELOW ORIGINAL GRADE

EFFECTIVE DEPTH AT FT. BELOW ORIGINAL GRADE.

LOCATE DISPOSAL AREA FT. FROM LOT LINE AND FT. FROM LOT LINE AS SEEN WHEN FACING LOT FROM

TRENCH SYSTEM - To have 100 linear feet of trench or 2 - 50 ft. long trenches. Inlet to trench to be no deeper than 4 1/2 ft. below original grade. Effective depth begins at 6 ft. below original grade. Maximum depth permitted for trench is 10 1/2 ft. below original grade. Place the trench 172 ft. from the front property line and 38 ft. from the right lot line as seen when facing the property from Sharp Road. Place the trench parallel to Sharp Road running Northwest. Call for inspection of trench before gravel is installed. *1/22/81 Change back to original spec. F.S.*

PLANS APPROVED BY Frank A. Skinner DATE 4/25/75 & 1/22/81

COVER NO WORK UNTIL INSPECTED AND APPROVED.

NEITHER THE HOWARD COUNTY COUNCIL NOR THE HEALTH DEPARTMENT IS RESPONSIBLE FOR THE SUCCESSFUL OPERATION OF ANY SYSTEM.

NOTE: IF TRENCH IS USED CALL FOR INSPECTION BEFORE PLACING GRAVEL IN TRENCH.

NOTE: NO DRY WELL SHALL EXCEED 15 FOOT IN DIAMETER.

NOTE: ALL PIPE FROM HOUSE TO DISPOSAL AREA MUST BE CAST IRON.

PERMIT VOID AFTER THREE YEARS.


NOTE: INSTALL STAND PIPE ON SEPTIC TANK AND DRY WELL. STAND PIPES MUST BE 8 INCHES IN DIAMETER. CAST IRON, CONCRETE OR TERRA COTTA ACCEPTED.

*INSTALLER IS RESPONSIBLE FOR OBTAINING FINAL APPROVAL ON THIS PERMIT.

HD - 23

BUD. PERMIT SIGNED
AND RETURNED 9/6/88
Serial #20771 - prol

A 20109

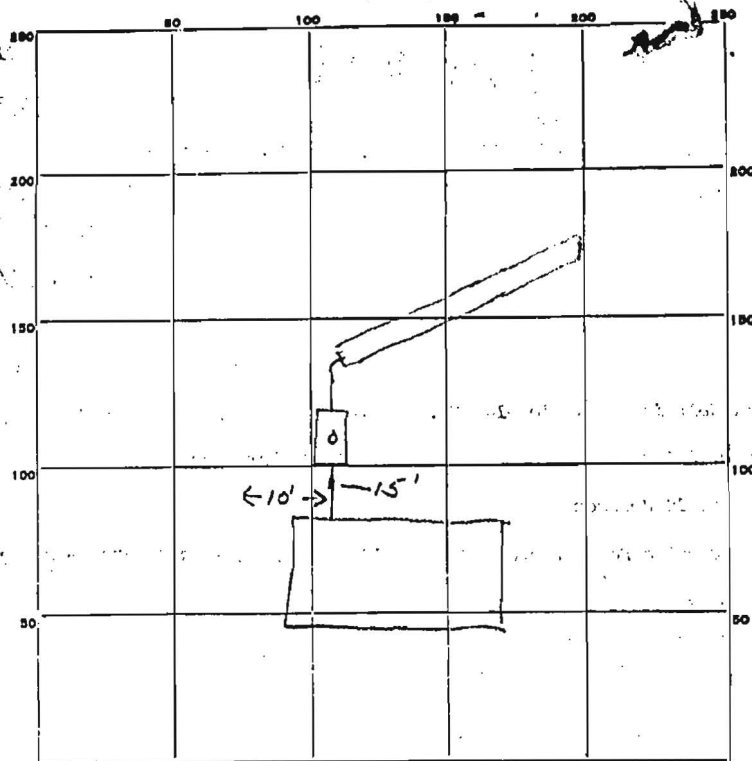

INDICATE NORTH - NAME ADJOINING ROADWAY AS BASE LINE.

PERMIT CARD ✓ Sharp Rd

SEPTIC TANK, LEVEL ✓

CLEANOUTS ST

DISTRIBUTION BOX, LEVEL ✓

TILE FIELD, DEPTH 11 1/2 FT. TRENCH WIDTH 2 FT.

GRAVEL DEPTH 8' (41.6") IN. TOTAL LENGTH 100 FT.

NUMBER OF TRENCHES 1 TOTAL BOTTOM AREA 550

SEEPAGE PITS, INSIDE DIAMETER _____ FT. DEPTH BELOW INLET _____ FT.

ABSORBENT AREA 550 SQ. FT.

REMARKS 1/22/81 OK to add gravel in trench. JB

1/23/81 OK to cover all with fl + 5K

DATE SYSTEM APPROVED 1/23/81 INSPECTOR Stevens