


C1 4658 <small>(THIS NUMBER IS TO BE PUNCHED IN COLS. 2-8 ON ALL CARDS)</small> Date Received (WRA use only) <u>9/30/80</u> DATE WELL COMPLETED <u>9/30/80</u>	SEQUENCE NO. (WRA USE ONLY) STATE OF MARYLAND WELL COMPLETION REPORT FILL IN THIS FORM COMPLETELY PLEASE PRINT OR TYPE	THIS REPORT MUST BE SUBMITTED WITHIN 30 DAYS AFTER WELL IS COMPLETED COUNTY NUMBER <u>A 20109 PERMIT NO. <u>H01-731-3672</u> FROM "PERMIT TO DRILL WELL" </u>																														
OWNER <u>Johnson Darrell</u> STREET OR RFD <u>Box 358</u> TOWN <u>Burtonsville</u> SUBDIVISION <u>Justus Tract</u> SECTION <u>E</u> LOT <u>4</u>																																
WELL LOG <small>Not required for driven wells</small> STATE THE KIND OF FORMATIONS PENETRATED, THEIR COLOR, DEPTH, THICKNESS AND IF WATER BEARING <table border="1" style="width:100%; border-collapse: collapse;"> <thead> <tr> <th rowspan="2">DESCRIPTION (Use additional sheets if needed)</th> <th colspan="2">FEET</th> <th rowspan="2">Check if water bearing</th> </tr> <tr> <th>FROM</th> <th>TO</th> </tr> </thead> <tbody> <tr> <td>Topsoil</td> <td>0</td> <td>2</td> <td></td> </tr> <tr> <td>Shaly</td> <td>2</td> <td>88</td> <td></td> </tr> <tr> <td>Brown Slate</td> <td>88</td> <td>115</td> <td>✓</td> </tr> <tr> <td>Blue Slate</td> <td>115</td> <td>127</td> <td></td> </tr> <tr> <td>Brown Slate</td> <td>127</td> <td>132</td> <td>✓</td> </tr> <tr> <td>Blue Slate</td> <td>132</td> <td>160</td> <td></td> </tr> </tbody> </table>	DESCRIPTION (Use additional sheets if needed)	FEET		Check if water bearing	FROM	TO	Topsoil	0	2		Shaly	2	88		Brown Slate	88	115	✓	Blue Slate	115	127		Brown Slate	127	132	✓	Blue Slate	132	160		GROUTING RECORD WELL HAS BEEN GROUTED <input checked="" type="checkbox"/> YES <input type="checkbox"/> NO TYPE OF GROUTING MATERIAL CEMENT <input checked="" type="checkbox"/> BENTONITE CLAY <input type="checkbox"/> NO. OF BAGS <u>32</u> NO. OF POUNDS <u>3200</u> GALLONS OF WATER <u>160</u> DEPTH OF GROUT SEAL (to nearest foot) from <u>0</u> ft. to <u>85</u> ft. (enter 0 if from surface)	C 3 PUMPING TEST HOURS PUMPED (nearest hour) <u>2</u> PUMPING RATE (gal. per min. to nearest gal.) <u>50</u> METHOD USED TO MEASURE PUMPING RATE <u>Bucket</u> WATER LEVEL - (distance from land surface) BEFORE PUMPING <u>30</u> WHEN PUMPING <u>160</u> TYPE OF PUMP USED (for test) <input checked="" type="checkbox"/> A piston <input type="checkbox"/> T turbine <input type="checkbox"/> C centrifugal <input type="checkbox"/> R rotary <input type="checkbox"/> other (describe below) <input type="checkbox"/> J jet <input type="checkbox"/> S submersible
DESCRIPTION (Use additional sheets if needed)		FEET			Check if water bearing																											
	FROM	TO																														
Topsoil	0	2																														
Shaly	2	88																														
Brown Slate	88	115	✓																													
Blue Slate	115	127																														
Brown Slate	127	132	✓																													
Blue Slate	132	160																														
CASING RECORD MAIN CASING TYPE <u>ST</u> <u>6</u> <u>103</u> Nominal diameter top/main casing (nearest inch) Total depth of main casing (nearest foot)																																
OTHER CASING (if used) diameter (nearest inch) depth (feet) from to <table border="1" style="width:100%; border-collapse: collapse;"> <tr> <td>1</td> <td>2</td> <td>3</td> <td>4</td> <td>5</td> <td>6</td> <td>7</td> <td>8</td> <td>9</td> <td>10</td> </tr> <tr> <td></td> <td></td> <td></td> <td></td> <td></td> <td></td> <td></td> <td></td> <td></td> <td></td> </tr> </table>			1	2	3	4	5	6	7	8	9	10																				
1	2	3	4	5	6	7	8	9	10																							
SCREEN RECORD screen type or openhole <input checked="" type="checkbox"/> ST <input type="checkbox"/> BR <input type="checkbox"/> HO STEEL BRASS BRONZE OPEN HOLE PLASTIC OTHER C 2 DEPTH (nearest ft.) <u>101</u> <u>160</u> SLOT SIZE <u>2</u> DIAMETER OF SCREEN (NEAREST INCH) <u>4</u> GRAVEL PACK <u>40</u> IF WELL DRILLED WAS FLOWING WELL CIRCLE BOX <input type="checkbox"/>																																
DRILLERS IDENT. NO. <u>40</u> DRILLERS SIGNATURE <u>Shane R. Lott</u> (MUST MATCH SIGNATURE ON APPLICATION) SITE SUPERVISOR (sign of driller or journeyman responsible for sitework if different from permittee) WRA USE ONLY (NOT TO BE FILLED IN BY DRILLER) T (E.R.O.S.) <input type="checkbox"/> W O <input type="checkbox"/> TELESCOPE CASING <input type="checkbox"/> LOG INDICATOR <input type="checkbox"/> OTHER DATA <input type="checkbox"/>																																

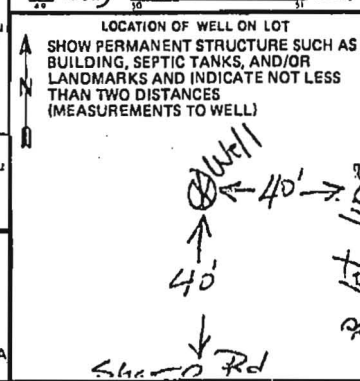

HEALTH