

APPLICATION

SEWAGE DISPOSAL TESTING

STATE OF MARYLAND - DEPARTMENT OF HEALTH AND MENTAL HYGIENE

HOWARD COUNTY HEALTH DEPARTMENT
ENVIRONMENTAL HEALTH SERVICES

P. O. BOX 478, ELLICOTT CITY, MARYLAND 21043
TELEPHONE 468-1000, EXT. 356

DISTRICT 4

DATE 6/6/74

3 B.R. 1000 gal. sept. tank 4 B.R. 1250 gal. sept. tank
Drywell and trench to have 150 sq. ft. effective sidewall absorption area per bedroom below the first 6 ft. of non-porous soil. Maximum depth permitted for drywell and trench system is 150 ft. below original grade. Place the drywell 17.2 ft. from the front property line and 38 ft. from the right lot line as seen when facing the property from Sharp Rd. Start the trench (in series with the drywell) after a 6 ft. earth buffer, and place the trench parallel to Sharp Rd. running Northwest. Call for inspection of trench before TO: THE COUNTY HEALTH OFFICER *gravel is installed.*
ELLICOTT CITY, MARYLAND DATE: Drywell or trench inlet to be no deeper than 4 1/2 ft. below original grade

I, HEREBY, APPLY FOR THE NECESSARY TEST IN ORDER TO CONSTRUCT (OR RECONSTRUCT) A SEWAGE DISPOSAL SYSTEM Example: A 3 Bedroom house would require 150 linear feet of trench -
or Trench 75 ft. long

PROPERTY OWNER Buyer - Donald N. Fiol and Wife Doris M.

8450 Old Columbia Rd., Laurel, Md. 20810 PHONE 531-6194 384-6373
Box 358, Burtonsville, Md. or 498-3092

PROPERTY LOCATION:

SUBDIVISION Glenwood Estates (Justice Tract)

LOT NO. Parcel F Lot 47
(front)

ROAD AND DESCRIPTION Macadam - Sharp Road

SIZE OF LOT Part of 12.455 acres

TYPE BLDG. 3-4 Bedrooms

NUMBER OF BEDROOMS

IF NOT SINGLE RESIDENCE DESCRIBE

THE SYSTEM INSTALLED UNDER THIS APPLICATION IS ACCEPTABLE ONLY UNTIL PUBLIC FACILITIES BECOME AVAILABLE

SIGNATURE OF APPLICANT Donald N. Fiol

BLDG. PERMIT SIGNED
AND RETURNED 11/3/80

Serial No. 44905

APPROVED BY Frank Shinn

FOR Drywell & trench

DATE 4/25/75

(KIND OF SYSTEM)

REJECTED BY

FOR

DATE


(KIND OF SYSTEM)

HOLD PENDING FURTHER TESTS

DATE

REASONS FOR REJECTION OR HOLDING

THIS IS NOT A PERMIT

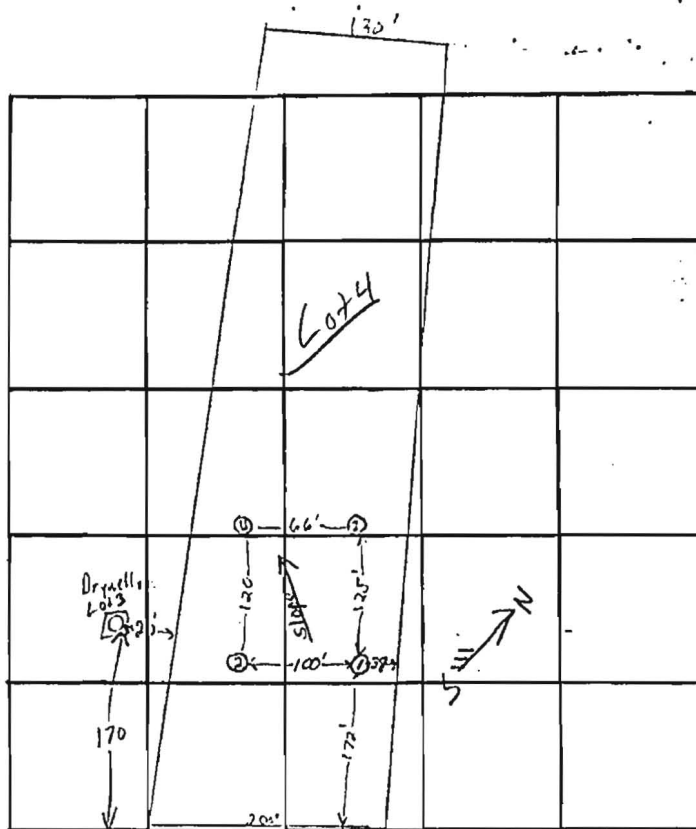

INDICATE NORTH - NAME ADJOINING ROADWAY AS BASE LINE.

Sharp Rd.

DATE	TEST NO.	DEPTH	PRE-WET START	STOP	TEST - 1" DROP START	STOP	TIME
6/7/74	1 high	4 1/2'	10:11	NO DATA			
	1A	11 1/2'	10:12	10:13	10:13	10:16	3 min
	2	11 1/2'	Visual	Can't see	Can't see	Can't see	5' 150 p/b.r.
	3	11'	Visual	Can't see	Can't see	Can't see	5'
	4 low	5'	10:29	NO DATA			
	4A	12'	10:36	10:41	10:41	10:51	10 min
	4B	7'	10:46	10:49	10:49	10:57	8 min
	1B	6'	10:48	10:50	10:50	10:55	5 min

REMARKS

TYPE OF SOIL

Sandy loam to silty loam with some gravel and stones to 5'