

ISSUE DATE: \_\_\_\_\_

P Re-Index \_\_\_\_\_

APPROVAL DATE: \_\_\_\_\_

A 520112-A \_\_\_\_\_

**PERMIT  
INDEXED****ON-SITE SEWAGE DISPOSAL SYSTEM  
HOWARD COUNTY HEALTH DEPARTMENT  
BUREAU OF ENVIRONMENTAL HEALTH**\_\_\_\_\_ IS PERMITTED TO INSTALL ☒ ALTER ☐

ADDRESS: \_\_\_\_\_ PHONE NUMBER: \_\_\_\_\_

SUBDIVISION: \_\_\_\_\_ LOT NUMBER: \_\_\_\_\_

ADDRESS: 14770 Triadelphia Mill Road PROPERTY OWNER: Jeff LoveSEPTIC TANK CAPACITY (GALLONS): 1250 OUTLET BAFFLE FILTER REQUIRED ☐PUMP CHAMBER CAPACITY (GALLONS): N/A COMPARTMENTED TANK REQUIRED ☐NUMBER OF BEDROOMS: 4

TRENCHES:	Dry Well
LOCATION:	
NOTES:	Site inspection done 3/23/04 to determine the condition of the septic system

PLANS APPROVED: \_\_\_\_\_ Reviewed by: \_\_\_\_\_ DATE: \_\_\_\_\_

## NOTES: PERMIT VOID AFTER 2 YEARS

CONTRACTOR IS RESPONSIBLE FOR SCHEDULING A PRE-CONSTRUCTION INSPECTION FOR ALL INSTALLATIONS  
WATERTIGHT SEPTIC TANKS REQUIRED  
ALL PARTS OF SEPTIC SYSTEM SHALL BE 100 FEET FROM ANY WATER WELL UNLESS SPECIFICALLY AUTHORIZED  
MANHOLE RISERS REQUIRED ON ALL SEPTIC TANKS AND PUMP CHAMBERS UNLESS SPECIFICALLY AUTHORIZED  
CONTRACTOR RESPONSIBLE FOR COMPLIANCE WITH APPLICABLE REGULATIONS, GUIDELINES AND THE TERMS OF THIS PERMIT

**NEITHER THE HOWARD COUNTY COUNCIL NOR THE HEALTH DEPARTMENT IS  
RESPONSIBLE FOR THE SUCCESSFUL OPERATION OF ANY SYSTEM  
PERMITTEE RESPONSIBLE FOR OBTAINING FINAL APPROVAL ON THIS PERMIT  
ALL 410-313-2640 FOR INSPECTION OF SEPTIC SYSTEM**

**BUILDING PERMIT SIGNED  
AND RETURNED**

3/24/2004 300146707 POLE BARN


12606 800159911 - Convert Garage + Basement to Living Space

A520112-A

# SITE INSPECTION SHEET

OWNER: Jeff Love PHONE #: \_\_\_\_\_  
 ADDRESS: 14770 Triadelphia Rd CONTRACTOR: \_\_\_\_\_  
 WELL TAG #: \_\_\_\_\_  
 SUBDIVISION: \_\_\_\_\_ LOT: \_\_\_\_\_ COUNTY #: \_\_\_\_\_  
 PROPOSAL: Pole barn - identify condition of septic

## LOCATION DIAGRAM

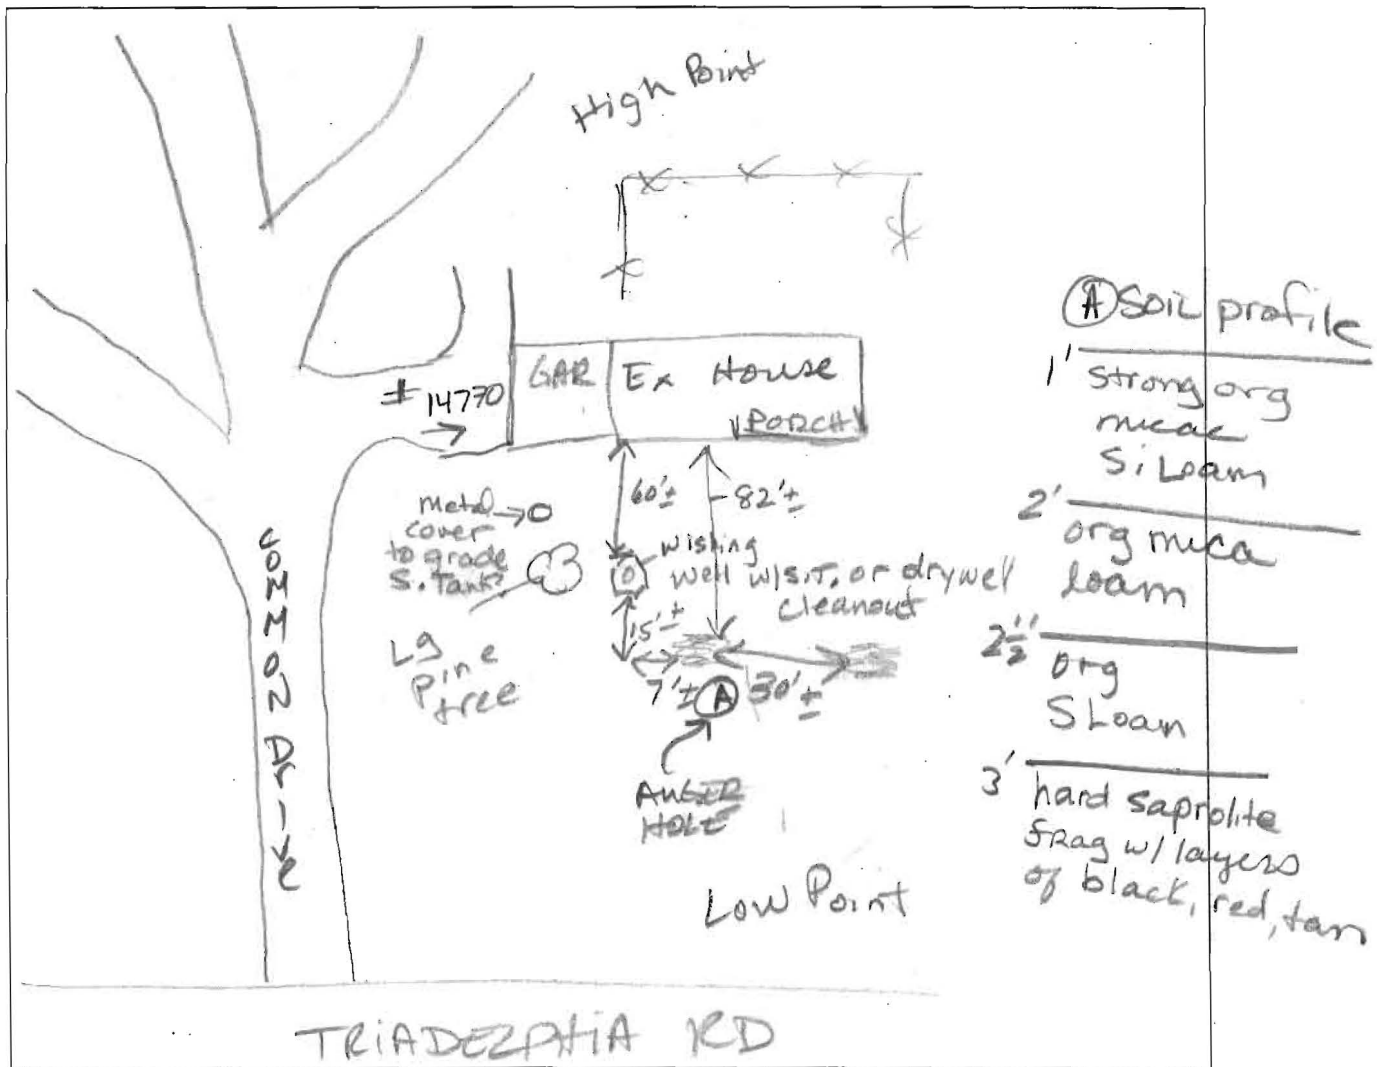

COMMENTS: 3/23/04 Septic functioning well. Removed C/O under <sup>wishing</sup> well effluent level sounds below inlet. dry wells not full. Too much rock or still functioning? Recommend perc testing if ↑ in bedrooms foil soil descript & perc times. (KN)  
 DATE: 3/23/04 INSPECTOR: Raei Roman

<p>THE LOT SHOWN HEREON APPEARS TO LIE WITHIN FLOOD ZONE "C" PER F.E.M.A. FLOOD INSURANCE RATE MAP PANEL # 240044 0025 B Effective Date: 12-04-86</p> <p>This plat is of benefit to a consumer only insofar as it is required by a lender or a title insurance company or its agent in connection with contemplated transfer, financing or re-financing.</p> <p>This plat is not to be relied upon for the establishment or location of fences, garages, buildings, or other existing or future improvements.</p> <p>This plat does not provide for the accurate identification of property boundary lines, but such identification may not be required for the transfer of title or securing financing or refinancing.</p>		<p>THIS IS TO CERTIFY THAT WE HAVE CONDUCTED A LOCATION SURVEY OF THE IMPROVEMENTS AND THAT THEY ARE LOCATED AS SHOWN HEREON.</p> <p>Signature: <i>Patricia C. Catlett</i></p> <p>Reg. No. 571 Date: 3-10-98</p>
<p><b>CLS And Associates</b> P.O. Box 190 Lisbon, MD 21765</p> <p>Office: (410) 442-5117 Fax: (410) 442-5175 Beeper: 204-3585</p>	<p>Date: 3-10-98</p> <p>Scale: 1"=100'</p> <p>File: M-956528</p>	<p>Project: <b>14770 Triadelphia Mill Road</b> Dayton Howard County, Maryland</p> <p>Title Deed: Liber: 1682, Folio: 171.</p> <p>Plat Ref: Liber: 609, Folio: 514</p>