

62573 49 47 PD

1731.2

5/24/73
5/25/73

PERMIT

SEWAGE DISPOSAL SYSTEM

MARYLAND STATE DEPARTMENT OF HEALTH

HOWARD COUNTY

INDEXED

ELLICOTT CITY

DISTRICT 5th

DATE 3/29/73

P 18199
A 16921

Robert Rubin

IS PERMITTED TO INSTALL ☒ ALTER

ADDRESS Havilland Mill Road, Brookeville, Md. PHONE 286-3432

A SEWAGE DISPOSAL SYSTEM LOCATED AT

SUBDIVISION Triadelphia Overlook 14770 ROAD Triadelphia Road LOT 2

PROPERTY OWNER Robert C. Bruffey

ADDRESS 14907 Claude Lane, Silver Spring, Md. 20904

SPECIFICATIONS 4 bedrooms

DRAIN FIELD DEPTH FEET. BOTTOM AREA SQ FT

SEEPAGE PITS ABSORBENT SIDE-WALL AREA SQ FT

SEPTIC TANK CAPACITY 1250 GALLONS

FOR GARBAGE GRINDER, INCREASE DISPOSAL AREA 22% & TANK CAPACITY 50%

OTHER DRY WELL - 400 sq. ft. of absorbent sidewall area to begin below the first 3 ft. of non-porous soil. Maximum depth permitted for dry well is 12 ft. below grade. Locate dry 35 ft. from left side line and 100 ft. from front property line as seen from Triadelphia Road.

NOTE: ALL PIPE FROM HOUSE TO SEPTIC TANK MUST BE CAST IRON.
PERMIT VOID AFTER THREE YEARS.


NOTE: INSTALL STAND PIPE ON SEPTIC TANK AND DRY WELL.

PLANS APPROVED BY Robert V. Torre DATE 8/29/72

FILL SEPTIC TANK AND DISTRIBUTION BOX WITH WATER BEFORE CALLING FOR AN INSPECTION. COVER NO WORK UNTIL INSPECTED AND APPROVED.

NEITHER THE HOWARD COUNTY COMMISSIONERS NOR THE HEALTH DEPARTMENT IS RESPONSIBLE FOR THE SUCCESSFUL OPERATION OF ANY SYSTEM

A 16921

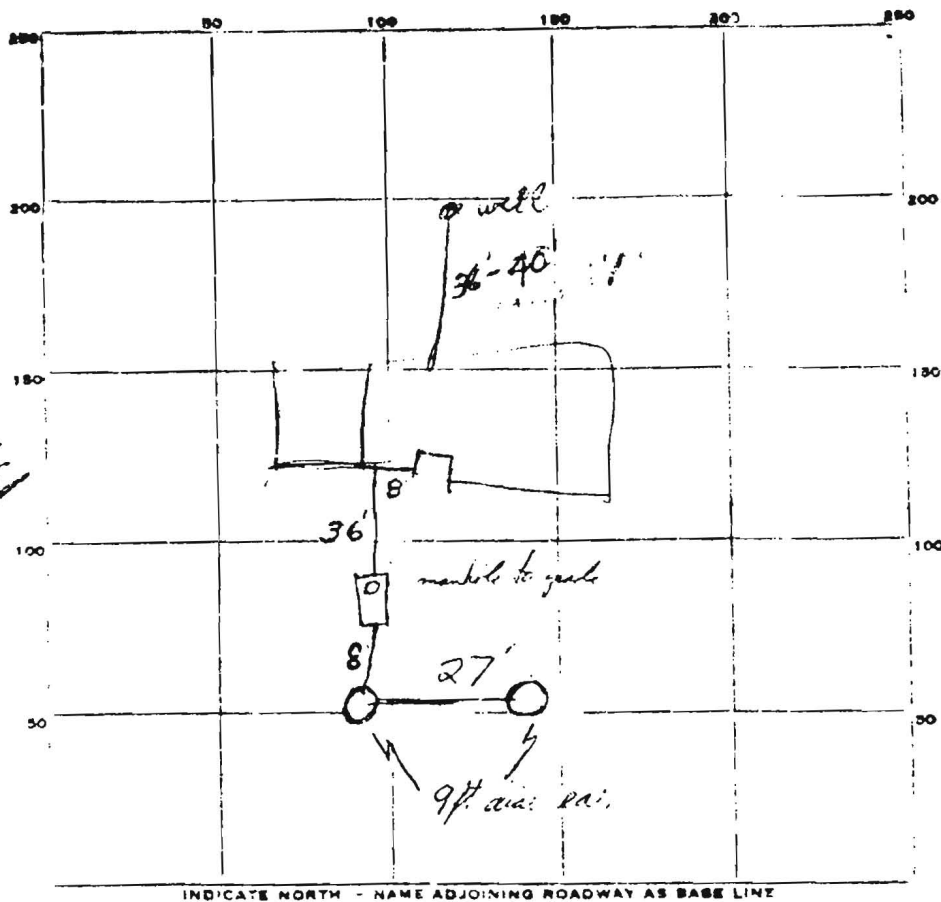

14
4 1/2
8 1/2

14
4
9 off blue
ind. 1/2
2 ft. - 1/2 in. 1/2 in. 1/2 in.

INDICATE NORTH - NAME ADJOINING ROADWAY AS BASE LINE

SMIT CARD ☒

WIC TANK, LEVEL ☒

CLEANOUTS ☒

DISTRIBUTION BOX, LEVEL N.A.

FIELD, DEPTH _____ FT. TRENCH WIDTH _____ FT.

GRAVEL DEPTH _____ IN. TOTAL LENGTH _____ FT.

NUMBER OF TRENCHES _____ TOTAL BOTTOM AREA _____

BRIDGE PITS, INSIDE DIAMETER _____ FT. DEPTH BELOW INLET _____ FT.

ABSORBENT AREA 400 + SQ. FT.

REMARKS _____

