
LOCATION DRAWING

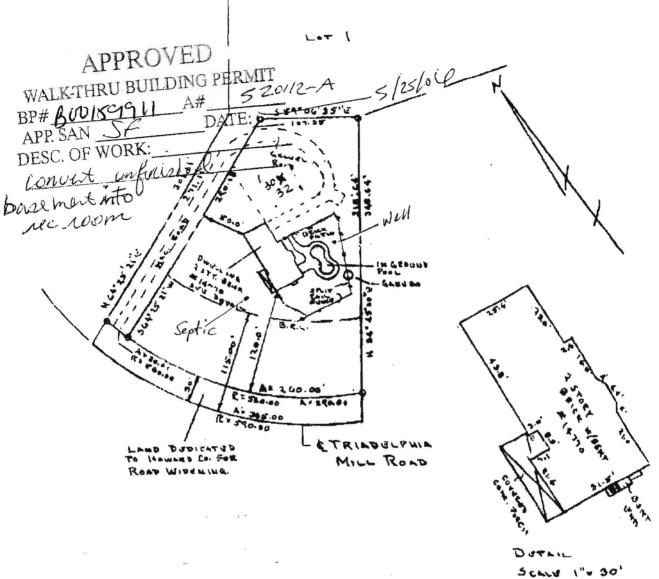

Note

Measurements to house are (+/- 1').

*Note: Being known & designated as Lot 2, Triadelphia Overlook, containing 1.2746 acres, as shown on the Plat recorded in Liber 609 at folio 514 among the Land Records of Howard County, Maryland.

THE LOT SHOWN HEREON APPEARS TO LIE WITHIN FLOOD ZONE "C" PER F.E.M.A. FLOOD INSURANCE RATE MAP PANEL # 240044 0025 B Effective Bare: 12-04-86

This plat is of benefit to a consumer only insofar as it is required by a lander or a life insurance company or its agent in connection with contemptated transfer, financing or re-financing.

This plot is not to be relian upon for the establishment of formion of fences, parages, buildings, or

silian and the at helica included about

THIS IS TO CERTIFY THAT WE HAVE CONDUCTED A LOCATION SURVEY OF THE IMPROVEMENTS AND THAT THEY ARE LOCATED AS SHOWN HEREON, Signature:

LAT 1 APPROVED Existing attached garage to be convented to foyer sexencise to form WALK-THRU BUILDING PERMIT BP#B0015991 A# 52 011 A# 520112-A APP. SAN DESC. OF WORK: convert an att

LOCATION DRAWING

& TRINDGLPHIA Howard Co. Fox MILL ROAD ROAD WIDELING.

5 caus 1" = 30'

Note

Measurements to house are (+/- 11).

*Note: Being known & designated as Lot 2, Triadelphia Overlook, containing 1.2746 acres, as shown on the Plat recorded in Liber 609 at folio 514 among the Land Records of Howard County, Maryland.

This plat is of banefit to a consumer only insofar as it is required by a lander or a title insurance

company or its agent in connection with contemptated transfer, financing or re-financing.

THIS IS TO CERTIFY THAT WE HAVE CONDUCTED A LOCATION SURVEY OF THE IMPROVEMENTS AND THAT THEY ARE LOCATED AS SHOWN HEREON.