

APPLICATION

SEWAGE DISPOSAL TESTING

MARYLAND STATE DEPARTMENT OF HEALTH

HOWARD COUNTY

ELLICOTT CITY

DISTRICT 3

Septic Tank - 3 chambers - 1000 gal

dy well - 360 sq. ft. absorption area well area to be DATE 3/23/72

below the first 3112 ft of org. 9 inch. This depth permitted for the 11 ft below

orig. grade. 50' below dy well 150' from center road (curb side Rd) and
40 ft from left side on same side facing from the front (Chall.)

TO: THE COUNTY HEALTH OFFICER
ELLICOTT CITY, MARYLAND

I, HEREBY, APPLY FOR THE NECESSARY TESTS IN ORDER TO CONSTRUCT OR RECONSTRUCT A SEW
DISPOSAL SYSTEM.

PROPERTY OWNER

Richard E. Nystrom

ADDRESS 1725 Woodstock Road, Box 31, Woodstock, Md.

PHONE

PROPERTY LOCATION:

SUBDIVISION Shady Valley

LOT NO. 4/576 now

ROAD AND DESCRIPTION Woodstock Road

Richard E. Nystrom

OCCUPANT

PHONE

PERSON TO CONSTRUCT SYSTEM

ADDRESS

PHONE

SIZE OF LOT 40,000 sq. ft.

TYPE BLOC. 3 of 4

NUMBER OF OCCUPANTS

IF NOT SINGLE RESIDENCE DESCRIBE

(Single Family Dwelling.)

SIGNATURE OF APPLICANT /s/ Perdin & Josephine (Mr. Carter)

APPROVED BY Mr. Monaghan

FOR dy well

DATE 4-5-76

REJECTED BY

FOR

(TYPE OF SYSTEM)

DATE


HOLD PENDING FURTHER TESTS

DATE

REASONS FOR REJECTION OR HOLDING

BLOC. PERMIT SIGNED
AND RETURNED 5/26/76

THIS IS NOT A DEPOSIT

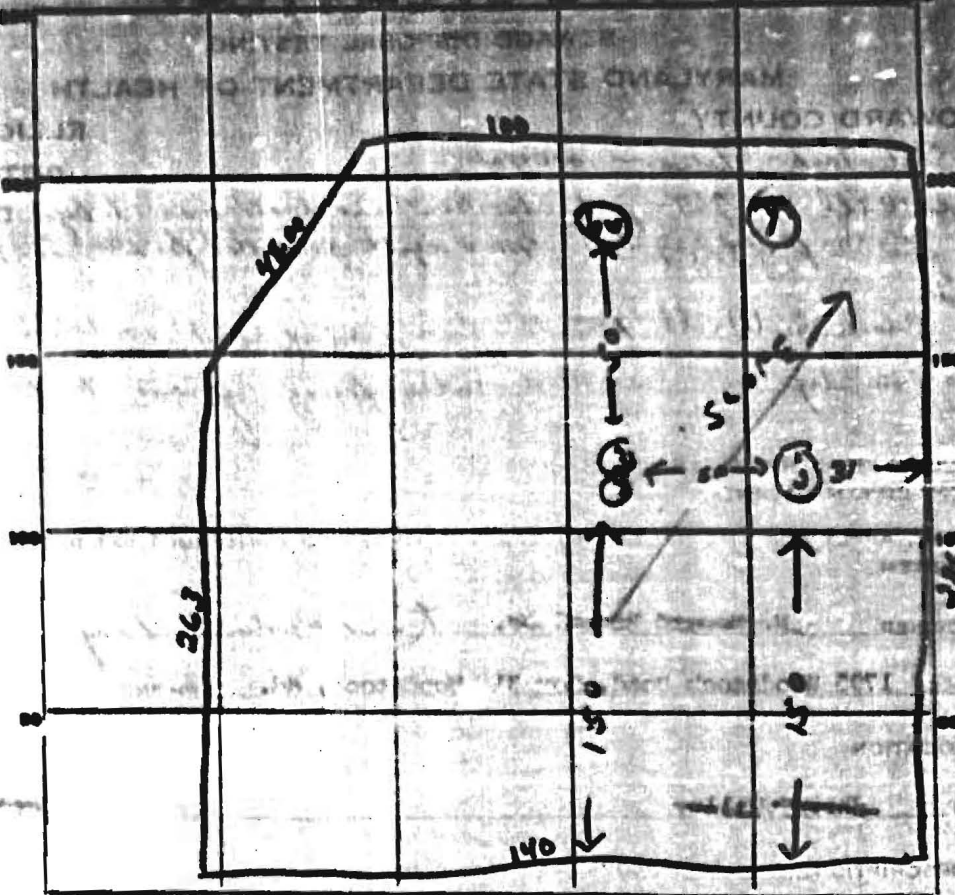

WOODSTOCK Rd.

DATE	TEST NO.	DEPTH	PRE-WET		TEST - 1" DROP		TIME
			START	STOP	START	STOP	
3/23/72	1	11 1/2 ft.	10 ¹³	10 ¹⁴	10 ¹⁴	10 ¹⁶	3 min
	2	5 ft.	10 ¹³	10 ²⁷	10 ²⁷	10 ²⁸	30 sec
	3	11 1/2 ft.	10 ¹³	10 ²⁰	10 ²⁰	10 ²⁴	4 min
	4	3 1/2 ft.	10 ¹⁸	10 ²¹	10 ²¹	10 ²⁶	5 min
	5	11 ft.	10 ²⁴	10 ²⁶	10 ²⁶	10 ²⁹	3 min
	6	3 1/2 ft.	10 ²⁵	10 ²⁷	10 ²⁷	10 ³⁰	4 min
3/24/72	7	Oung to 12 1/2 ft. - day P.T.					

14.8
7 mi
inlet 3

SOIL AUGER FINDING

TESTED BY R. Toner

REMARKS

WOODSTOCK ROAD 1789

