

7/15/76

PERMIT

SEWAGE DISPOSAL SYSTEM

MARYLAND STATE DEPARTMENT OF HEALTH

HOWARD COUNTY

ELLICOTT CITY

INDEXED

DISTRICT

DATE

7/12/76

W. J. M. Higgins IS PERMITTED TO INSTALL ALTER

ADDRESS Jennings Chapel Rd. Washington, D.C. 20002-4211

A SEWAGE DISPOSAL SYSTEM LOCATED AT _____

SUBDIVISION _____ ROAD Woodstock LOT 2

PROPERTY OWNER Richard E. Higgins

ADDRESS _____

SPECIFICATIONS See attached spec

DRAIN FIELD _____ DEPTH _____ FEET, BOTTOM AREA _____ SQ. FT.

SEEPAGE PITS _____ ABSORBENT SIDE-WALL AREA _____ SQ. FT.

SEPTIC TANK CAPACITY 1000 GALLONS

FOR GARBAGE GRINDER, INCREASE DISPOSAL AREA 25% & TANK CAPACITY 50%.

OTHER N/W 360' SIDEWALL AREA to start 3 1/2' B.S.

N/W MAX DEPTH 11'

PLACE 150' FROM ROAD & 50' from left line


PLANS APPROVED BY W. J. M.

DATE 7/5/76

FILL SEPTIC TANK AND DISTRIBUTION BOX WITH WATER BEFORE CALLING FOR AN INSPECTION. COVER NO WORK UNTIL INSPECTED AND APPROVED.

NEITHER THE HOWARD COUNTY COMMISSIONERS NOR THE HEALTH DEPARTMENT IS RESPONSIBLE FOR THE SUCCESSFUL OPERATION OF ANY SYSTEM.

Remember 5 notes.

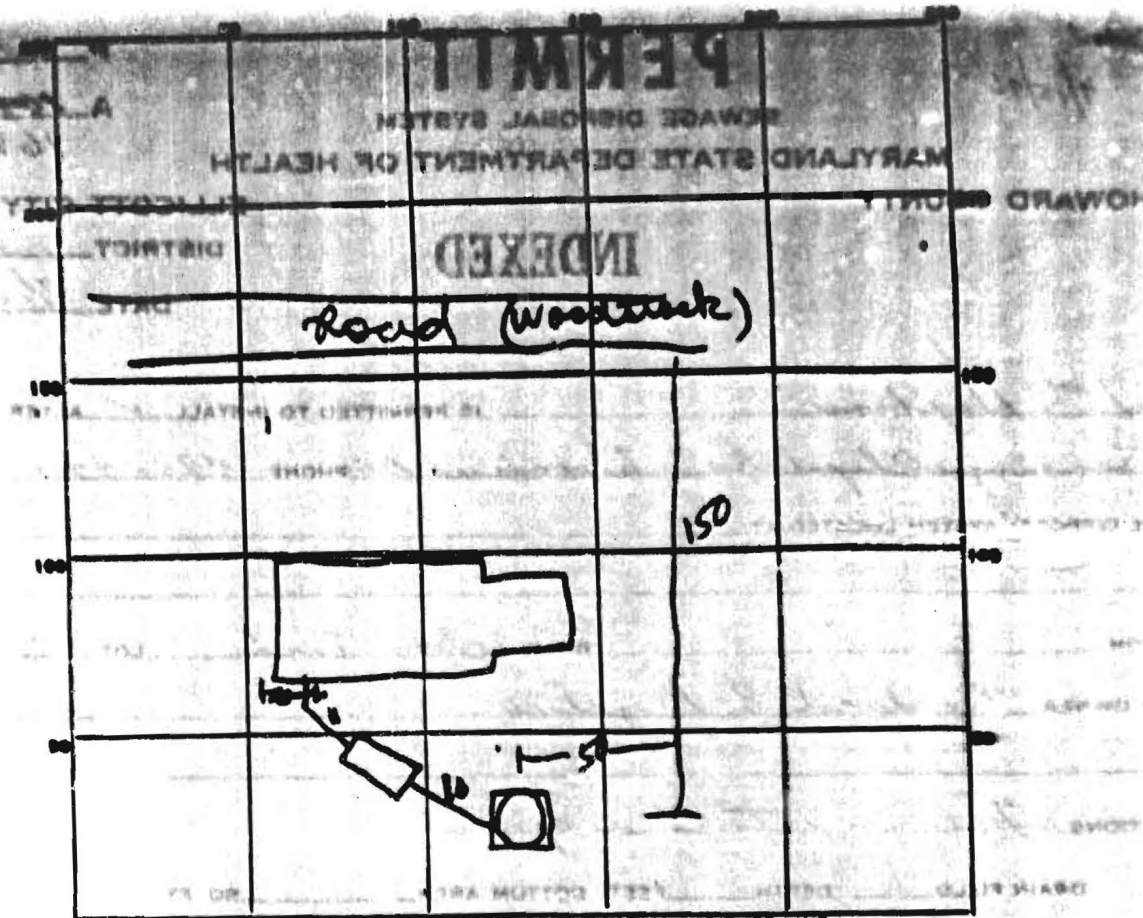

INDICATE NORTH. - NAME ADJOINING ROADWAY AS BASE LINE.

PERMIT CARD _____

SEPTIC TANK, LEVEL ✓

CLEANOUTS ✓
ST / DW

DISTRIBUTION BOX, LEVEL _____

✓ SURVEY DW

INLET, DEPTH 3 FT. TRENCH WIDTH _____ FT.

GRAVEL DEPTH _____ IN. TOTAL LENGTH _____ FT.

NUMBER OF TRENCHES _____

TOTAL BOTTOM AREA _____

OUTSIDE PERIMETER

SEEPAGE PITS, INSIDE DIAMETER 60 FT. DEPTH BELOW INLET 8 FT.

ABSORBENT AREA 480 SQ. FT.

REMARKS Ok to Backfill except for connections to septic tank
which are loose or inadequate. We recall RAB-15

Recalled connections OK Backfill RAB 15 for

DATE SYSTEM APPROVED

15 July 76

INSPECTOR

RA in