

P 514645

SEWAGE DISPOSAL SYSTEM
HOWARD COUNTY HEALTH DEPARTMENT
BUREAU OF ENVIRONMENTAL HEALTH
410-313-2640

A REPAIR

ISSUE DATE 11/14/2000

APPROVAL DATE 11/14/00

INDEXED

Jack Fyock Septic Service

IS PERMITTED TO INSTALL _____ ALTER X

ADDRESS PO Box 89, Glenelg, MD 21737

PHONE 410-988-9270

SUBDIVISION _____ LOT NUMBER 2 ADDRESS 1789 Woodstock Road

PROPERTY OWNER Tolle PROPERTY OWNER'S ADDRESS Same

SEPTIC TANK CAPACITY 1000? GALLONS

PUMP CHAMBER CAPACITY N/A GALLONS

NUMBER OF BEDROOMS 3

SQUARE FEET PER BEDROOM _____

LINEAR FEET OF TRENCH REQUIRED _____

RENCHES:	Trenches to be	feet wide.	Inlet	feet below original grade.	Bottom maximum depth
		feet below original grade.		feet of stone below distribution box.	

LOCATION:

REPAIR - PURPOSE - Existing septic system has failed.

Call for inspection when ground is opened so sanitarian can recommend repair.

11/13/2000

PLANS APPROVED _____ DATE _____

PERMIT VOID AFTER 2 YEARS

NOTE: CONTRACTOR RESPONSIBLE FOR SCHEDULING A PRE-CONSTRUCTION INSPECTION FOR ALL INSTALLATIONS

NOTE: TOP OF SEPTIC TANKS ARE TO BE NO DEEPER THAN 3.0 FEET BELOW FINISH GRADE

NOTE: WATERTIGHT SEPTIC TANKS REQUIRED

NOTE: CLEANOUT REQUIRED EVERY 70 FEET OF SEWER LINE AND/OR AT 90° SWEEPS IN LINES FROM HOUSE TO DRAIN FIELDS, 90° ELBOWS ARE NOT ACCEPTABLE

NOTE: ALL PARTS OF SEPTIC SYSTEMS (I.E. TANK, DISTRIBUTION BOX, DRAINFIELDS) TO BE 100 FEET FROM ANY WATER WELL UNLESS OTHERWISE SPECIFICALLY AUTHORIZED

NOTE: NO ABSORPTION TRENCH TO EXCEED 100 FEET IN LENGTH UNLESS SPECIFICALLY AUTHORIZED

NOTE: ALL PIPE FROM HOUSE TO SEPTIC TANK MUST BE CAST IRON OR SCHEDULE 35/40 PVC OR ABS

NOTE: MANHOLE RISERS REQUIRED ON ALL SEPTIC TANKS AND PUMP CHAMBERS

NOTE: DISTRIBUTION BOXES MUST HAVE BAFFLES

NOTE: IF PUMPED SEPTIC SYSTEM REQUIRED, (1) SEPTIC PUMP DETAIL TO BE PROVIDED BY INSTALLER PRIOR TO ISSUANCE OF SEPTIC PERMIT (2) PUMP PERFORMANCE TEST IS NECESSARY PRIOR TO HEALTH DEPARTMENT APPROVAL OF SEPTIC PERMIT

NEITHER THE HOWARD COUNTY COUNCIL NOR THE HEALTH DEPARTMENT IS RESPONSIBLE FOR THE
SUCCESSFUL OPERATION OF ANY SYSTEM
PERMITTEE RESPONSIBLE FOR OBTAINING FINAL APPROVAL ON THIS PERMIT
CALL 410-313-2640 FOR INSPECTION OF SEPTIC SYSTEM

514645


Red Br C/L Loam
 Light Brown
 Si Sa Loam
 Sandstone

20'-2.5'

13.5'

NOT TO SCALE

INDEXED

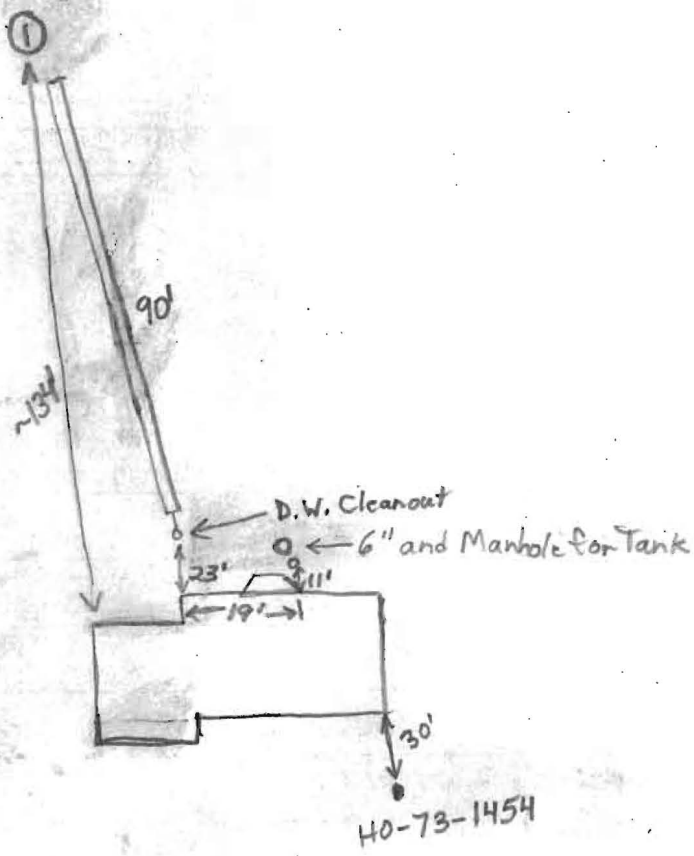

TRENCH DATA

TRENCH WIDTH 2.0'
 TRENCH INLET DEPTH 2.5'
 TRENCH BOTTOM DEPTH 8.5'
 DEPTH OF STONE 6.0'
 NUMBER OF TRENCHES 1
 TOTAL TRENCH LENGTH 90'
 ABSORBENT AREA 540 sq. ft.
 DISTRIBUTION BOX LEVEL N/A
 BAFFLE IN DISTRIBUTION BOX N/A

SEPTIC TANK DATA

SEPTIC TANK 1000? GALLONS
 MANHOLE RISER Yes
 6 INCH INSPECTION PORT Yes

~~PUMP CHAMBER DATA~~ N/A

~~PUMP CHAMBER GALLONS _____~~
~~MANHOLE RISER _____~~
~~ALARM _____~~
~~PUMP PERFORMANCE TEST _____~~

Woodstock Road
 PRE-CONSTRUCTION INSPECTION: 11/14/00 1-90' Trench, Inlet 2.5', Depth 8.5',
6.0' of stone. O.K. to Cover. (BB)

INSPECTION COMMENTS: _____

INSPECTOR B. Baker DATE SYSTEM APPROVED 11/14/00