

LAYOUT _____ INSP 4 _____

INSP 2 _____ INSP 5 _____

INSP 3 _____ INSP 6 _____

ISSUE DATE: 3/22/78

P 27703

APPROVAL DATE: 5/22/78

A 5 20342

PERMIT

INDEXED

TAX ID #03-288668

**ON-SITE SEWAGE DISPOSAL SYSTEM
HOWARD COUNTY HEALTH DEPARTMENT
BUREAU OF ENVIRONMENTAL HEALTH**

_____ IS PERMITTED TO INSTALL ☒ ALTER ☐

ADDRESS: _____ PHONE NUMBER: _____

SUBDIVISION: _____ LOT NUMBER: _____

ADDRESS: 11890 Triadelphia Road PROPERTY OWNER: Dominic Palacorolla

SEPTIC TANK CAPACITY (GALLONS): _____ OUTLET BAFFLE FILTER REQUIRED ☐

PUMP CHAMBER CAPACITY (GALLONS): _____ COMPARTMENTED TANK REQUIRED ☐

NUMBER OF BEDROOMS: _____

SQUARE FEET PER BEDROOM: _____

LINEAR FEET OF TRENCH REQUIRED: _____

TRENCHES:	Trench to be _____ feet wide. Inlet _____ feet below original grade. Bottom maximum depth _____ feet below original grade. Effective area begins at _____ feet below original grade. _____ feet of stone below distribution pipe.
LOCATION:	
NOTES:	

PLANS APPROVED: _____ DATE: _____

NOTE: PERMIT VOID AFTER 2 YEARS

NOTE: CONTRACTOR RESPONSIBLE FOR SCHEDULING A PRE-CONSTRUCTION INSPECTION FOR ALL INSTALLATIONS


NOTE: WATERTIGHT SEPTIC TANKS REQUIRED

NOTE: ALL PARTS OF SEPTIC SYSTEM SHALL BE 100 FEET FROM ANY WATER WELL

NOTE: MANHOLE RISERS REQUIRED ON ALL SEPTIC TANKS AND PUMP CHAMBERS UNLESS SPECIFICALLY AUTHORIZED

**NEITHER THE HOWARD COUNTY COUNCIL NOR THE HEALTH DEPARTMENT IS
RESPONSIBLE FOR THE SUCCESSFUL OPERATION OF ANY SYSTEM
PERMITTEE RESPONSIBLE FOR OBTAINING FINAL APPROVAL ON THIS PERMIT
CALL 410-313-2640 FOR INSPECTION OF SEPTIC SYSTEM**

A520342

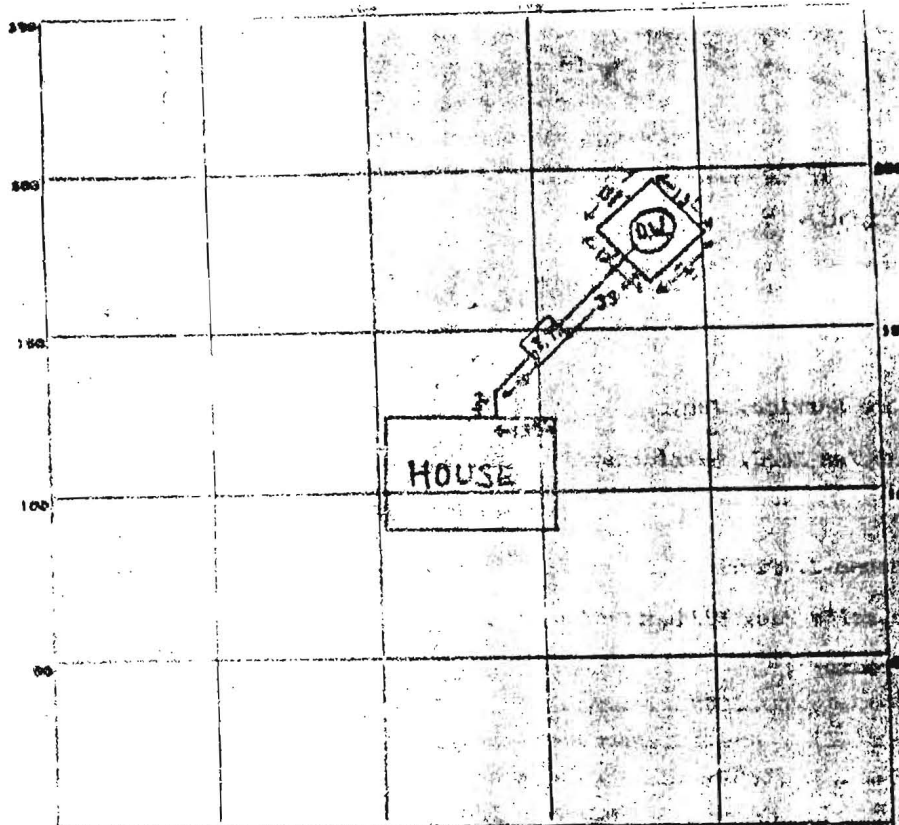

INDICATE NORTH BY LINE TO TOP OF ROADWAY AS BASE LINE.

PERMIT CARD ✓ signed for L.O.R. & S.

S.T. | D.W.

SEPTIC TANK LEVEL ✓

CLEAROUTS ✓ | ✓

DISTRIBUTION BOX, LEVEL n.a.

TILE FIELD, DEPTH _____ FT. TRENCH WIDTH _____ FT.

GRAVEL DEPTH _____ IN. TOTAL LENGTH _____ FT.

NUMBER OF TRENCHES _____ TOTAL BOTTOM AREA _____

SEEPAGE PITS, INSIDE DIAMETER 52.5 FT. DEPTH BELOW INLET 7 1/2 FT.

ABSORBENT AREA +377.5 SQ. FT.

REMARKS: 5/19/78 O.K. to install trench F.S.

DATE SYSTEM APPROVED 5/22/78

INSPECTOR

F. Skinner

A hand-drawn map on a grid. The grid has horizontal lines labeled 50, 100, 150, 200, and 250. The vertical lines are labeled 80, 100, 120, 140, 160, 180, and 200. A rectangular area labeled "HOUSE" is located between horizontal lines 100 and 120, and vertical lines 120 and 140. A path is drawn from the "HOUSE" to a circular area labeled "DW". The path consists of three segments: a horizontal segment of 13 units, a diagonal segment of 33 units, and a final diagonal segment of 42 units. The "DW" is located at the end of the path, between horizontal lines 200 and 220, and vertical lines 160 and 180. The path is marked with arrows and numbers indicating distance.

VIADelta Road

SEPTIC TANK, LEVEL ✓ ✓ CLEANOUTS ✓ ✓

DISTRIBUTION BOX, LEVEL n.a. :

TILE FIELD, DEPTH _____ FT. TRENCH WIDTH _____ FT.

GRAVEL DEPTH _____ IN. TOTAL LENGTH _____ FT.

NUMBER OF TRENCHES _____ TOTAL BOTTOM AREA _____

SEEPAGE PITS, INSIDE DIAMETER 52.5 FT. DEPTH BELOW INLET 7 1/2 FT.

ABSORBENT AREA ±377.5 SQ. FT.

REMARKS 5/19/78. O.K. to cover all work. F.S.

DATE SYSTEM APPROVED 5/22/78 INSPECTOR F. Skinner