

5/5/04 - 10 AM 5/11/04

PUB. SEWER STATUS VERIFIED BY mlb per engineering

ISSUE DATE: 4/22/2004

APPROVAL DATE: 5/11/04

# PERMIT

01179179 INDEXED

P 520315  
P ~~520134~~

A REPAIR

## ON-SITE SEWAGE DISPOSAL SYSTEM HOWARD COUNTY HEALTH DEPARTMENT BUREAU OF ENVIRONMENTAL HEALTH

Fyock Septic Service IS PERMITTED TO INSTALL ☐ ALTER ☒

ADDRESS: PO Box 89, Glenelg PHONE NUMBER: 410-988-9270

SUBDIVISION: \_\_\_\_\_ LOT NUMBER: \_\_\_\_\_

ADDRESS: 4920 Wharff Lane PROPERTY OWNER: Arthur Ashe

SEPTIC TANK CAPACITY (GALLONS): Ex 1250 ?

PUMP CHAMBER CAPACITY (GALLONS): N/A

NUMBER OF BEDROOMS: 3

SQUARE FEET PER BEDROOM: 180

LINEAR FEET OF TRENCH REQUIRED: 90

TRENCHES:	Trench to be <u>2</u> feet wide. Inlet <u>2.5-3'</u> feet below original grade. Bottom maximum depth <u>6-6.5'</u> feet below original grade. Effective area begins at <u>2.5'</u> feet below original grade. <u>4.5'</u> feet of stone below distribution pipe.
LOCATION:	<u>On best contour starting next to house</u>
PURPOSE:	Existing septic system has failed. Call for inspection when ground is opened so sanitarian can recommend repair.


PLANS APPROVED: [Signature] DATE: 5/5/04

- NOTE: PERMIT VOID AFTER 2 YEARS
- NOTE: CONTRACTOR RESPONSIBLE FOR SCHEDULING A PRE-CONSTRUCTION INSPECTION FOR ALL INSTALLATIONS
- NOTE: WATERTIGHT SEPTIC TANKS REQUIRED
- NOTE: ALL PARTS OF SEPTIC SYSTEM SHALL BE 100 FEET FROM ANY WATER WELL
- NOTE: MANHOLE RISERS REQUIRED ON ALL SEPTIC TANKS AND PUMP CHAMBERS

NEITHER THE HOWARD COUNTY COUNCIL OR THE HEALTH DEPARTMENT IS  
RESPONSIBLE FOR THE SUCCESSFUL OPERATION OF ANY SYSTEM  
PERMITTEE RESPONSIBLE FOR OBTAINING FINAL APPROVAL ON THIS PERMIT  
CALL 410-313-2640 FOR INSPECTION OF SEPTIC SYSTEM

P 520315

NOT TO SCALE

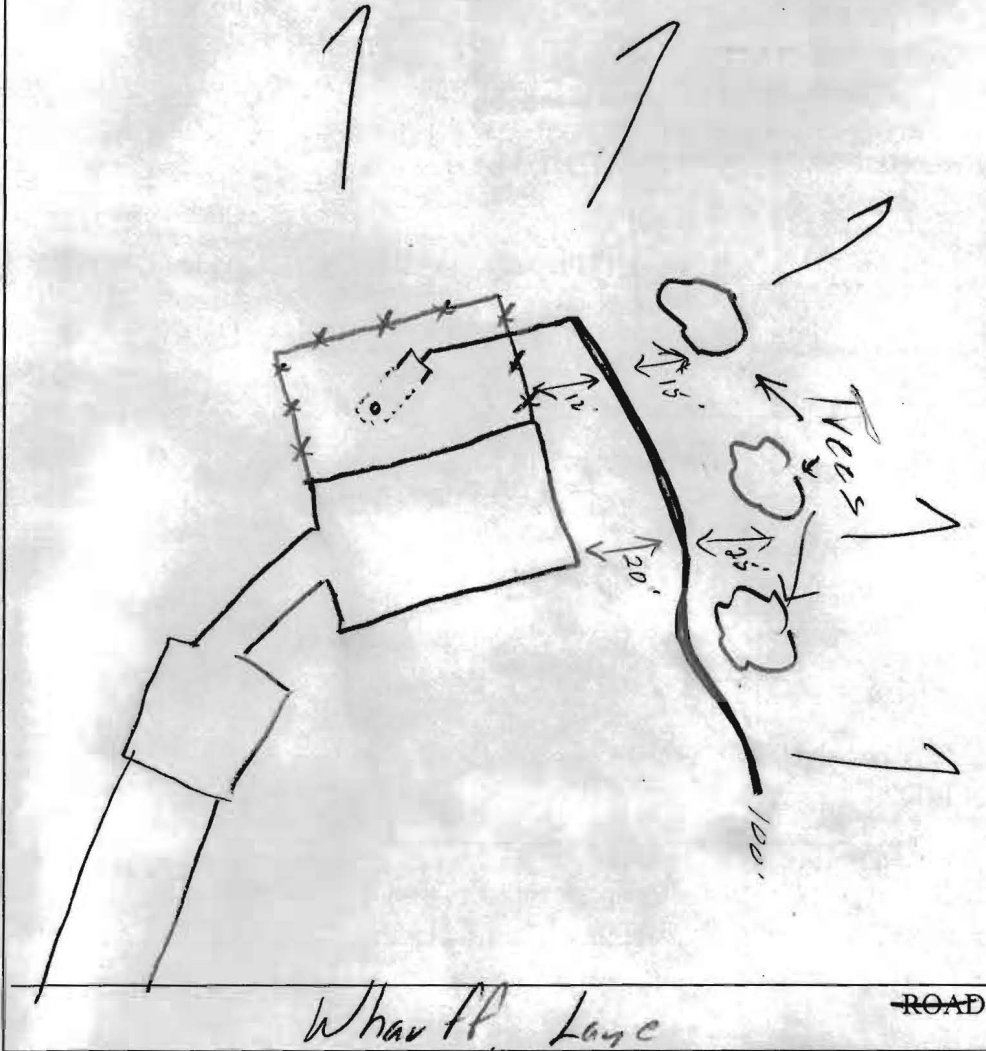

TRENCH/DRAINFIELD DATA		
WIDTH	INLET	BOTTOM
2'	3'	8'
NUMBER OF TRENCHES		
1		
TOTAL LENGTH		
100'		
ABSORPTION AREA		
500#		
DISTRIBUTION BOX LEVEL		
✓		
DISTRIBUTION BOX BAFFLE		
—		
DISTRIBUTION BOX PORT		
—		

SEPTIC TANK DATA	
SEPTIC TANK 1 LEVEL	✓
CAPACITY	EX 1250 GAL
SEAM LOC	M.d
TANK LID DEPTH	1.5'
BAFFLES	✓
BAFFLE FILTER	—
MANHOLE LOC	—
6" PORT LOC	Front
WATERTIGHT TEST	—
SEPTIC TANK 2 LEVEL	—
CAPACITY	— GAL
SEAM LOC	—
TANK LID DEPTH	—
BAFFLES	—
BAFFLE FILTER	—
MANHOLE LOC	—
6" PORT LOC	—
WATERTIGHT TEST	—

PRE-CONSTRUCTION 5/5/04 - See perc sheet

INSTALLATION 5/11/04 - Terra cotta back baffle still good.  
OK to cover all work (sc)

FINAL INSPECTOR [Signature] DATE OF APPROVAL 5/11/04