


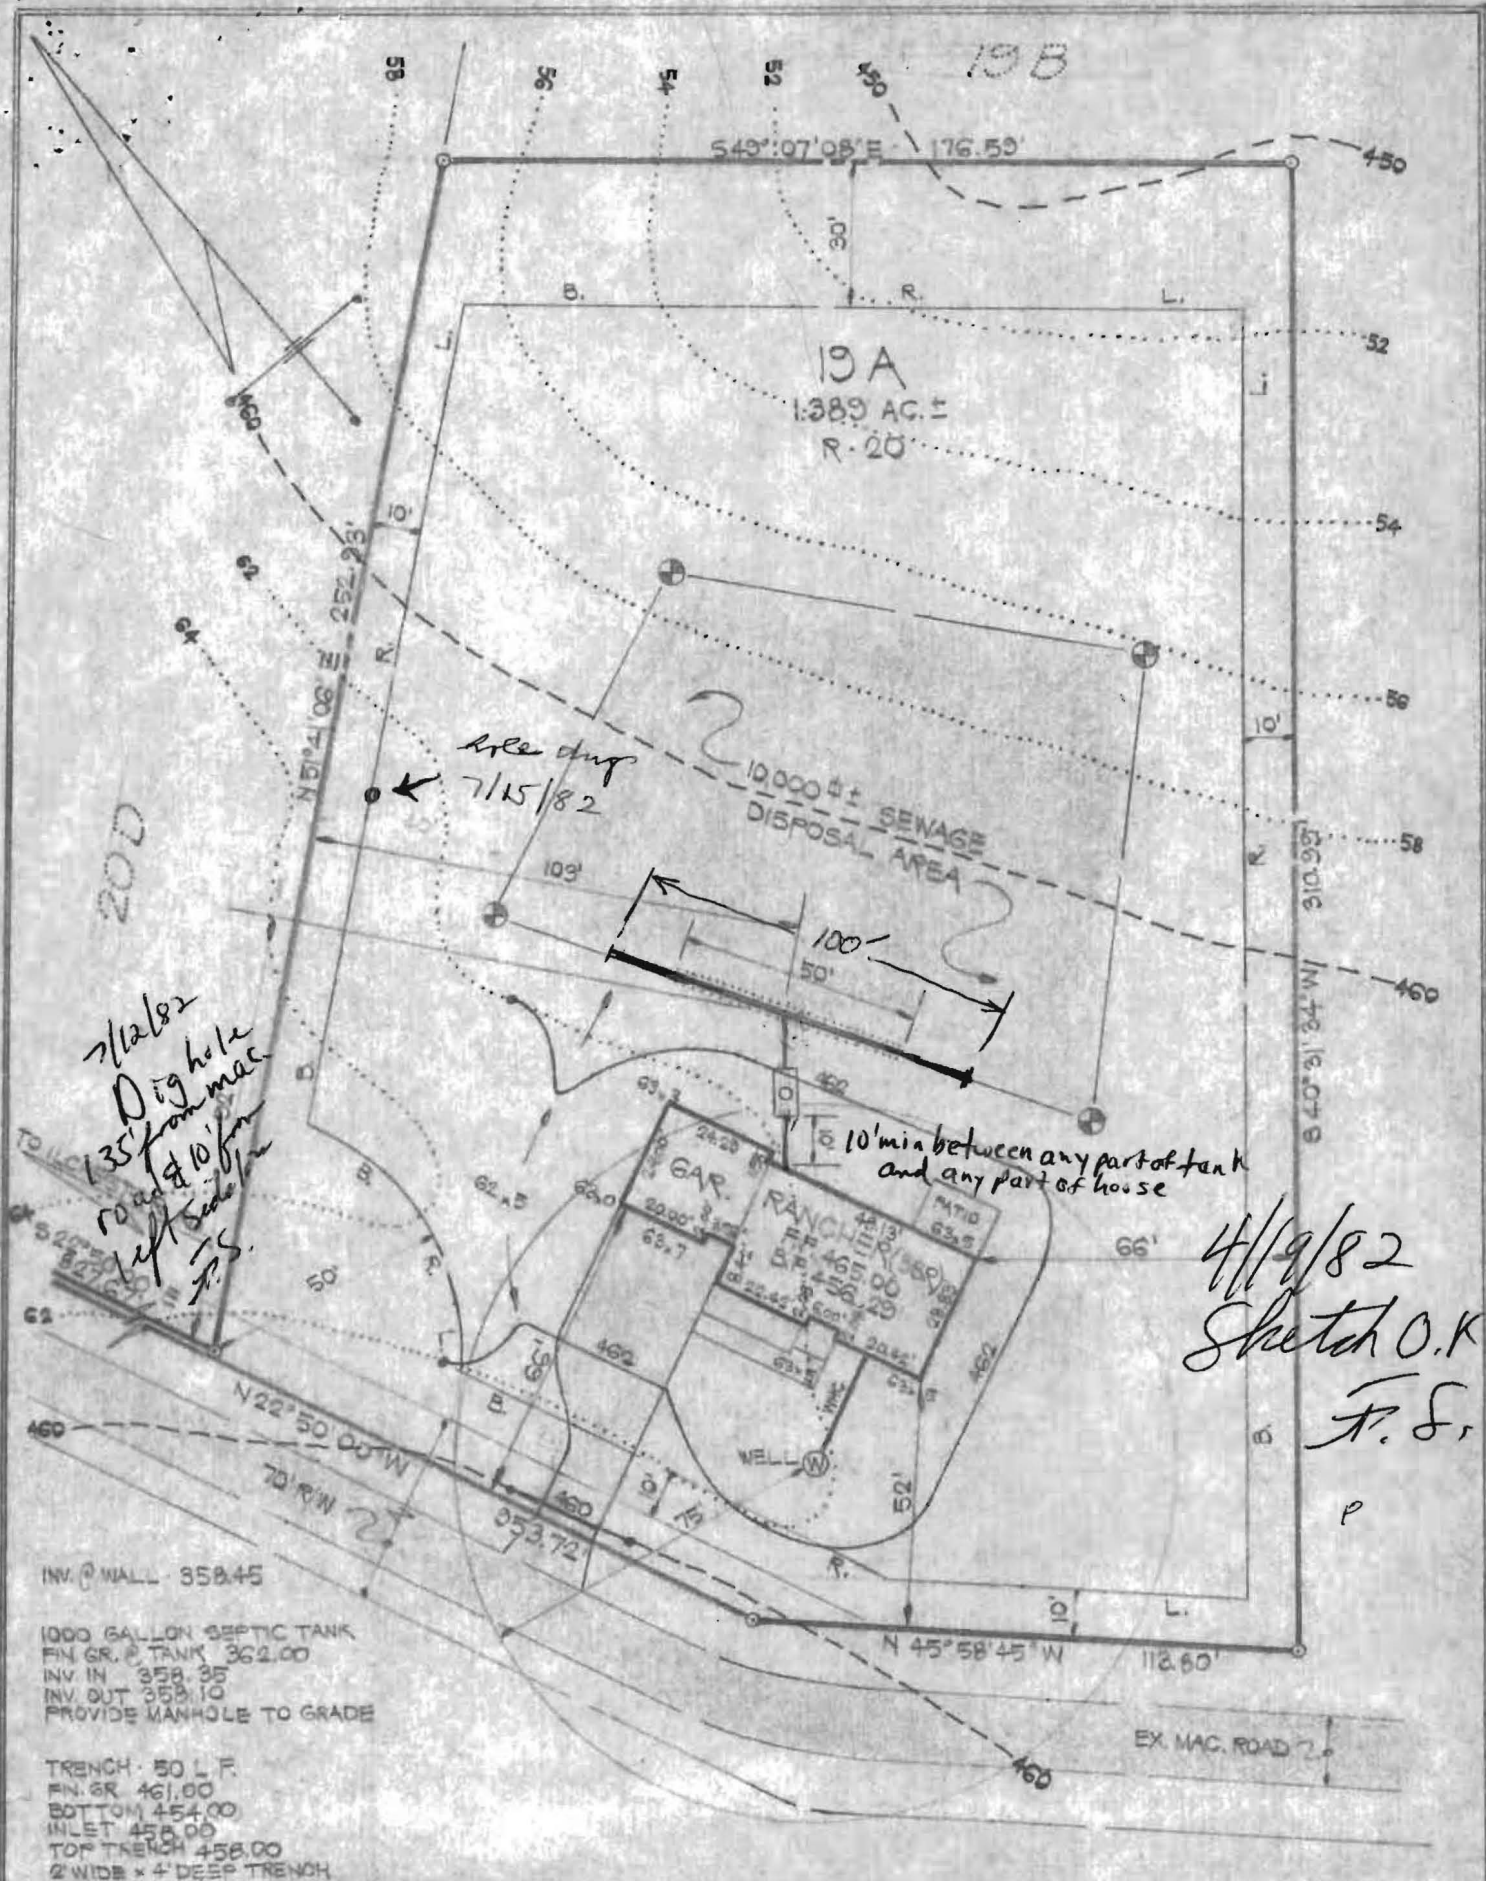


I CERTIFY THE ABOVE MEASUREMENTS AND ELEVATIONS ARE ACTUAL AND CORRECT FOR THIS PROPERTY.

3-2-82 John C. Mellema L. Reg. No. 107



SITE PLAN
TALBOT'S LAST SHIFT LOT 19A
1ST ELECTION DISTRICT HOWARD CO., MD.
JOHN C. MELLEMA SR. INC.
LAND SURVEYORS
3704 MACTAVISH AVENUE - BALTIMORE, MARYLAND
21229

SCALE
1" = 40'
DATE
3/2/82
JOB NO.
#8251

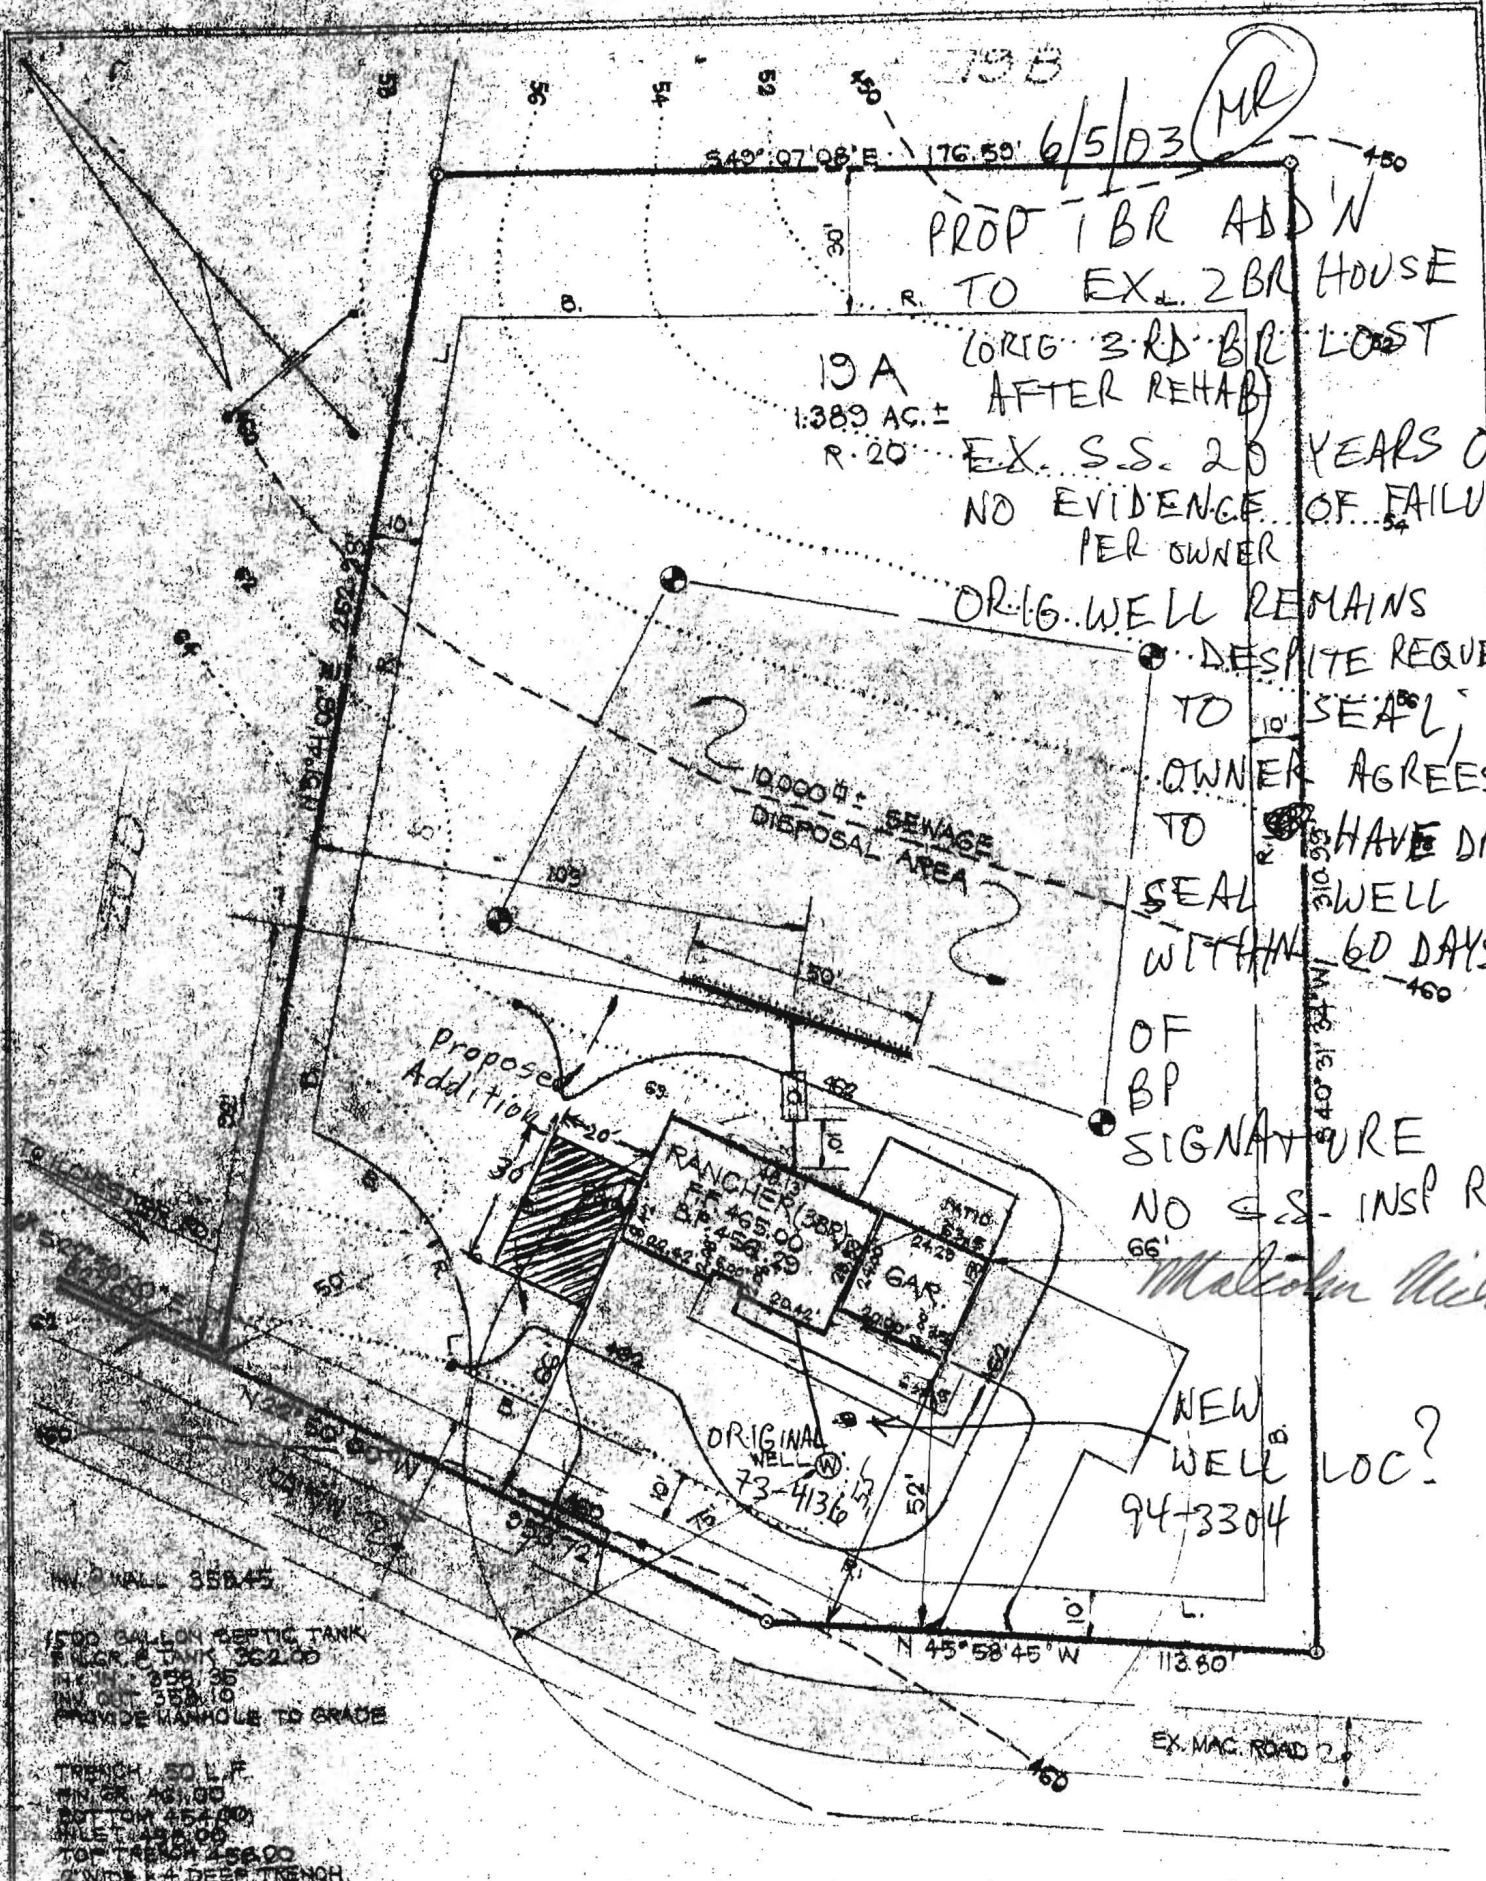

NW CORNER 355.45
 1500 GALLON SEPTIC TANK
 IN COR. 2 TANK 362.00
 IN COR. 2 TANK 362.00
 IN COR. 2 TANK 362.00
 IN COR. 2 TANK 362.00
 PROVIDE MANHOLE TO GRADE
 TRENCH 50 L.F.
 IN COR. 2 TANK 362.00
 BOTTOM 454.00
 INLET 454.00
 TOP TRENCH 456.00
 2' WIDE x 4' DEEP TRENCH

I CERTIFY THE ABOVE MEASUREMENTS AND ELEVATIONS ARE ACTUAL AND CORRECT FOR THIS PROPERTY.

NOTE: FIRST FLOOR SERVICE IS PROVIDED. SEWAGE PUMP REQUIRED FOR BASEMENT SERVICE.

3-2-82 John C. Mellema L. Reg. No. 107



SITE PLAN
 TALBOT'S LAST SHIFT LOT 19A
 12 ELECTION DISTRICT HOWARD CO, MD.
 JOHN C. MELLEMA SR. INC.
 LAND SURVEYORS
 3704 MACTAVISH AVENUE - BALTIMORE, MARYLAND
 21229

SCALE
 1" = 40'
 DATE
 3/2/82
 JOB NO.
 *8251

HOWARD COUNTY
PERMIT APPLICATION

PERMIT NUMBER

B00142273

Building Address 5117 Talbots Landing
Ellicott City Md. 21043
Suite/Apt. #: _____ SDP/WP/Petition #: _____
Census Tract 60101 Subdivision Talbots Last Shift
Section _____ Area _____ Lot 19A
Tax Map 31 Parcel 732 Grid 16
Zoning R20 Map Coordinates 10R3 Lot size 1.37 ac.

Property Owner's Name Malcolm Nichols
Address 5117 Talbots Landing
City Ellicott City State Md Zip Code 21043
Home Phone 410-758-4415 Work Phone _____
Applicant's Name & Mailing Address, (if other than stated hereon):

Existing Use single family dwelling
Proposed Use _____
Estimated Construction Cost \$ 40,000.00
Description of Work Bedroom + Bath
over crawl space, wood framed
brick veneered

Contractor Company M.T. Nichols & Co.
Contact Person Malcolm Nichols
Address 5117 Talbots Landing
City Ellicott City State Md Zip Code 21043
License No. 10393
Phone 410-758-4415 Fax _____

Occupant or Tenant Malcolm Nichols + Family
Contact Name _____
Address 5117 Talbots Landing
City Ellicott City State Md Zip Code 21043
Phone 410-758-4415 Fax _____

Engineer or Architect Company _____
Contact Person _____
Address _____
City _____ State _____ Zip Code _____
Phone _____ Fax _____

BUILDING DESCRIPTION - COMMERCIAL

BUILDING DESCRIPTION - RESIDENTIAL

Building Characteristics		Utilities	
Height:		Water Supply:	
No. of stories:	<u>1</u>	☐ Public	
Gross area, sq. ft. per floor:	<u>588 sq ft</u>	☒ Private	
Use group:		Sewage Disposal:	
Construction type:		☐ Public	
☐ Reinforced Concrete		☒ Private	
☐ Structural Steel		Electric Yes ☐ No ☐	
☐ Masonry		Gas Yes ☐ No ☒	
☒ Wood Frame		Heating System:	
☐ State Certified Modular		Electric ☐ Oil ☐	
		Natural Gas ☐	
		Propane Gas ☐	
		Sprinkler system: N/A ☐	
		☐ Full	
		☐ Partial	
		Other Suppression	
		# of Heads	

Building Characteristics		Utilities	
SF Dwelling ☐ SF Townhouse ☐		Water Supply:	
Depth	Width	☐ Public	
1st floor: <u>30'</u>	<u>20'</u>	☒ Private	
2nd floor:		Sewage Disposal:	
Basement:		☐ Public	
Finished Basement ☐ Unfinished Basement ☐		☒ Private	
Crawl space ☒ Slab on Grade ☐		Electric Yes ☐ No ☒	
No. of Bedrooms		Gas Yes ☐ No ☐	
Multi-family dwellings:		Heating System:	
No. of efficiency units:		Electric ☒ Oil ☐	
No. of 1 BR units:		Natural Gas ☐	
No. of 2 BR units:		Propane Gas ☐	
No. of 3 BR units:		Sprinkler system: N/A ☐	
Other Structure:		NFPA #13D	
Dimensions:		NFPA #13R	
Footings:		Other:	
Roof:			
State Certified Modular			
Manufactured Home			

THE UNDERSIGNED HEREBY CERTIFIES AND AGREES AS FOLLOWS: (1) THAT HE/SHE IS AUTHORIZED TO MAKE THIS APPLICATION; (2) THAT THE INFORMATION IS CORRECT; (3) THAT HE/SHE WILL COMPLY WITH ALL REGULATIONS OF HOWARD COUNTY WHICH ARE APPLICABLE HERETO; (4) THAT HE/SHE WILL PERFORM NO WORK ON THE ABOVE REFERENCED PROPERTY NOT SPECIFICALLY DESCRIBED IN THIS APPLICATION; (5) THAT HE/SHE GRANTS COUNTY OFFICIALS THE RIGHT TO ENTER ONTO THIS PROPERTY FOR THE PURPOSE OF INSPECTING THE WORK PERMITTED AND POSTING NOTICES.

Malcolm Nichols
Applicant's Signature

Malcolm Nichols
Print Name

Title/Company

Date

Checks payable to: **DIRECTOR OF FINANCE OF HOWARD COUNTY**
** PLEASE WRITE NEATLY AND LEGIBLY. **
- FOR OFFICE USE ONLY -

AGENCY	DATE	SIGNATURE APPROVAL
Land Development, DPZ		
State Highways		
Building Official		
Dev. Engineering, DPZ		
Health	<u>6/5/03</u>	<u>Mark Riffe</u>
Fire Protection		

Is Sediment Control approval required prior to issuance?
YES ☐ NO ☐

CONTINGENCY CONSTRUCTION START: ☐
ONE STOP SHOP: ☐

DPZ SETBACK INFORMATION
Front: 50
Rear: 30
Side: 10
Side St.: N/A
All minimum setbacks met? YES ☒ NO ☐
Is Entrance Permit required? YES ☐ NO ☒
Historic District? YES ☐ NO ☒
Lot Coverage for NewTown Zone N/A
SDP/Red-line approval date N/A

PROPERTY ID#: 58520
Filing fee \$ 25
Permit fee \$ 108
Excise tax \$ 453
Add'l per. fee \$ _____
TOTAL FEES \$ 613
Sub-total paid \$ _____
Balance due \$ _____
Check # 32802
Validation # 27302

Accepted by [Signature]

Distribution of Copies-

White: Building Official

Green: LDD, DPZ

Yellow: DED, DPZ

Pink: Health

Gold: SHA