

APPLICATION

SEWAGE DISPOSAL TESTING

MARYLAND STATE DEPARTMENT OF HEALTH

HOWARD COUNTY

ELLICOTT CITY

DISTRICT 5

DATE 2/2/22

TO: THE COUNTY HEALTH OFFICER
ELLICOTT CITY, MARYLAND

I, HEREBY, APPLY FOR THE NECESSARY TESTS IN ORDER TO CONSTRUCT (OR RECONSTRUCT) A SEWAGE DISPOSAL SYSTEM.

PROPERTY OWNER Robert E. & Ann J. Thompson

ADDRESS Route 2, Apt. 6, Mount Airy, Maryland PHONE 829-2251
2171

PROPERTY LOCATION

SUBDIVISION _____ LOT NO. _____

ROAD AND DESCRIPTION Redberry Rd - take Rd 295 turn right on Route 326

go approx 3 miles turning left at Hall's Shop Rd (1 mile from

turn left on first rd (Halls Shop Rd) follow rd to int. 2nd rd left

OCCUPANT _____ PHONE _____

PERSON TO CONSTRUCT SYSTEM _____

ADDRESS _____ PHONE _____

SIZE OF LOT 40 ⁰⁰ ft x 2 acres TYPE BLDG. 3 bedroom home
NUMBER OF BEDROOMS

IF NOT SINGLE RESIDENCE DESCRIBE _____


SIGNATURE OF APPLICANT Robert E. Thompson Ann J. Thompson

APPROVED BY _____ FOR _____ DATE _____

REJECTED BY _____ FOR _____ DATE _____

HOLD PENDING FURTHER TESTS _____ DATE _____

REASONS FOR REJECTION OR HOLDING _____

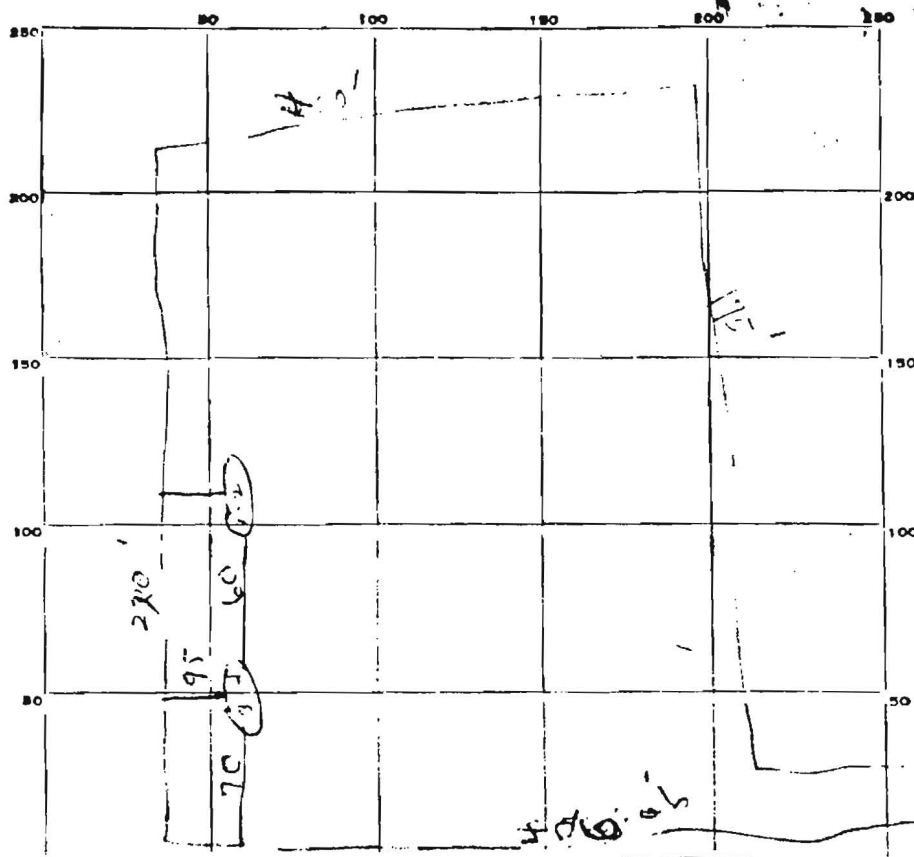

INDICATE NORTH - NAME ADJOINING ROADWAY AS BASE LINE

[illegible]

SOIL AUGER FINDING.

----- BY

October 24, 1972


TO WHOM IT MAY CONCERN:

This is to certify that the Robert E. Thompson & Ann J. Thompson property on Redberry Road, Clarksville, Maryland, passed the standard percolation test on August 16, 1972.

Very truly yours,

Palmer F. Wine, Director
Environmental Health

PFW:jx

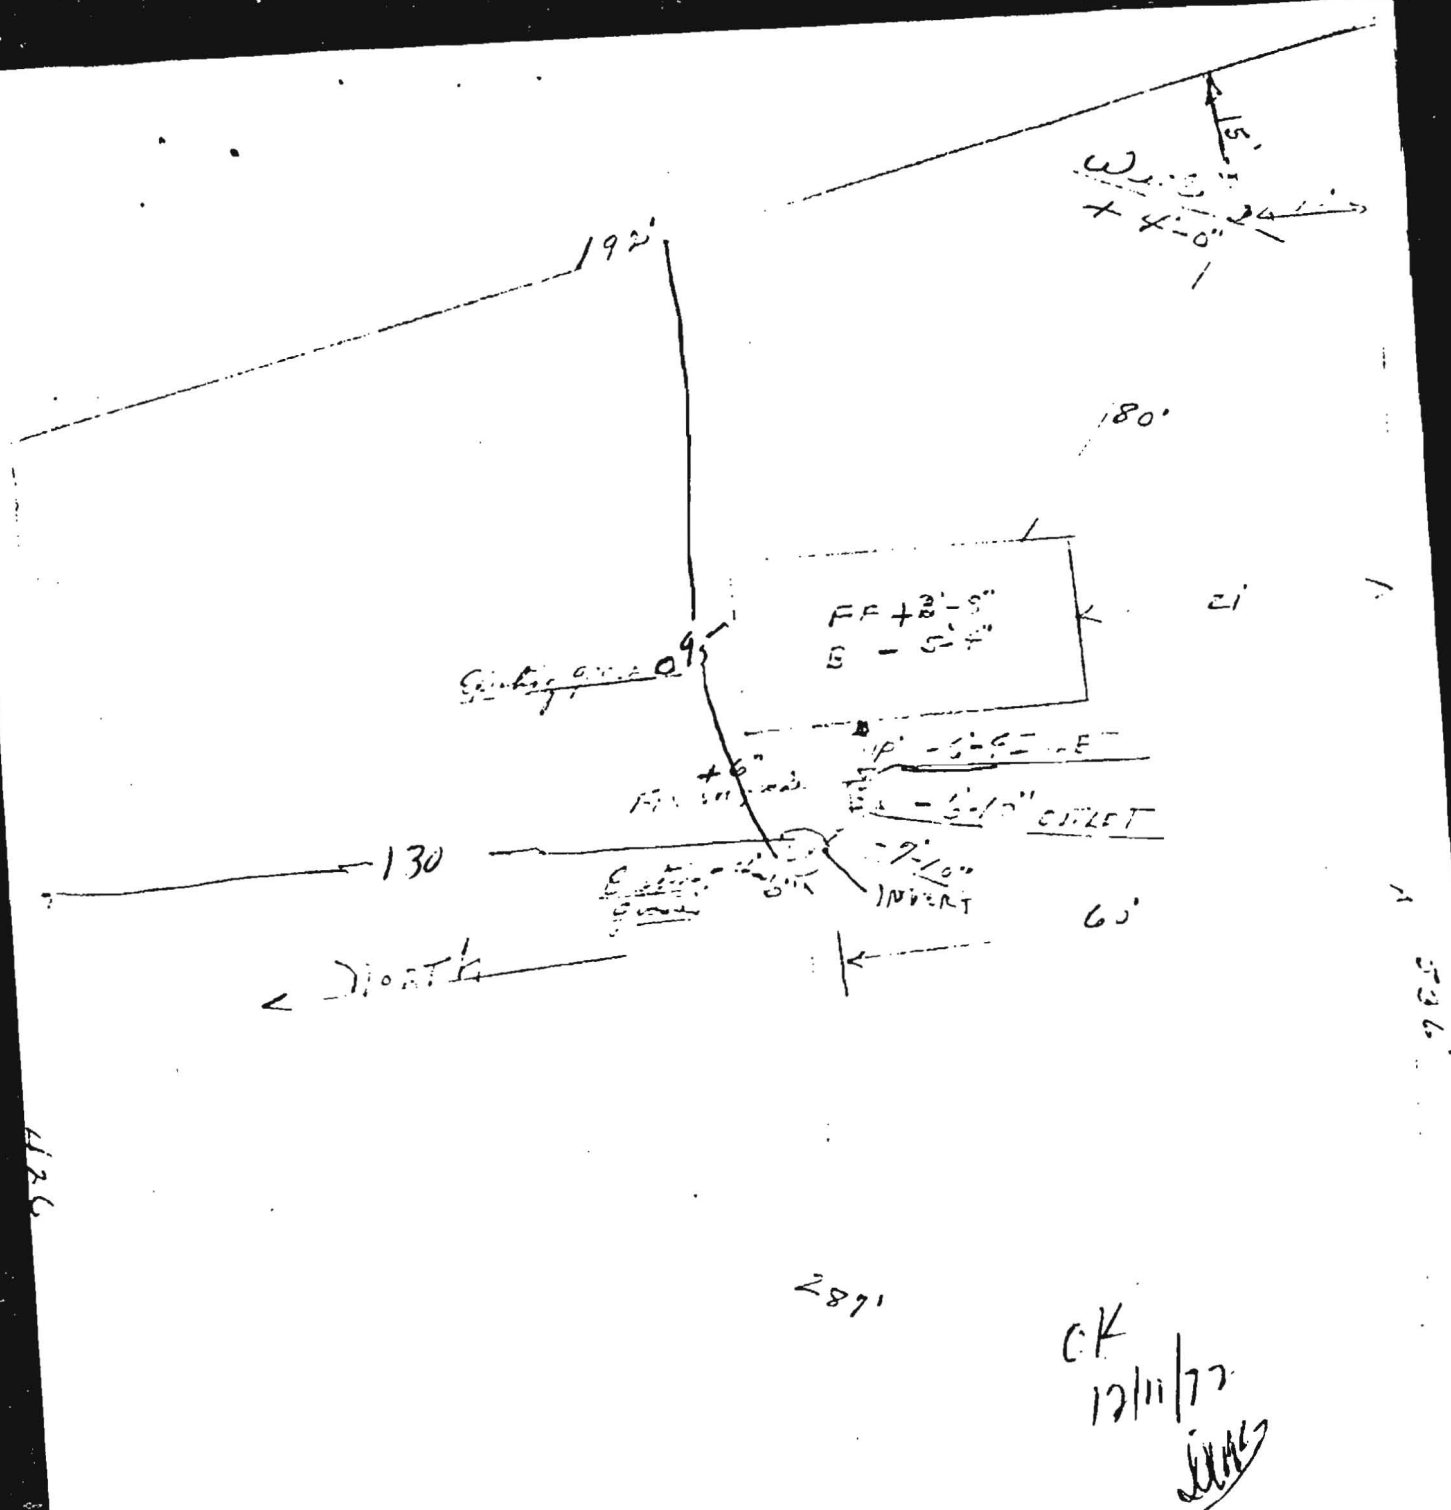

I certify the above dimensions & Elevation differences
are correct & correct for the property.

V L. J. [Signature]

NOTES:

The lot shown hereon complies with the minimum ownership and lot area as required by the Maryland State Health Department regulations.

APPROVED FOR PRIVATE WATER AND PRIVATE SEWERAGE SYSTEMS
HOWARD COUNTY HEALTH DEPARTMENT

G. Baker MD 4-12-72
GRET. CLARK MD DATE
HOWARD COUNTY HEALTH OFFICER



NOTE: For latest reference to 2,000 Acre parcel shown hereon see conveyance to Robert and Ann J. Thompson recorded among the Land Records of Howard Co. in Liber C.M.P.G.I. Page 725

SURVEYOR'S CERTIFICATE

I hereby certify that the plan shown hereon is correct and that property markers found or set are in place where indicated

to 10/10/72
Date

George W. Bushey
GEORGE W. BUSHEY
Registered Land Surveyor Md #2565



PLAT OF SURVEY
PART OF THE
MILTON R. IGLEHART ESTATE
CLARKSVILLE ELECTION DISTRICT NO. 5
HOWARD COUNTY, MARYLAND
SCALE "1" = 100' OCTOBER, 1972

1:200

