

5/12/05

SEPTIC TANK

APPROVED


BP# B00153840 A# 520409

APP. SAN Katie Turner DATE: 5/12/05
DESC. OF WORK: Deck

EX. GRADE	425.5
FIN. GRADE	425.5
INV. IN	422.2
INV. OUT	422.0

INLET DEPTH
BOT. DEPTH
WIDTH

*NOTE: TRENCH LENGTH & ORIENTATION TO BE DETERMINED BY HEALTH DEPARTMENT AT TIME OF SEPTIC SYSTEM LAYOUT INSPECTION.

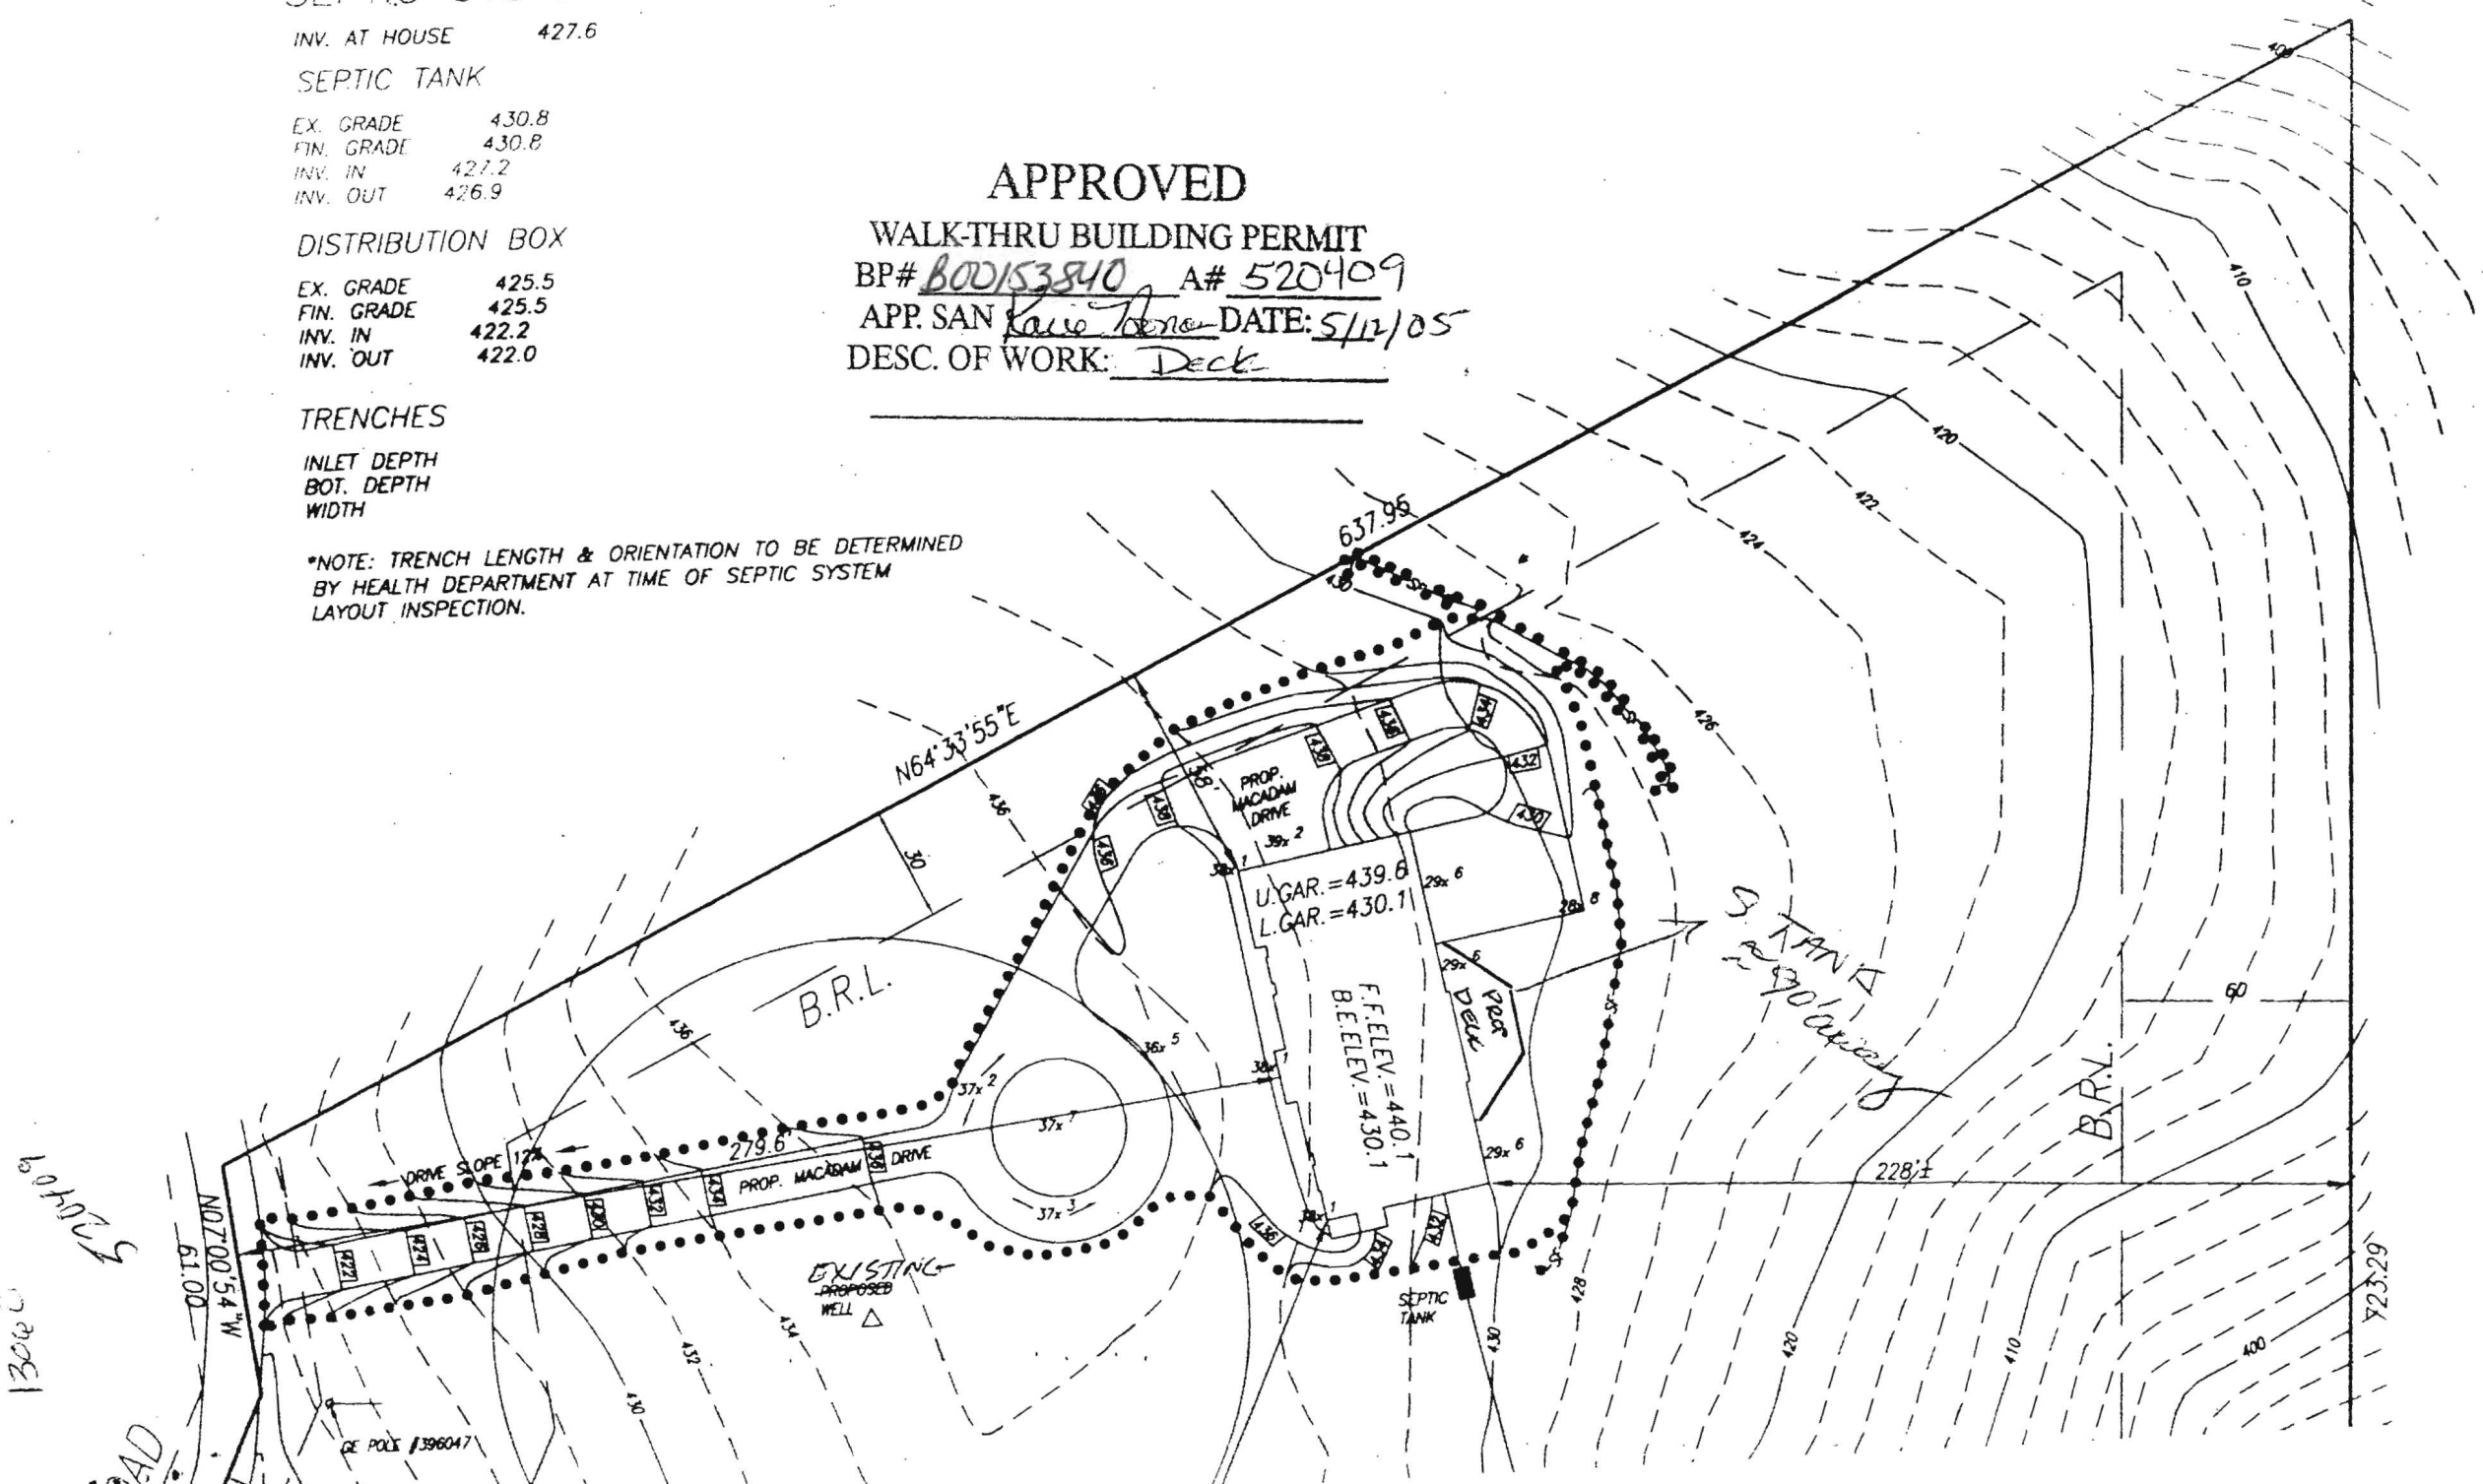

Bruce Bates

13060 Wainwright Road

Highland, Md. 20777

D1	From tank to well	= 260'
D2	" " "	home = 40'
D3	" " "	home = 42'
D4	" " "	septic tank = 112'
D5	" " "	septic field = 85'

Scale is 1" = 50'

plan to scale

11-16-04

800151092

LP TANK OK

(KN)

