

APPLICATION

SEWAGE DISPOSAL TESTING

MARYLAND STATE DEPARTMENT OF HEALTH

HOWARD COUNTY

ELLICOTT CITY

DISTRICT 4

DATE 3/6/61

Builder:

Herman Sirk: Huntley 9-4724

*one 15 ft. diameter
by 15 ft deep dry well
located
133 ft. from the front property line
and 33 ft. from the right side
property line. Right side property line
extended where heavy lot front West
Watersville road. First 3 ft of ground
not to be included in concrete tank.
75 gal septer tanks.*

TO: THE COUNTY HEALTH OFFICER
ELLICOTT CITY, MARYLAND

I, HEREBY, APPLY FOR THE NECESSARY TESTS IN ORDER TO CONSTRUCT (OR RECONSTRUCT) A SEWAGE
DISPOSAL SYSTEM.

PROPERTY OWNER Bunn, Robert and Laura

ADDRESS Woodbine, Rt. 2, Md.

PHONE _____

PROPERTY LOCATION:

SUBDIVISION _____ LOT NO. _____

ROAD AND DESCRIPTION West Watersville Road - Road leads from U. S. Rt. 40 to Watersville
1/2 mi. from Rt. 40. on left hand side.

OCCUPANT _____ PHONE _____

PERSON TO CONSTRUCT SYSTEM _____

ADDRESS _____ PHONE _____

SIZE OF LOT 3.763 acres TYPE BLDG. 3
NUMBER OF BEDROOMS

IF NOT SINGLE RESIDENCE DESCRIBE _____

SIGNATURE OF APPLICANT Herman E Sirk


APPROVED BY J. C. Henney FOR Dry Well DATE 3-13-61

REJECTED BY _____ FOR _____ DATE _____

HOLD PENDING FURTHER TESTS _____ DATE _____

REASONS FOR REJECTION OR HOLDING _____

THIS IS NOT A PERMIT

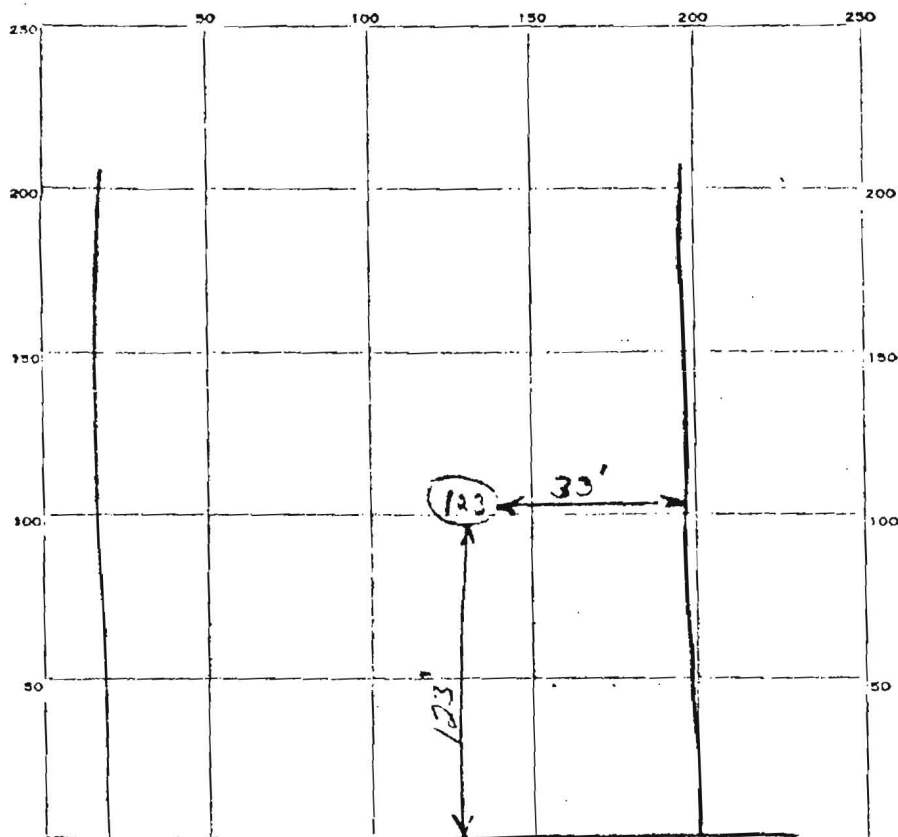

WEST WATERSVILLE

[illegible]


SOIL AUGER FINDING

TESTED BY

REMARKS

ALSO PRESENT


10-42

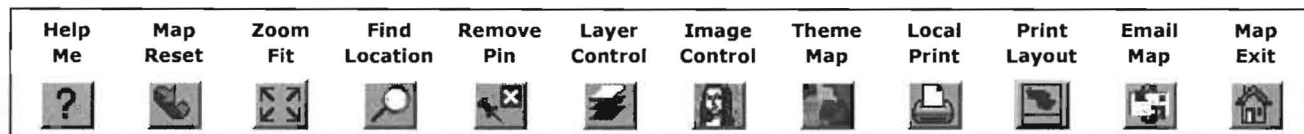

Disclaimer: Howard County, Maryland assumes no responsibility for the accuracy of this map or the information contained herein or derived therefrom. The buyer and/or user assumes all risks and liabilities whatsoever resulting from or arising out of the use of this map. There are no oral agreements or warranties relating to this sale and/or use of this map.

Friday, March 05 2004 | 11:21:44 AM | @723

Map Legends

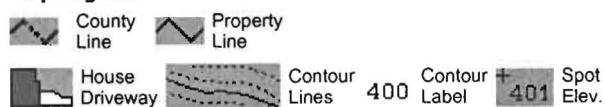

Soils Map



FILE INQUIRY FORM

Property Address: 652 W. Waterville Rd

Potential proposal to demolish ex. house
and rebuild; advised Greg Ziska that
complete re-perc required w/plan & app;
soils likely very marginal
yield test of well req'd if repl. not drilled
MR