

C 1 8285- SEQUENCE NO. (WRA USE ONLY) STATE OF MARYLAND WELL COMPLETION REPORT FILL IN THIS FORM COMPLETELY PLEASE PRINT OR TYPE THIS REPORT MUST BE SUBMITTED WITHIN 30 DAYS AFTER WELL IS COMPLETED COUNTY NUMBER 409926

Date Received WRA use only: 0/12/71 DATE WELL COMPLETED: [] [] [] [] [] [] Depth of Well: 15 (TO NEAREST FOOT) PERMIT NO. FROM "PERMIT TO DRILL WELL" 40-73-3896

OWNER: Wheatley John STREET OR RFD: 101 River Road TOWN: Sykesville SUBDIVISION: 1 LOT: 12 SECTION: 2

WELL LOG Not required for driven wells STATE THE KIND OF FORMATIONS PENETRATED, THEIR COLOR, DEPTH, THICKNESS AND IF WATER BEARING

DESCRIPTION (Use additional sheets if needed)	FEET FROM	TO	Check if water bearing
for sand	0	40	
top black	40	41.5	X

WELL HAS BEEN GROUTED (Circle Appropriate Box) TYPE OF GROUTING MATERIAL CEMENT (CM) BENTONITE CLAY (BC) NO. OF BAGS: 6 NO. OF POUNDS: 56 GALLONS OF WATER: 24 DEPTH OF GROUT SEAL (to nearest foot) from 48 to 37 (enter 0 if from surface) BOTTOM: 37

CASING RECORD casing types insert appropriate code below: ST (STEEL), CO (CONCRETE), PL (PLASTIC), OT (OTHER) MAIN CASING TYPE: S T Nominal diameter (top/main) casing (nearest inch): 6 Total depth of main casing (nearest foot): 40

OTHER CASING (if used) diameter inch: 1 depth feet from: 1 to: 1

SCREEN RECORD screen type or openhole: ST (STEEL), BR (BRASS), HO (OPEN HOLE), PL (PLASTIC), OT (OTHER) insert appropriate code below: ST BR HO PL OT

DEPTH (nearest ft.): 10 71.5

SLOT SIZE: DIAMETER OF SCREEN (NEAREST INCH): from to

GRAVEL PACK: IF WELL DRILLED WAS FLOWING WELL CIRCLE BOX F

WRA USE ONLY (NOT TO BE FILLED IN BY DRILLER) T (E.R.O.S.) W O TELESCOPE LOG OTHER DATA

PUMPING TEST (seq no) C 3 HOURS PUMPED (nearest hour): 6 PUMPING RATE (gal. per min. to nearest gal.): 10 METHOD USED TO MEASURE PUMPING RATE: TIME WATER LEVEL distance from land surface: BEFORE PUMPING: 20 WHEN PUMPING: 160 TYPE OF PUMP USED (for test): A (air), P (piston), T (turbine), C (centrifugal), R (rotary), O (other), J (jet), S (submersible)

PUMP INSTALLED YES NO DRILLER WILL INSTALL PUMP (CIRCLE APPROPRIATE BOX) Y N IF DRILLER INSTALLS PUMP, THIS SECTION MUST BE COMPLETED FOR ALL WELLS EXCEPT HOME USE TYPE OF PUMP (WRITE APPROPRIATE LETTER IN BOX - SEE ABOVE: A, C, J, P, R, S, T, O) CAPACITY: GALLONS PER MINUTE (to nearest gallon): PUMP HORSE POWER: PUMP COLUMN LENGTH (nearest ft.): CASING HEIGHT (circle appropriate box and enter casing height): + above LAND SURFACE - below 2 (nearest foot)

LOCATION OF WELL ON LOT SHOW PERMANENT STRUCTURE SUCH AS BUILDING, SEPTIC TANKS, AND/OR LANDMARKS AND INDICATE NOT LESS THAN TWO DISTANCES (MEASUREMENTS TO WELL):

gout 40' case 0' open, jotted to 30', but had couldn't get through first water ran down, casing broke 8 bags cement 6-8-81 S.K.

CIRCLE APPROPRIATE BOX A A WELL WAS ABANDONED AND SEALED WHEN THIS WELL WAS COMPLETED E ELECTRIC LOG OBTAINED P TEST WELL CONVERTED TO PRODUCTION WELL

DRILLER'S SIGNATURE: [Signature] MATCH SIGNATURE ON APPLICATION

SITE INSPECTION SHEET

OWNER: John A. Wikatzey

PHONE #: 410-412-2093

ADDRESS: 1021 River Rd

CONTRACTOR: _____

Sylkesville MD 21784


WELL TAG #: 73-3896

SUBDIVISION: River Park Est. LOT: 12

COUNTY #: _____

PROPOSAL: add on to existing bedroom

LOCATION DIAGRAM

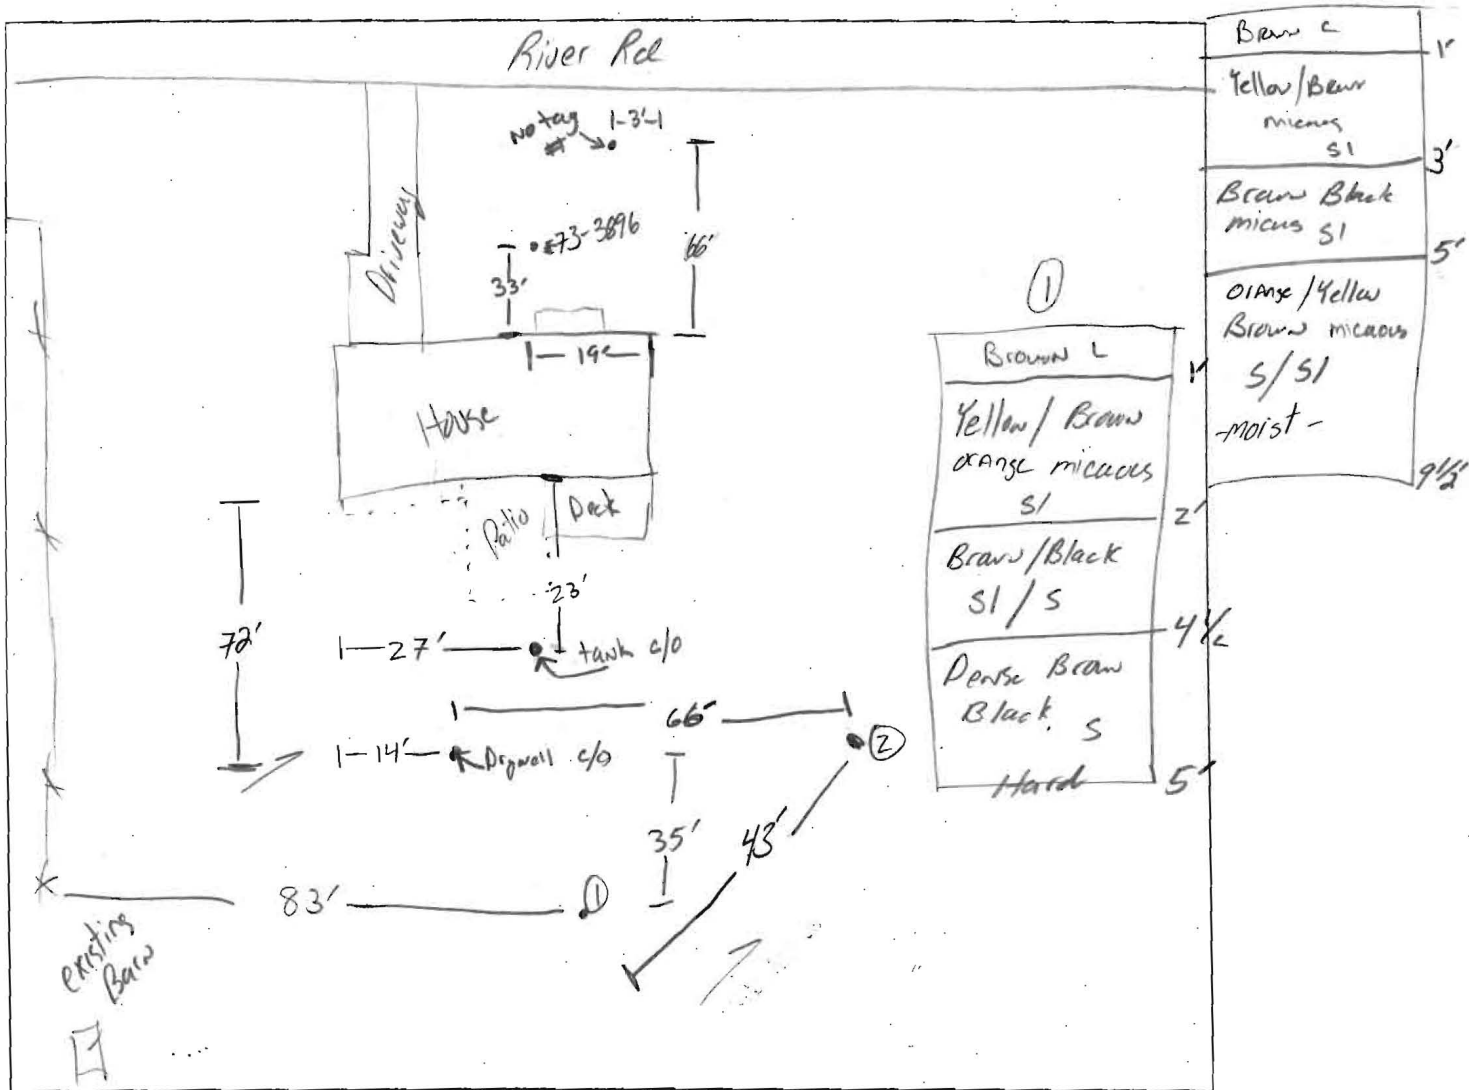

COMMENTS: Home owner stated that they were not adding any bedrooms just adding on to an existing. Both tank + Driveway look OK.

DATE: 7/12/04

INSPECTOR: KJB