

PERMIT

SEWAGE DISPOSAL SYSTEM

MARYLAND STATE DEPARTMENT OF HEALTH*

HOWARD COUNTY

BUREAU OF ENVIRONMENTAL HEALTH

XXX-XXX-XXXX

461-9933

ELLICOTT CITY

DISTRICT 5th

DATE 4/02/86

INDEXED

05-383285

P 36743

A 24016

Oskar Schulz

IS PERMITTED TO INSTALL X ALTER

ADDRESS 6610 Blackwatch Lane, Highland, Maryland 20777

PHONE

SUBDIVISION Highland Lakes

ROAD 6522 River Clyde Drive LOT 46

PROPERTY OWNER

Oskar Schulz

Harold Smith

ADDRESS

BUILDING PERMIT SIGNED

IF GARBAGE GRINDER IS USED INCREASE SEPTIC TANK CAPACITY BY 50% **AND RETURNED** 22%.

GARBAGE GRINDER?

YES

NO

X

SEPTIC TANK CAPACITY 1250 GALLONS

NUMBER OF BEDROOMS 4

8-802 BOB 137901
REMODEL KITCHEN
10/9/2002 BOB 137863 INGROUND POOL

TRENCHES - 158 sq. ft. per bedroom. Trench to be 2 feet wide. Inlet 3.5 feet below original grade. Bottom maximum depth 9 feet below original grade. Effective area begins at 3.5 feet below original grade. 5.5 feet of stone below distribution pipe.

LOCATION = Place the middle of the trench at a point 140 feet from the front lot line and 70 feet from the right lot line as seen when facing the lot from River Clyde Drive. Run half the trench toward the right side line and half of the trench toward the left side line.

NOTE - No trench to exceed 100 feet in length. If more than one trench used, a distribution box is required. Call for inspection of trench(s) before and after gravel is installed. Provide 6" - 8" diameter cleanout and cap to grade or above on septic tank.

ok/cw

PLANS APPROVED BY

R. Hodges

DATE 12/16/83

COVER NO WORK UNTIL INSPECTED AND APPROVED.

NEITHER THE HOWARD COUNTY COUNCIL NOR THE HEALTH DEPARTMENT IS RESPONSIBLE FOR THE SUCCESSFUL OPERATION OF ANY SYSTEM.

NOTE: IF TRENCH IS USED CALL FOR INSPECTION BEFORE AND AFTER PLACING GRAVEL IN TRENCH.

NOTE: NO DRY WELL SHALL EXCEED 15 FOOT IN DIAMETER. NO ABSORPTION TRENCH TO EXCEED 100 FEET IN LENGTH.

NOTE: ALL PIPE FROM HOUSE TO SEPTIC TANK MUST BE CAST IRON OR SCHEDULE 40 PVC OR ABS.

PERMIT VOID AFTER THREE YEARS.


NOTE: INSTALL STAND PIPE ON SEPTIC TANK AND DRY WELL. STAND PIPES MUST BE 6 INCHES IN DIAMETER CAST IRON, CONCRETE OR TERRA COTTA, OR PVC OR ABS ACCEPTED. IF TOP OF SEPTIC TANK IS DEEPER THAN 3 FEET MANHOLE TO GRADE REQUIRED.

***INSTALLER IS RESPONSIBLE FOR OBTAINING FINAL APPROVAL ON THIS PERMIT**

*CALL 992-2330 FOR INSPECTION OF SEPTIC SYSTEMS.

EH - 2-1082

A 24016

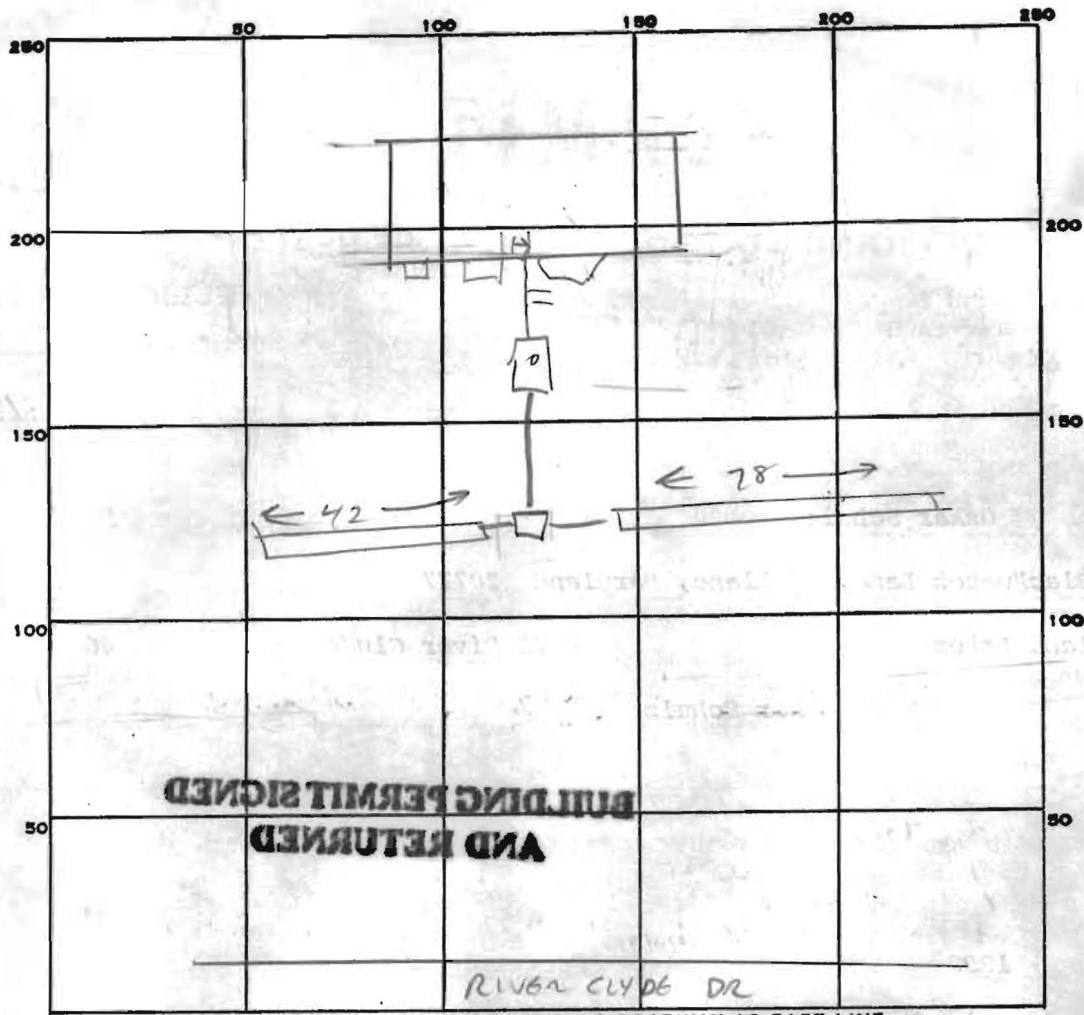

PERMIT CARD NO

SEPTIC TANK, LEVEL ☒

CLEANOUTS Main hole S.T.

DISTRIBUTION BOX, LEVEL ☒

TILE FIELD, DEPTH 5.5 FT. TRENCH WIDTH 2 FT.

GRAVEL DEPTH 9 FT IN. TOTAL LENGTH 120 FT.

NUMBER OF TRENCHES 2 ^{SIDEWALL} TOTAL BOTTOM AREA 720

SEEPAGE PITS, INSIDE DIAMETER — FT. DEPTH BELOW INLET — FT.

ABSORBENT AREA 720 SQ. FT.

REMARKS 3/30/87 OK TO ADD STONE TO TRENCHES. CW 3/30/87 249 PM - TANK CONNECTED
TO HO USE A LITTLE STONE A DIZED BIT

4/3/87 SEPTIC TANK DEEPER THAN 3' - MANHOLE REQUIRED. OSKAR SCHWZ NOTIFIED CW

4/9/87 - 2 rings (≈ 5½') in place, OK to cover following
sementing, OK to finish covering all work.

DATE SYSTEM APPROVED 4/9/87 INSPECTOR B. Nijer