

DEPARTMENT OF INSPECTIONS, LICENSES AND PERMITS 3430 COURT HOUSE DRIVE ELICOTT CITY, MD 21043 PERMITS (410)313-2455 INSPECTIONS (410)313-1810 AUTOMATED INFORMATION (410) 313-3800	HOWARD COUNTY PERMIT APPLICATION	PERMIT NUMBER B00137901
--	--	---

Building Address <u>6522 River Clyde Dr.</u> <u>Highland, Maryland 20777</u> Suite/Apt. #: _____ SDP/WP/Petition #: _____ Census Tract <u>605101</u> Subdivision <u>Highland Castle</u> Section _____ Area _____ Lot <u>46</u> Tax Map <u>34</u> Parcel <u>373</u> Grid <u>22</u> Zoning <u>RR</u> Map Coordinates <u>14510</u> Lot size _____	Property Owner's Name <u>Harold + Mary Smith</u> Address <u>6522 River Clyde Dr.</u> City <u>Highland</u> State <u>MD</u> Zip Code <u>20777</u> Home Phone <u>301-854-3724</u> Work Phone _____ Applicant's Name & Mailing Address, (if other than stated hereon): _____ Phone _____ Fax _____
--	---

Existing Use <u>Screened Porch SFD</u> Proposed Use <u>Family room, kitchen, laundry, bath</u> Estimated Construction Cost \$ <u>150,000.00</u> Description of Work <u>Remodel Kitchen</u> <u>Enclose screen porch, deck 67'3" x 6' w/steps</u>	Contractor Company <u>Pirrone Custom Remodeling Inc</u> Contact Person <u>Michael K. Pirrone</u> Address <u>3805 Wilberta St.</u> City <u>Anney</u> State <u>MD</u> Zip Code <u>20832</u> License No. <u>79544</u> Phone <u>301 924-2610</u> Fax <u>301 924-5750</u>
---	---

Occupant or Tenant <u>Same</u> Contact Name _____ Address _____ City _____ State _____ Zip Code _____ Phone _____ Fax _____	Engineer or Architect Company <u>None</u> Contact Person _____ Address _____ City _____ State _____ Zip Code _____ Phone _____ Fax _____
---	--

BUILDING DESCRIPTION - <u>COMMERCIAL</u>		BUILDING DESCRIPTION - <u>RESIDENTIAL</u>	
Building Characteristics Height: _____ No. of stories: _____ Gross area, sq. ft. per floor: _____ Use group: _____ Construction type: ☐ Reinforced Concrete ☐ Structural Steel ☐ Masonry ☐ Wood Frame ☐ State Certified Modular	Utilities Water Supply: ☐ Public ☐ Private Sewage Disposal: ☐ Public ☐ Private Electric Yes ☐ No ☐ Gas Yes ☐ No ☐ Heating System: Electric ☐ Oil ☐ Natural Gas ☐ Propane Gas ☐ Sprinkler system: N/A ☐ ☐ Full ☐ Partial ☐ Other Suppression ☐ # of Heads	Building Characteristics SF Dwelling ☒ SF Townhouse ☐ Depth Width 1st floor: 30' 72' 2nd floor: 30' 72' Basement: 30' 72' Finished Basement ☒ Unfinished Basement ☐ Crawl space ☐ Slab on Grade ☐ No. of Bedrooms <u>5</u> Multi-family dwellings: No. of efficiency units: _____ No. of 1 BR units: _____ No. of 2 BR units: _____ No. of 3 BR units: _____ Other Structure: _____ Dimensions: _____ Footings: _____ Roof: _____ ☐ State Certified Modular ☐ Manufactured Home	Utilities Water Supply: ☐ Public ☒ Private Sewage Disposal: ☐ Public ☒ Private Electric Yes ☒ No ☐ Gas Yes ☐ No ☒ Heating System: Electric ☒ Oil ☐ Natural Gas ☐ Propane Gas ☐ Sprinkler system: N/A ☐ ☐ NFPA #13D ☐ NFPA #13R ☐ Other:

THE UNDERSIGNED HEREBY CERTIFIES AND AGREES AS FOLLOWS: (1) THAT HE/SHE IS AUTHORIZED TO MAKE THIS APPLICATION; (2) THAT THE INFORMATION IS CORRECT; (3) THAT HE/SHE WILL COMPLY WITH ALL REGULATIONS OF HOWARD COUNTY WHICH ARE APPLICABLE THERE TO; (4) THAT HE/SHE WILL PERFORM NO WORK ON THE ABOVE REFERENCED PROPERTY NOT SPECIFICALLY DESCRIBED IN THIS APPLICATION; (5) THAT HE/SHE GRANTS COUNTY OFFICIALS THE RIGHT TO ENTER ONTO THIS PROPERTY FOR THE PURPOSE OF INSPECTING THE WORK PERMITTED AND POSTING NOTICES.

Applicant's Signature Michael K. Pirrone

Print Name Michael K. Pirrone

Title/Company MR 8/8/02

Date


Checks payable to: DIRECTOR OF FINANCE OF HOWARD COUNTY

** PLEASE WRITE NEATLY AND LEGIBLY. **

FOR OFFICE USE ONLY

RADIUS = 750.00' — ARC = 195.47'

8/8/02 (MR)
OK TO SIGN BP FOR
KITCHEN, DECK
& PORCH

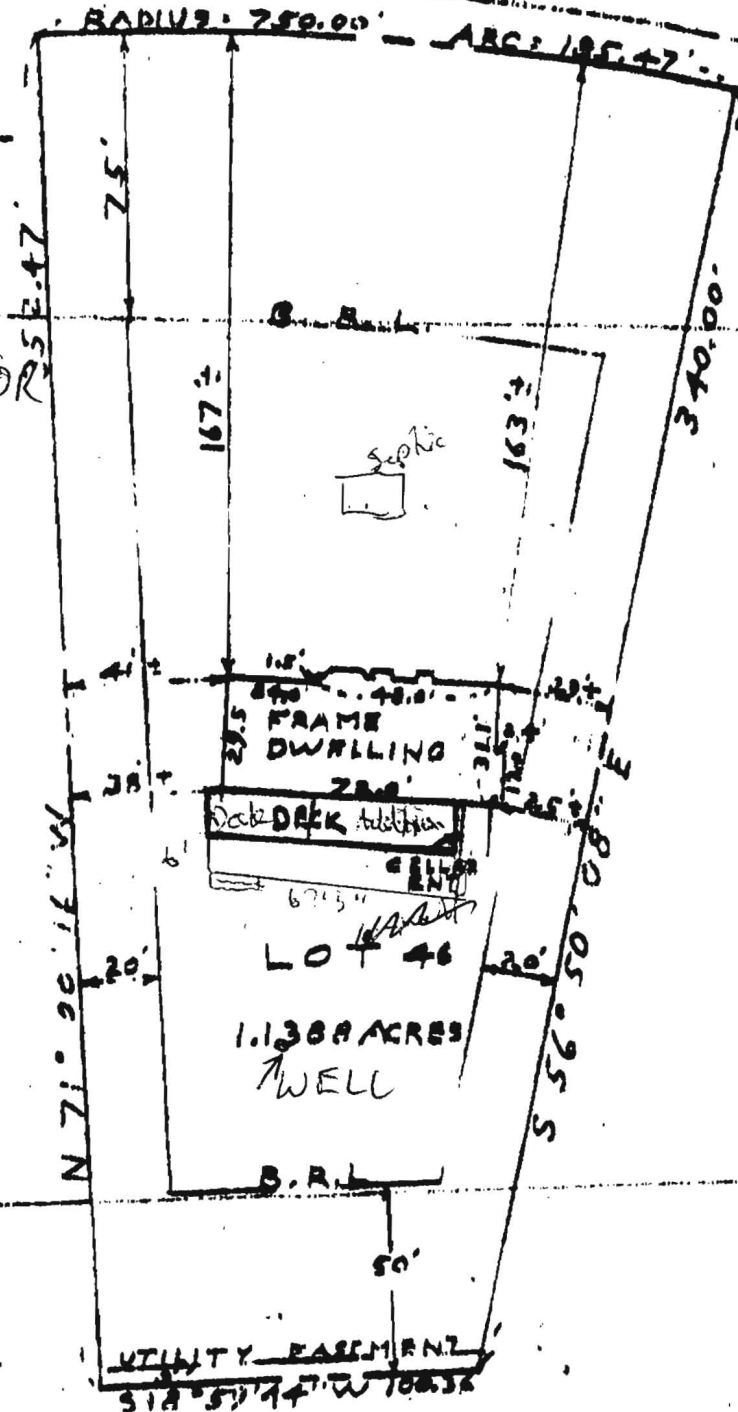

Signed This 17th day SEPTEMBER 1926
William Doyle

File No. 369

NOTE: This plat cannot be used to establish

William E. Doyle


LAND SURVEYOR 8440

5312 EMERALD DRIVE

SYKESVILLE, MARYLAND 21784

PHONE (301) 795-2210

RIVER CLYDE DRIVE

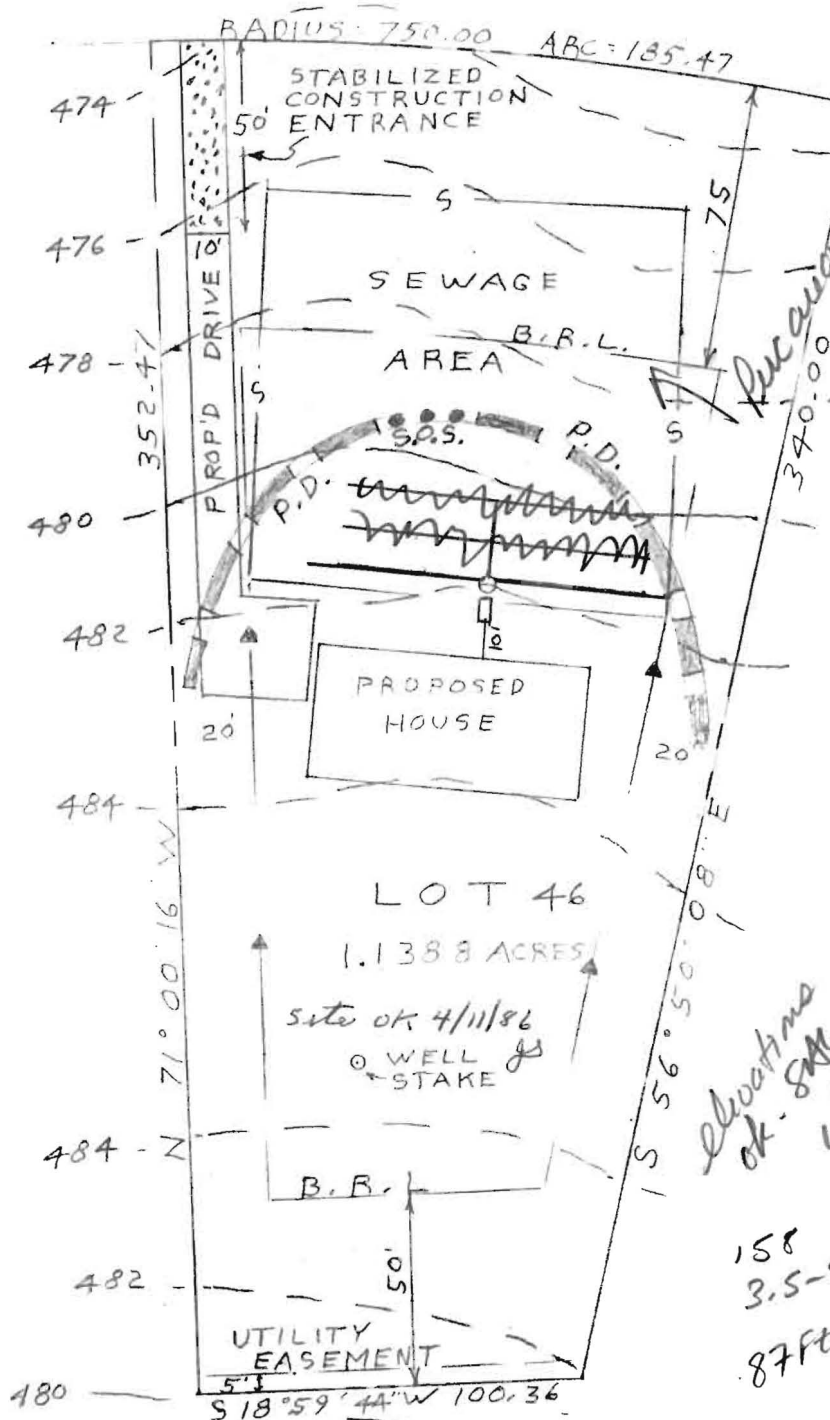

S.O.S.-DENOTES STONE
OUTLET STRUCTURE.

P.D.- DENOTES EARTHEN
PERIMETER DIKE &
LIMIT OF CONSTRUCTION

DENOTES BLDG. RESTRICTION
LINE STAKE SET.

*Elevations
ok - 8/11/86
4/13/86*

*158
3.5-9
87ft Trench*

PLOT PLAN

LOT 46, RIVER CLYDE DRIVE
HIGHLAND LAKE, SECTION 2
SHEET 3 OF 3, PLAT NO. 3877
ELECTION DISTRICT 5
HOWARD COUNTY MD.

EXIST. GRN. AT DISTR. BOX	482.00
INV. IN DISTR. BOX	478.50
INV. OUT OF SEPTIC TANK	478.58
INV. INTO SEPTIC TANK	478.98
INV. OUT OF DWELLING	479.18
FIRST FLOOR ELEV.	488.00
CELLAR ELEV.	479.00
WELL ELEV.	484.50
NO. OF BEDROOMS	3
ACREAGE	1.1388 ACRES



I CERTIFY THE ABOVE MEASUREMENTS
AND ELEVATIONS ARE ACTUAL AND
CORRECT FOR THIS PROPERTY.

signed *William E. Doyle*

SCALE: 1" = 50'

DRAWN: MARCH 22, 1986

FILE NO. 369