



APPLICATION

FOR PERCOLATION TESTING AND SITE EVALUATION

TEST DATE(S) _____ TEST TIME _____

AP 520836

AGENCY REVIEW: _____

DATE 8/19/04

DO NOT WRITE ABOVE THIS LINE

I HEREBY APPLY FOR THE NECESSARY TESTING/EVALUATION PRIOR TO ISSUANCE OF SEWAGE DISPOSAL SYSTEM PERMIT(S) TO:

CHECK AS NEEDED:

- ☐ CONSTRUCT NEW SEPTIC SYSTEM(S)
☒ REPAIR/ADD TO AN EXISTING SEPTIC SYSTEM
☐ REPLACE AN EXISTING SEPTIC SYSTEM

CHECK AS NEEDED:

- ☐ NEW STRUCTURE(S)
☒ ADDITION TO AN EXISTING STRUCTURE
☐ REPLACE AN EXISTING STRUCTURE

CHECK ONE:

- ☐ CREATE NEW LOT(S)
☒ BUILD ON AN EXISTING LOT IN A SUBDIVISION
☐ BUILD ON AN EXISTING PARCEL OF RECORD

IS THE PROPERTY WITHIN 2500' OF ANY RESERVOIR?

- ☐ YES
☒ NO

THE TYPE OF STRUCTURE IS:

- ☒ RESIDENTIAL WITH 4 PROPOSED BEDROOMS IN THE COMPLETED STRUCTURE (NOTE **UNKNOWN** IF APPROPRIATE)
☐ COMMERCIAL (PROVIDE DETAIL OF NUMBERS AND TYPES OF EMPLOYEES/ CUSTOMERS ON ACCOMPANYING PLAN)
☐ INSTITUTIONAL/GOVERNMENT (PROVIDE DETAIL OF NUMBERS AND TYPES OF EMPLOYEES/USERS ON ACCOMPANYING PLAN)

PROPERTY OWNER(S) Michele Roireau

DAYTIME PHONE 301-688-5275 CELL _____ FAX _____

MAILING ADDRESS 11926 Queen St Fulton MD 20759
STREET CITY/TOWN STATE ZIP

APPLICANT Michele Roireau

DAYTIME PHONE 301-688-5275 CELL _____ FAX _____

MAILING ADDRESS 11926 Queen St Fulton MD 20759
STREET CITY/TOWN STATE ZIP

APPLICANT'S ROLE: DEVELOPER BUILDER owner BUYER RELATIVE/FRIEND REALTOR CONSULTANT

PROPERTY LOCATION
SUBDIVISION/PROPERTY NAME King's Manor LOT NO. 15

PROPERTY ADDRESS 11926 Queen St Fulton MD 20759
STREET TOWN/POST OFFICE

TAX MAP PAGE(S) 41 GRID 19 PARCEL(S) 294 PROPOSED LOT SIZE 1 ACHRE

AS APPLICANT, I UNDERSTAND THE FOLLOWING: THE SYSTEM INSTALLED SUBSEQUENT TO THIS APPLICATION IS ACCEPTABLE ONLY UNTIL PUBLIC SEWERAGE IS AVAILABLE. THIS APPLICATION IS COMPLETE WHEN ALL APPLICABLE FEES AND A SUITABLE SITE PLAN HAVE BEEN RECEIVED. I ACCEPT THE RESPONSIBILITY FOR COMPLIANCE WITH ALL M.O.S.H.A. AND "MISS UTILITY" REQUIREMENTS. APPROVAL IS BASED UPON SATISFACTORY REVIEW OF A PERC CERTIFICATION PLAN.

TEST RESULTS WILL BE MAILED TO APPLICANT.

Michele Roireau
SIGNATURE OF APPLICANT

HOWARD COUNTY HEALTH DEPARTMENT, BUREAU OF ENVIRONMENTAL HEALTH, WELL AND SEPTIC PROGRAM
3525-H ELLICOTT MILLS DRIVE, ELLICOTT CITY, MARYLAND 21043-4544 (410) 313-1771 FAX (410) 313-2648
TDD (410) 313-2323 TOLL FREE 1-877-4MD-DHMH

(A)

Str org brn
Dense
CL

abrupt
boundary
purple, ybrn,
rdbrn,
strbrn
SL-L
loose

Trace
Rx
Bottom
Cave-in
@ 11'
Super saturation
13 1/2'

(B)

Massive
wkrd
CL

WKrd
scl
4 1/2'
6 1/2'

rdbrn
brn
Loam

Water
Seepage
Cave-in
11'-
Bottom
14'

(C)

Strong red
CL
massive
No Rx

str red Ben
s/L


rd brn
brn
SL loam
No Rx

Bottom
15'



DATE	TEST #	DEPTH	START	BREAK 1" DROP	STOP 2" DROP	TIME OF 2nd INCH	P/F/H
12-1-04	(A)	4 1/2'	14:05 ⁰⁰	14:09'	14:12	5	P
	(B)	5' S	14:19	TOO SLOW			
		TO BACK PROLINE ~55'					
		7' S	14:30 ²⁷	14:36	14:49	13	P
	(C)	15' Bottom - visual					
		35' from House 10' from Dry well C/O					
		Elevation difference from hole C to B					
		Approx 7' of approx 45'					

REMARKS No Rock, No mottles or distinct Mn concretions due to well
 SANITARIAN Kacie K BACKHOE Watfields OTHERS owner
 TEST HOLES USED IN SDA _____ AVG. PERC TIME 8 SQ. FT/BR 210
 TRENCH WIDTH _____ INLET DEPTH _____ MAX. BOT DEPTH _____ EFFECTIVE SW _____

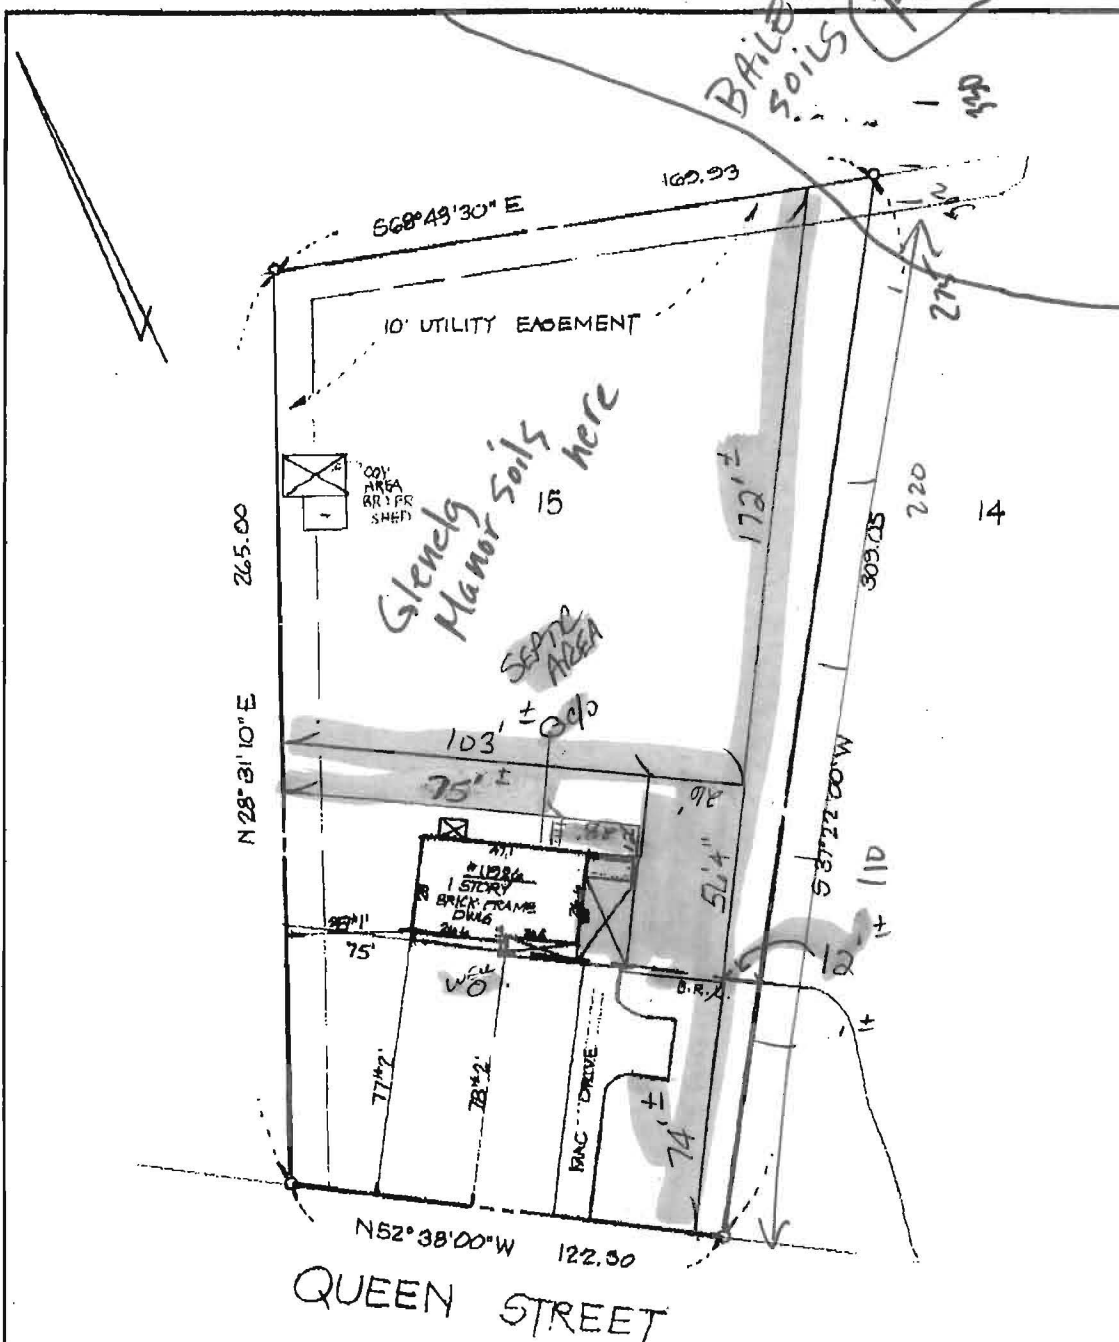


7/29/04
 upgrade
 for permit
 needed
 NEED 1250 S.T.
 last perc
 tests done
 in '65.
 NEED TO
 ID
 Repair
 & area
 assess
 current
 septic
 KK

NOTE: I ALSO KNOWN AS LOT 15 AS SHOWN ON PLAT OF "LOTS 1 THRU 15, KINGS MANOR"
 RECORDED IN HOWARD CO., MD IN PLATBOOK 9 POLIC 52

Subject property is shown in Zone
 on the National Flood Insurance Program
 Flood Insurance Rate Map of Howard
 County, Maryland, Panel # 38 of 45
 Community Panel # 240044 00384
 Effective Date Dec 4 1986

- 1) The plat is of benefit to a consumer only insofar as it is required by a lender or a title insurance company or its agent in connection with contemplated transfer, financing or re-financing;
- 2) The plat is not to be relied upon for the establishment or location of fences, garages, building, or other existing or future improvements;
- 3) The plat does not provide for the accurate identification of property boundary lines, but such identification may not be required for the transfer of title or securing financing or re-financing.

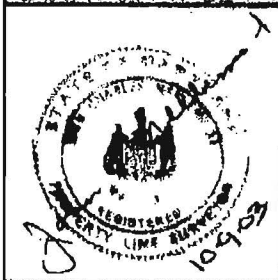


CASE # 454364		SCALE: 1"=55'
LOCATION DRAWING		DATE: 10-2-03
11026 QUEEN STREET HOWARD CO. MARYLAND		JOB NO: 08531
JOHN G. MELLEMAS SR., INC. LAND SURVEYORS		
8409 EAST DRIVE BALTIMORE, MARYLAND 21227 (410) 247-7488		

6/11 9

A10243
P10940

20 61 51.1

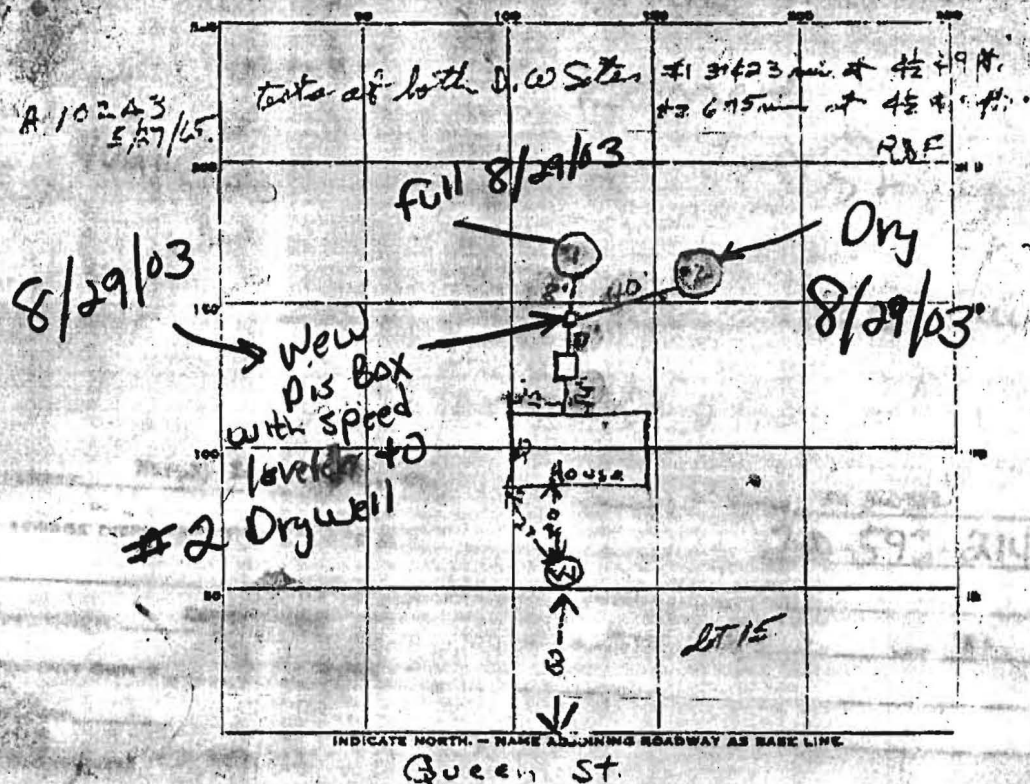

PERMIT CARD

SEPTIC TANK, LEVEL Of concrete 7.0CLEANOUT OKDISTRIBUTION BOX, LEVEL gradeTILE FIELD, DEPTH FT. TRENCH WIDTH FT.GRAVEL DEPTH IN. TOTAL LENGTH FT.NUMBER OF TRENCHES 41-12 TOTAL BOTTOM AREA 21.7GESPAGE PITS, INSIDE DIAMETER 2-11 FT. DEPTH BELOW INLET 2-6 FT.ABSORBENT AREA 470 SQ. FT.REMARKS 10/7/65 - made 5 ft of cast iron pipe outside of house - 2 ft10/15/65 - OK 5 ft of cast iron pipe added BTDATE SYSTEM APPROVED 10/15/6512:50 PMINSPECTOR Raymond H. Jones