

11926 QUEEN STREET

10/17/65
J. H. L.

PERMIT

SEWAGE DISPOSAL SYSTEM

MARYLAND STATE DEPARTMENT OF HEALTH

HOWARD COUNTY

INDEXED

ELLICOTT CITY

DISTRICT 5

DATE 9/21/65

P 10940
10243
A 09368

Elwood Scaggs

IS PERMITTED TO INSTALL ☒ ALTER

ADDRESS Murphy Rd., Laurel, Md.

PHONE PA 5-0324

A SEWAGE DISPOSAL SYSTEM LOCATED AT _____

SUBDIVISION Kings Manor

ROAD Queen Street

LOT 15

PROPERTY OWNER P. M. Brown

ADDRESS _____

SPECIFICATIONS - 3 bedrooms

DRAIN FIELD _____ DEPTH _____ FEET, BOTTOM AREA _____ SQ. FT.

SEEPAGE PITS _____ ABSORBENT SIDE-WALL AREA _____ SQ. FT.

SEPTIC TANK CAPACITY 750 GALLONS

FOR GARBAGE GRINDER, INCREASE DISPOSAL AREA 22% & TANK CAPACITY 50%.

OTHER Dry well - 438 sq. ft. absorbent sidewall area below inlet pipe.

Locate dry well 132 ft. from front lot line and 23 ft. from right side line as lot is seen when facing it from Queen Street.

PLANS APPROVED BY R. Fletcher DATE 5/27/65

FILL SEPTIC TANK AND DISTRIBUTION BOX WITH WATER BEFORE CALLING FOR AN INSPECTION. COVER NO WORK UNTIL INSPECTED AND APPROVED.

NEITHER THE HOWARD COUNTY COMMISSIONERS NOR THE HEALTH DEPARTMENT IS RESPONSIBLE FOR THE SUCCESSFUL OPERATION OF ANY SYSTEM.


A 10243

A 10243
5/27/65.

| | | |
|--|--------------------------|--|
| | tests at both S.W. Sites | |
|--|--------------------------|--|

#1 3423 min of $2\frac{1}{2}$ @ 9 ft.
#2 625 min of $4\frac{1}{2}$ @ 9 ft.

REF

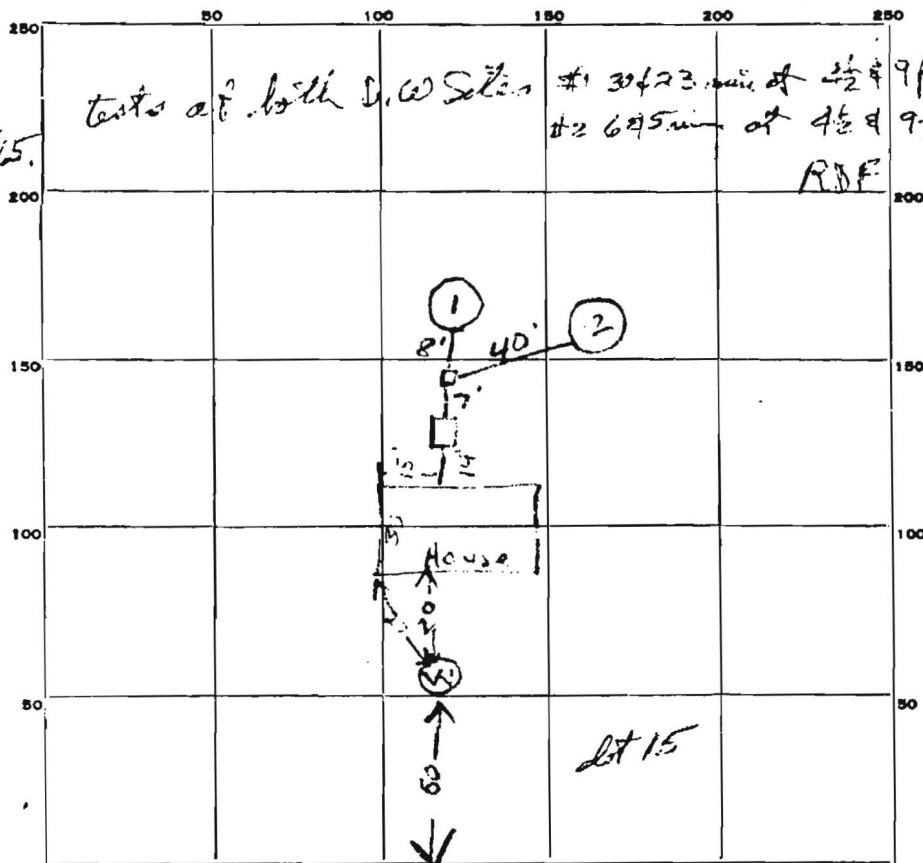

INDICATE NORTH. - NAME ADJOINING ROADWAY AS BASE LINE.

Green St.

PERMIT CARD.

SEPTIC TANK, LEVEL 56 cm 10/1/85

CLEANOUTS 7/1

DISTRIBUTION BOX, LEVEL

TILE FIELD, DEPTH _____ FT. TRENCH WIDTH _____ FT.

GRAVEL DEPTH _____ IN. TOTAL LENGTH _____ FT.

NUMBER OF TRENCHES _____ TOTAL BOTTOM AREA _____

SEEPAGE PITS, INSIDE DIAMETER: 2.11 FT. DEPTH BELOW INLET: 2.6 FT.

ABSORBENT AREA 2.55 SQ. FT.

REMARKS 10/7/65 - 11.20. 5/4 of east side pipe outside of house, - 9 Hk

10/15/65 - OK 5 ft of cast concrete added RH

DATE SYSTEM APPROVED

INSPECTOR