

8/13/04 11am

PUB. SEWER STATUS VERIFIED BY \_\_\_\_\_

ISSUE DATE: 7/26/2004

APPROVAL DATE: 8/13/04

**PERMIT  
INDEXED**

P 520797

A UPGRADE

**ON-SITE SEWAGE DISPOSAL SYSTEM  
HOWARD COUNTY HEALTH DEPARTMENT  
BUREAU OF ENVIRONMENTAL HEALTH**

05-363772

HATFIELDS  
T. N. Ebel Construction Contracting, Inc

IS PERMITTED TO INSTALL ☐ ALTER ☒

ADDRESS: 13411 Rich Lynn Court, Highland

PHONE NUMBER: 301-641-0424

SUBDIVISION: Baja Property

LOT NUMBER: \_\_\_\_\_

ADDRESS: 8184 Stabean Drive

PROPERTY OWNER: Steve Coy/Tim Ebel

SEPTIC TANK CAPACITY (GALLONS): \_\_\_\_\_

PUMP CHAMBER CAPACITY (GALLONS): 1250

NUMBER OF BEDROOMS: 5

SQUARE FEET PER BEDROOM: \_\_\_\_\_

LINEAR FEET OF TRENCH REQUIRED: \_\_\_\_\_

TRENCHES:	Trench to be _____ feet wide. Inlet _____ feet below original grade. Bottom maximum depth _____ feet below original grade. Effective area begins at _____ feet below original grade. _____ feet of stone below distribution pipe.
LOCATION:	
PURPOSE:	In support of Building Permit B00148871 (Adding 1 story addition--Master bedroom, kitchen & family room) Call for inspection when ground is opened so sanitarian can recommend repair.

PLANS APPROVED: \_\_\_\_\_

DATE: \_\_\_\_\_

NOTE: PERMIT VOID AFTER 2 YEARS

NOTE: CONTRACTOR RESPONSIBLE FOR SCHEDULING A PRE-CONSTRUCTION INSPECTION FOR ALL INSTALLATIONS

NOTE: WATERTIGHT SEPTIC TANKS REQUIRED

NOTE: ALL PARTS OF SEPTIC SYSTEM SHALL BE 100 FEET FROM ANY WATER WELL

NOTE: MANHOLE RISERS REQUIRED ON ALL SEPTIC TANKS AND PUMP CHAMBERS

**NEITHER THE HOWARD COUNTY COUNCIL OR THE HEALTH DEPARTMENT IS  
RESPONSIBLE FOR THE SUCCESSFUL OPERATION OF ANY SYSTEM  
PERMITTEE RESPONSIBLE FOR OBTAINING FINAL APPROVAL ON THIS PERMIT  
CALL 410-313-2640 FOR INSPECTION OF SEPTIC SYSTEM**

**BUILDING PERMIT SIGNED**

**AND RETURNED**

5/28/2004 B00143495 POOL

8/23/2004 B00148871 BEDROOM, KITCHEN, FAMILY RM W/ UNFINISHED BASEMENT

0520797

NOT TO SCALE

Murphy Rd

Drainage easement

1425'

39'

42'

12"

16"

12"

12"


12"

12"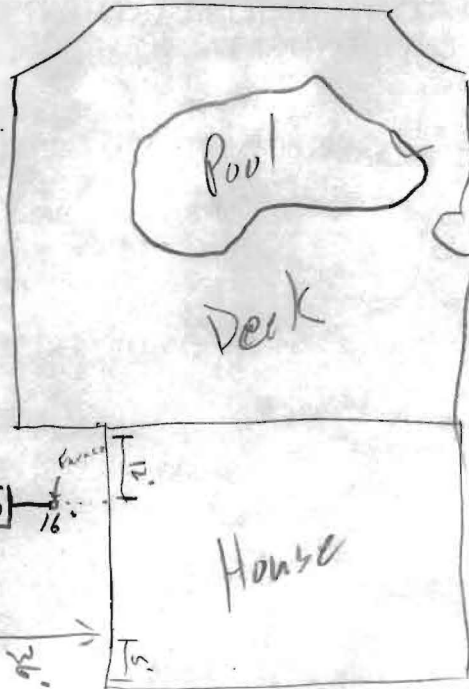

Starboan

ROAD

TRENCH/DRAINFIELD DATA		
WIDTH	INLET	BOTTOM
NUMBER OF TRENCHES		
TOTAL LENGTH		
ABSORPTION AREA		
DISTRIBUTION BOX LEVEL		
DISTRIBUTION BOX BAFFLE		
DISTRIBUTION BOX PORT		

SEPTIC TANK DATA	
SEPTIC TANK 1 LEVEL	<input checked="" type="checkbox"/>
CAPACITY	1500 GAL
SEAM LOC	Top
TANK LID DEPTH	3'
BAFFLES	<input checked="" type="checkbox"/>
BAFFLE FILTER	
MANHOLE LOC	Center
6" PORT LOC	Front
WATERTIGHT TEST	
SEPTIC TANK 2 LEVEL	
CAPACITY	GAL
SEAM LOC	
TANK LID DEPTH	
BAFFLES	
BAFFLE FILTER	
MANHOLE LOC	
6" PORT LOC	
WATERTIGHT TEST	

PRE-CONSTRUCTION

INSTALLATION 8/13/04 - New tank set. Old S.T. pump, collapsed, hauled away. New 16" riser placed on D.W. OK to cover all work (50)


FINAL INSPECTOR

*[Signature]*

DATE OF APPROVAL

8/13/04

BUILDING PERMIT SIGNED AND RETURNED

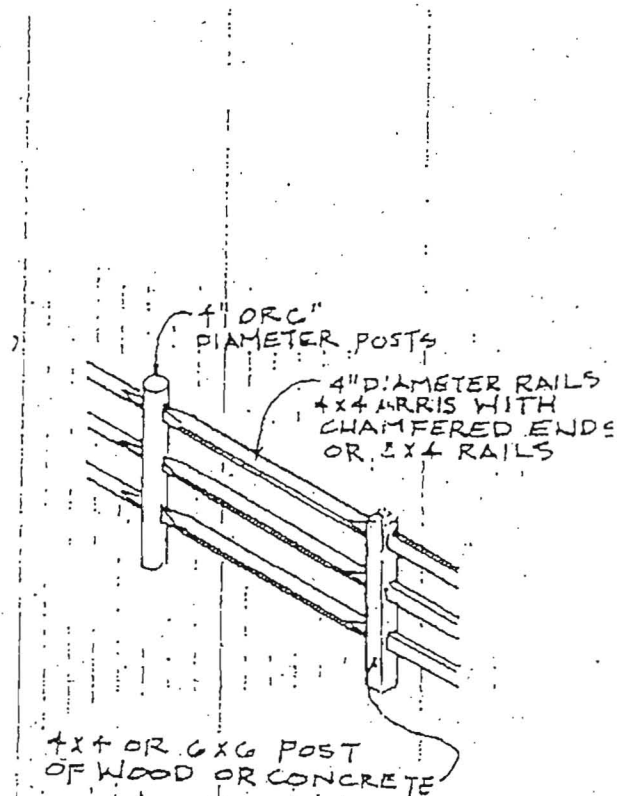

POST AND RAIL WITH


N.T.S. WELDED WIRE PER CODE

1 PM 6/2/04

SITE INSPECTION SHEET

OWNER: Timothy Ebel PHONE #: \_\_\_\_\_  
 ADDRESS: 8184 Stabean Drive CONTRACTOR: J. Mayne  
 WELL TAG #: \_\_\_\_\_  
 SUBDIVISION: \_\_\_\_\_ LOT: \_\_\_\_\_ COUNTY #: \_\_\_\_\_  
 PROPOSAL: Well - Sandy/Dirty - WSI for replacement well

LOCATION DIAGRAM

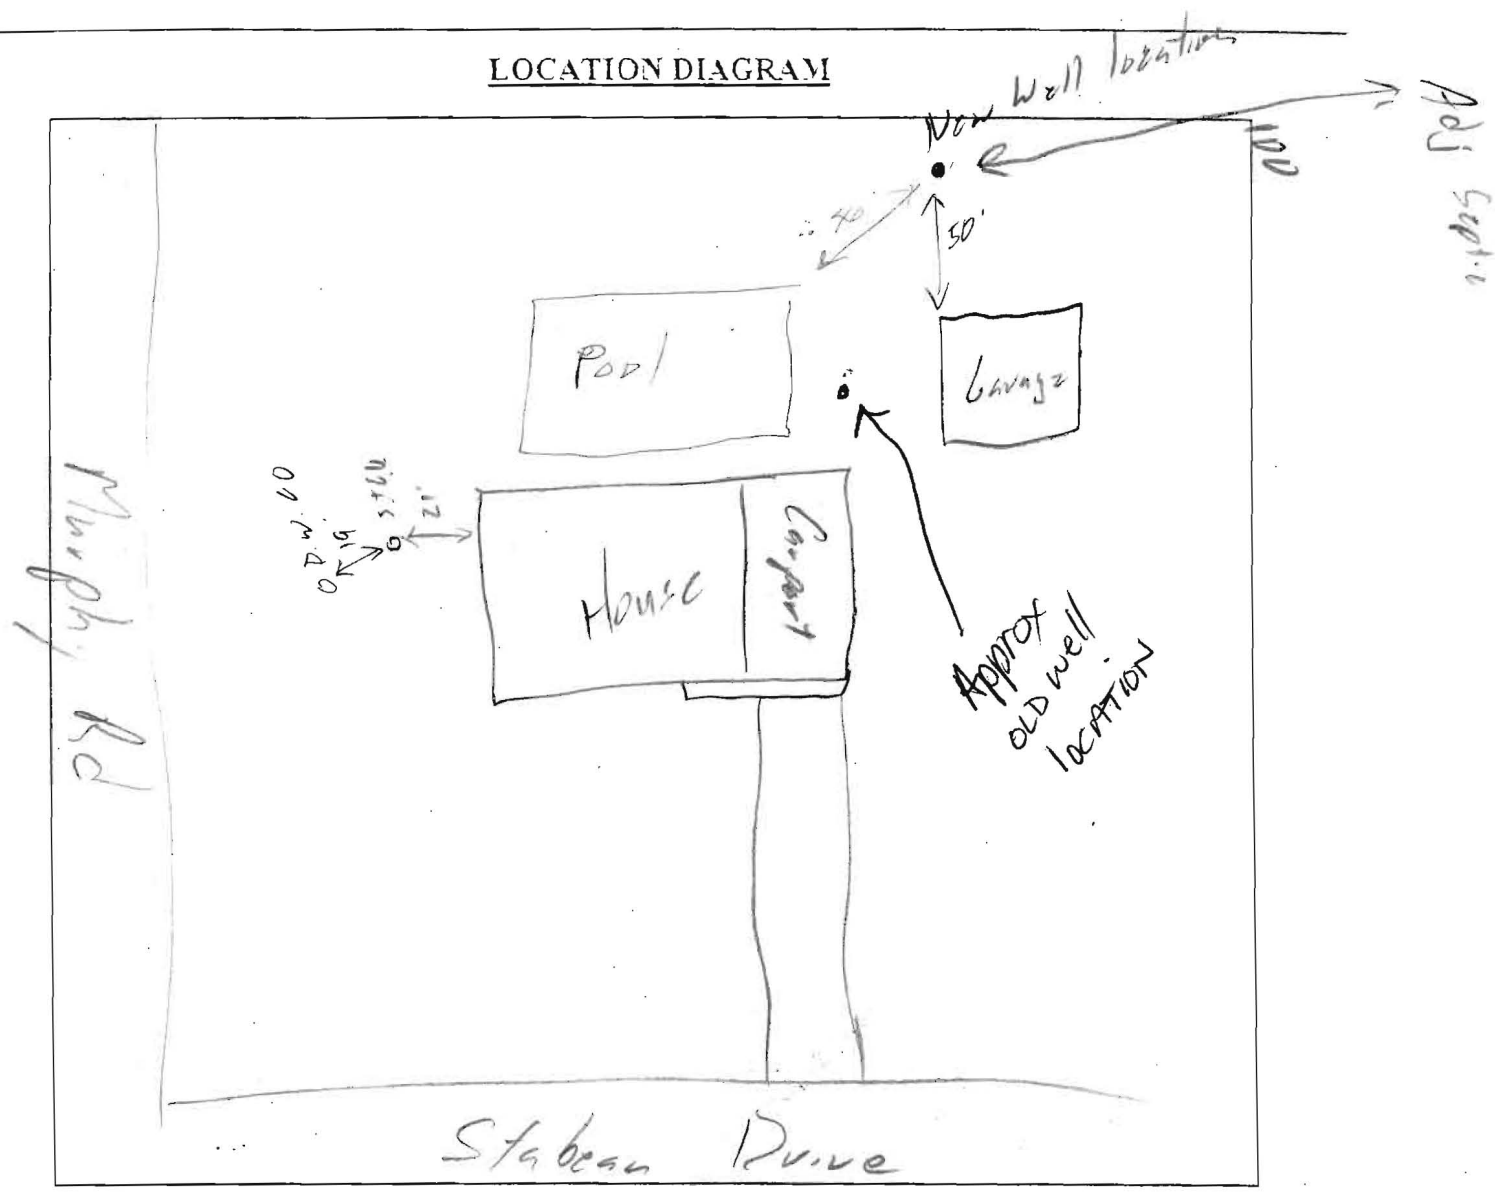

COMMENTS: \_\_\_\_\_

DATE: 6/2/04 INSPECTOR: (SO)