

APPLICATION

SEWAGE DISPOSAL TESTING

MARYLAND STATE DEPARTMENT OF HEALTH

HOWARD COUNTY

ELLICOTT CITY

DISTRICT

DATE

*Septic Tank - 750 gal.
Dry Well - 300 sq ft sidewalk area to
begin below the inlet pipe.*

*Place Dry Well about 60 ft from front lot line
and about 96 ft from left side line as you face
lot from Murphy Rd.*

TO: THE COUNTY HEALTH OFFICER
ELLICOTT CITY, MARYLAND

I, HEREBY, APPLY FOR THE NECESSARY TESTS IN ORDER TO CONSTRUCT (OR RECONSTRUCT) A SEWAGE
DISPOSAL SYSTEM.

PROPERTY OWNER

ADDRESS

PHONE

PROPERTY LOCATION:

SUBDIVISION

LOT NO.

ROAD AND DESCRIPTION

OCCUPANT

PHONE

PERSON TO CONSTRUCT SYSTEM

ADDRESS

PHONE

SIZE OF LOT

TYPE BLDG.

NUMBER OF BEDROOMS

IF NOT SINGLE RESIDENCE DESCRIBE

SIGNATURE OF APPLICANT

APPROVED BY

FOR

(KIND OF SYSTEM)

DATE

REJECTED BY

FOR

(KIND OF SYSTEM)


DATE

HOLD PENDING FURTHER TESTS

DATE

REASONS FOR REJECTION OR HOLDING

THIS IS NOT A PERMIT

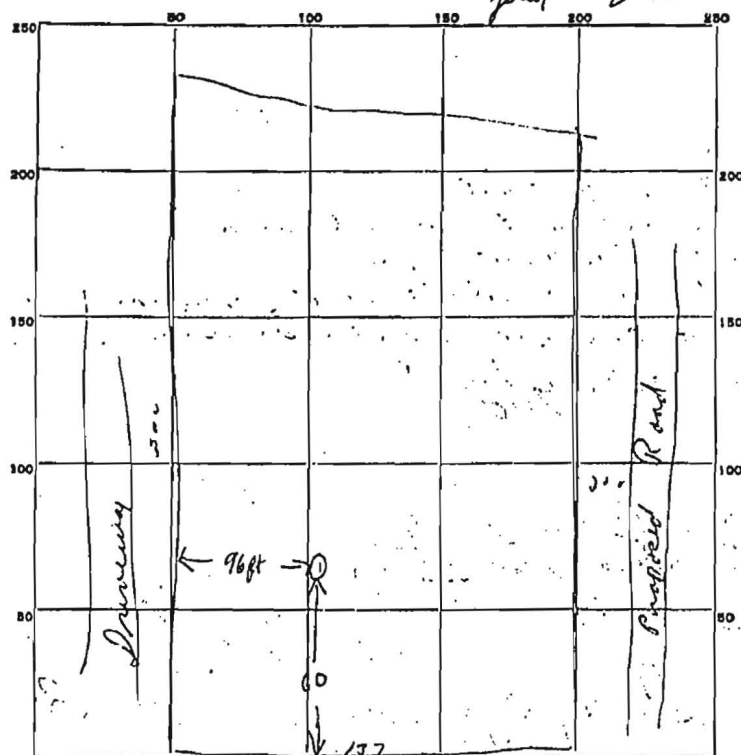

INDICATE NORTH. - NAME ADJOINING ROADWAY AS BASE LINE.

TH. = NAME ADJOINING ROAD.
Murphy Road.


[illegible]

SOIL AUGER FINDING Sand + clay

TESTED BY DWM-9/19/67

REMARKS.

ALSO PRESENT Stanley L. Brown LOT NO. 3

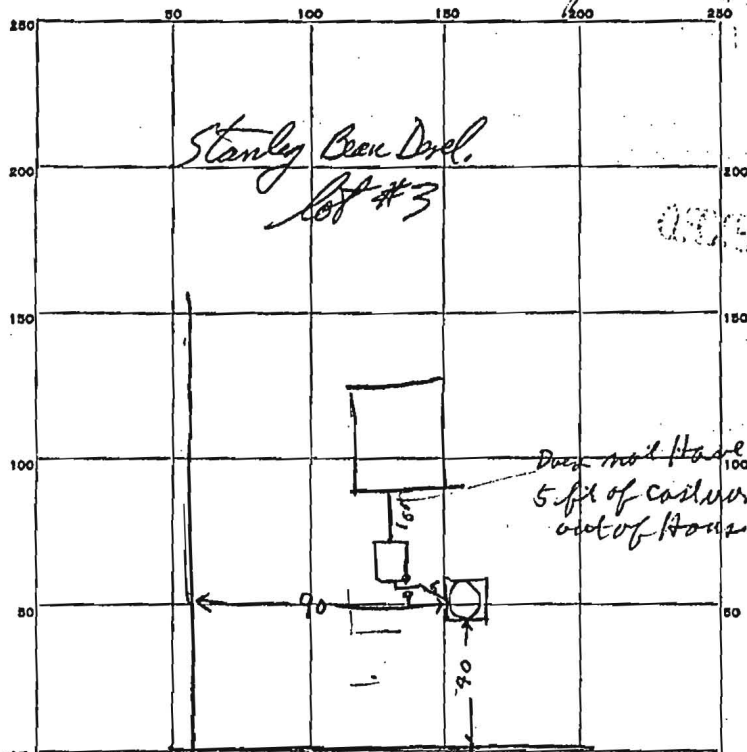

A05787

INDICATE NORTH. - NAME ADJOINING ROADWAY AS BASE LINE.

Murphy Rd.

PERMIT CARD.

SEPTIC TANK, LEVEL OK 750 concrete
Top is 3 ft below grade
 DISTRIBUTION BOX, LEVEL _____

CLEANOUTS

TILE FIELD, DEPTH _____ FT. TRENCH WIDTH _____ FT.

GRAVEL DEPTH IN. TOTAL LENGTH FT.

NUMBER OF TRENCHES _____ TOTAL BOTTOM AREA _____

SEEPAGE PITS, INSIDE DIAMETER 8 FT. DEPTH BELOW INLET 10 FT.

ABSORBENT AREA 250 SQ. FT.

REMARKS

REMARKS: Inlet of Dry Well is 4 ft below grade
1 ft of gravel around outside of dry well

DATE SYSTEM APPROVED _____

16 Jan 63

INSPECTOR

Raymond Hodges