

1/28/75
9:30

1/28/75
Final OK R.T.

PERMIT

SEWAGE DISPOSAL SYSTEM

P 21095
A 21092

MARYLAND STATE DEPARTMENT OF HEALTH
HOWARD COUNTY

INDEXED

ELLICOTT CITY
DISTRICT 5
DATE 1/27/75

File

Jack Fyock IS PERMITTED TO INSTALL ALTER ☒ X

ADDRESS Ten Oaks Road, Glenolq, Md. PHONE 286-2939

A SEWAGE DISPOSAL SYSTEM LOCATED AT

SUBDIVISION ROAD 8184 Stabean Drive LOT

PROPERTY OWNER Prebish *off Murphy R.L.*

ADDRESS

SPECIFICATIONS

DRAIN FIELD DEPTH FEET, BOTTOM AREA SQ. FT.

SEEPAGE PITS ABSORBENT SIDE-WALL AREA SQ. FT.

SEPTIC TANK CAPACITY GALLONS

FOR GARBAGE GRINDER, INCREASE DISPOSAL AREA 22% & TANK CAPACITY 50%.

OTHER REPAIR - Call for inspection when ground is opened up so Sanitarian can

Recommend repair system.


PLANS APPROVED BY Palmer F. Wine DATE 1/27/75

FILL SEPTIC TANK AND DISTRIBUTION BOX WITH WATER BEFORE CALLING FOR AN INSPECTION. COVER NO WORK UNTIL INSPECTED AND APPROVED.

NEITHER THE HOWARD COUNTY COMMISSIONERS NOR THE HEALTH DEPARTMENT IS RESPONSIBLE FOR THE SUCCESSFUL OPERATION OF ANY SYSTEM.

21092

21095

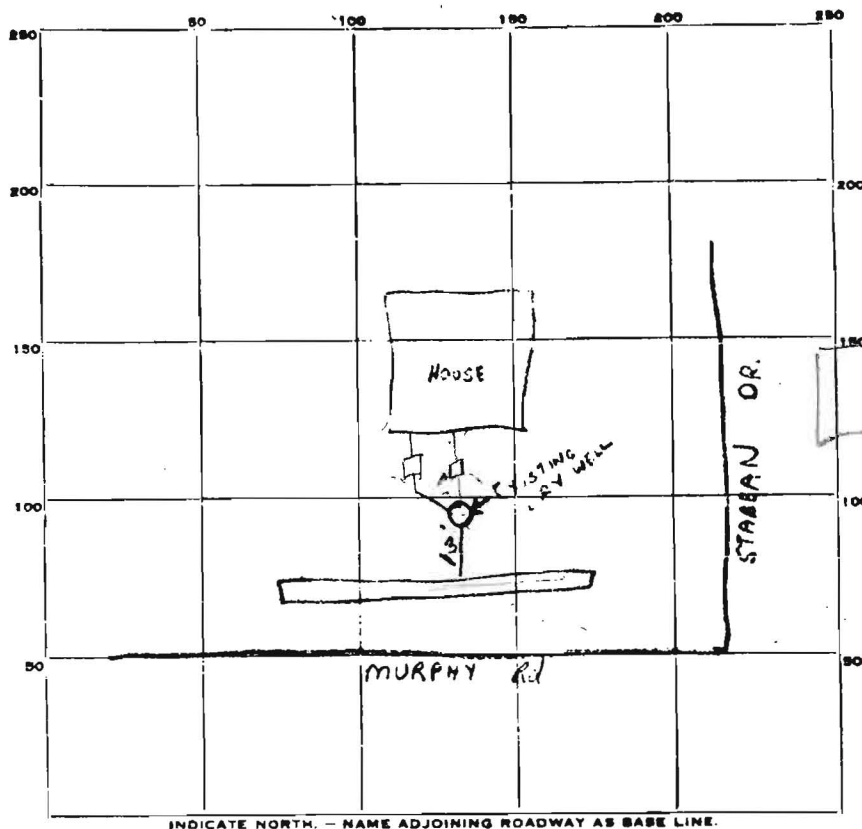

INDICATE NORTH. — NAME ADJOINING ROADWAY AS BASE LINE.

PERMIT CARD _____

SEPTIC TANK, LEVEL _____

CLEANOUTS _____

DISTRIBUTION BOX, LEVEL _____

TILE FIELD, DEPTH 12-13 FT. TRENCH WIDTH 2 FT.GRAVEL DEPTH 7-8 1/2 IN. TOTAL LENGTH 80 FT.NUMBER OF TRENCHES 1 links in old TOTAL BOTTOM AREA 560 sq ft. (one under trench)

SEEPAGE PITS, INSIDE DIAMETER _____ FT. DEPTH BELOW INLET _____ FT.

ABSORBENT AREA _____ SQ. FT.

REMARKS _____

DATE SYSTEM APPROVED 1/28/25INSPECTOR outlet