


Plat of Property known as #8184 Stabean Drive, also known as Lot #3 as shown on Plat of "BEAN PROPERTY" and recorded among the land records of Howard County in Plat Book 8, Folio 94. Subject to Saving & Exceptings as called for in Deed Liber 506, Folio 624.

NOTE: This house is not located in the Flood Plain.

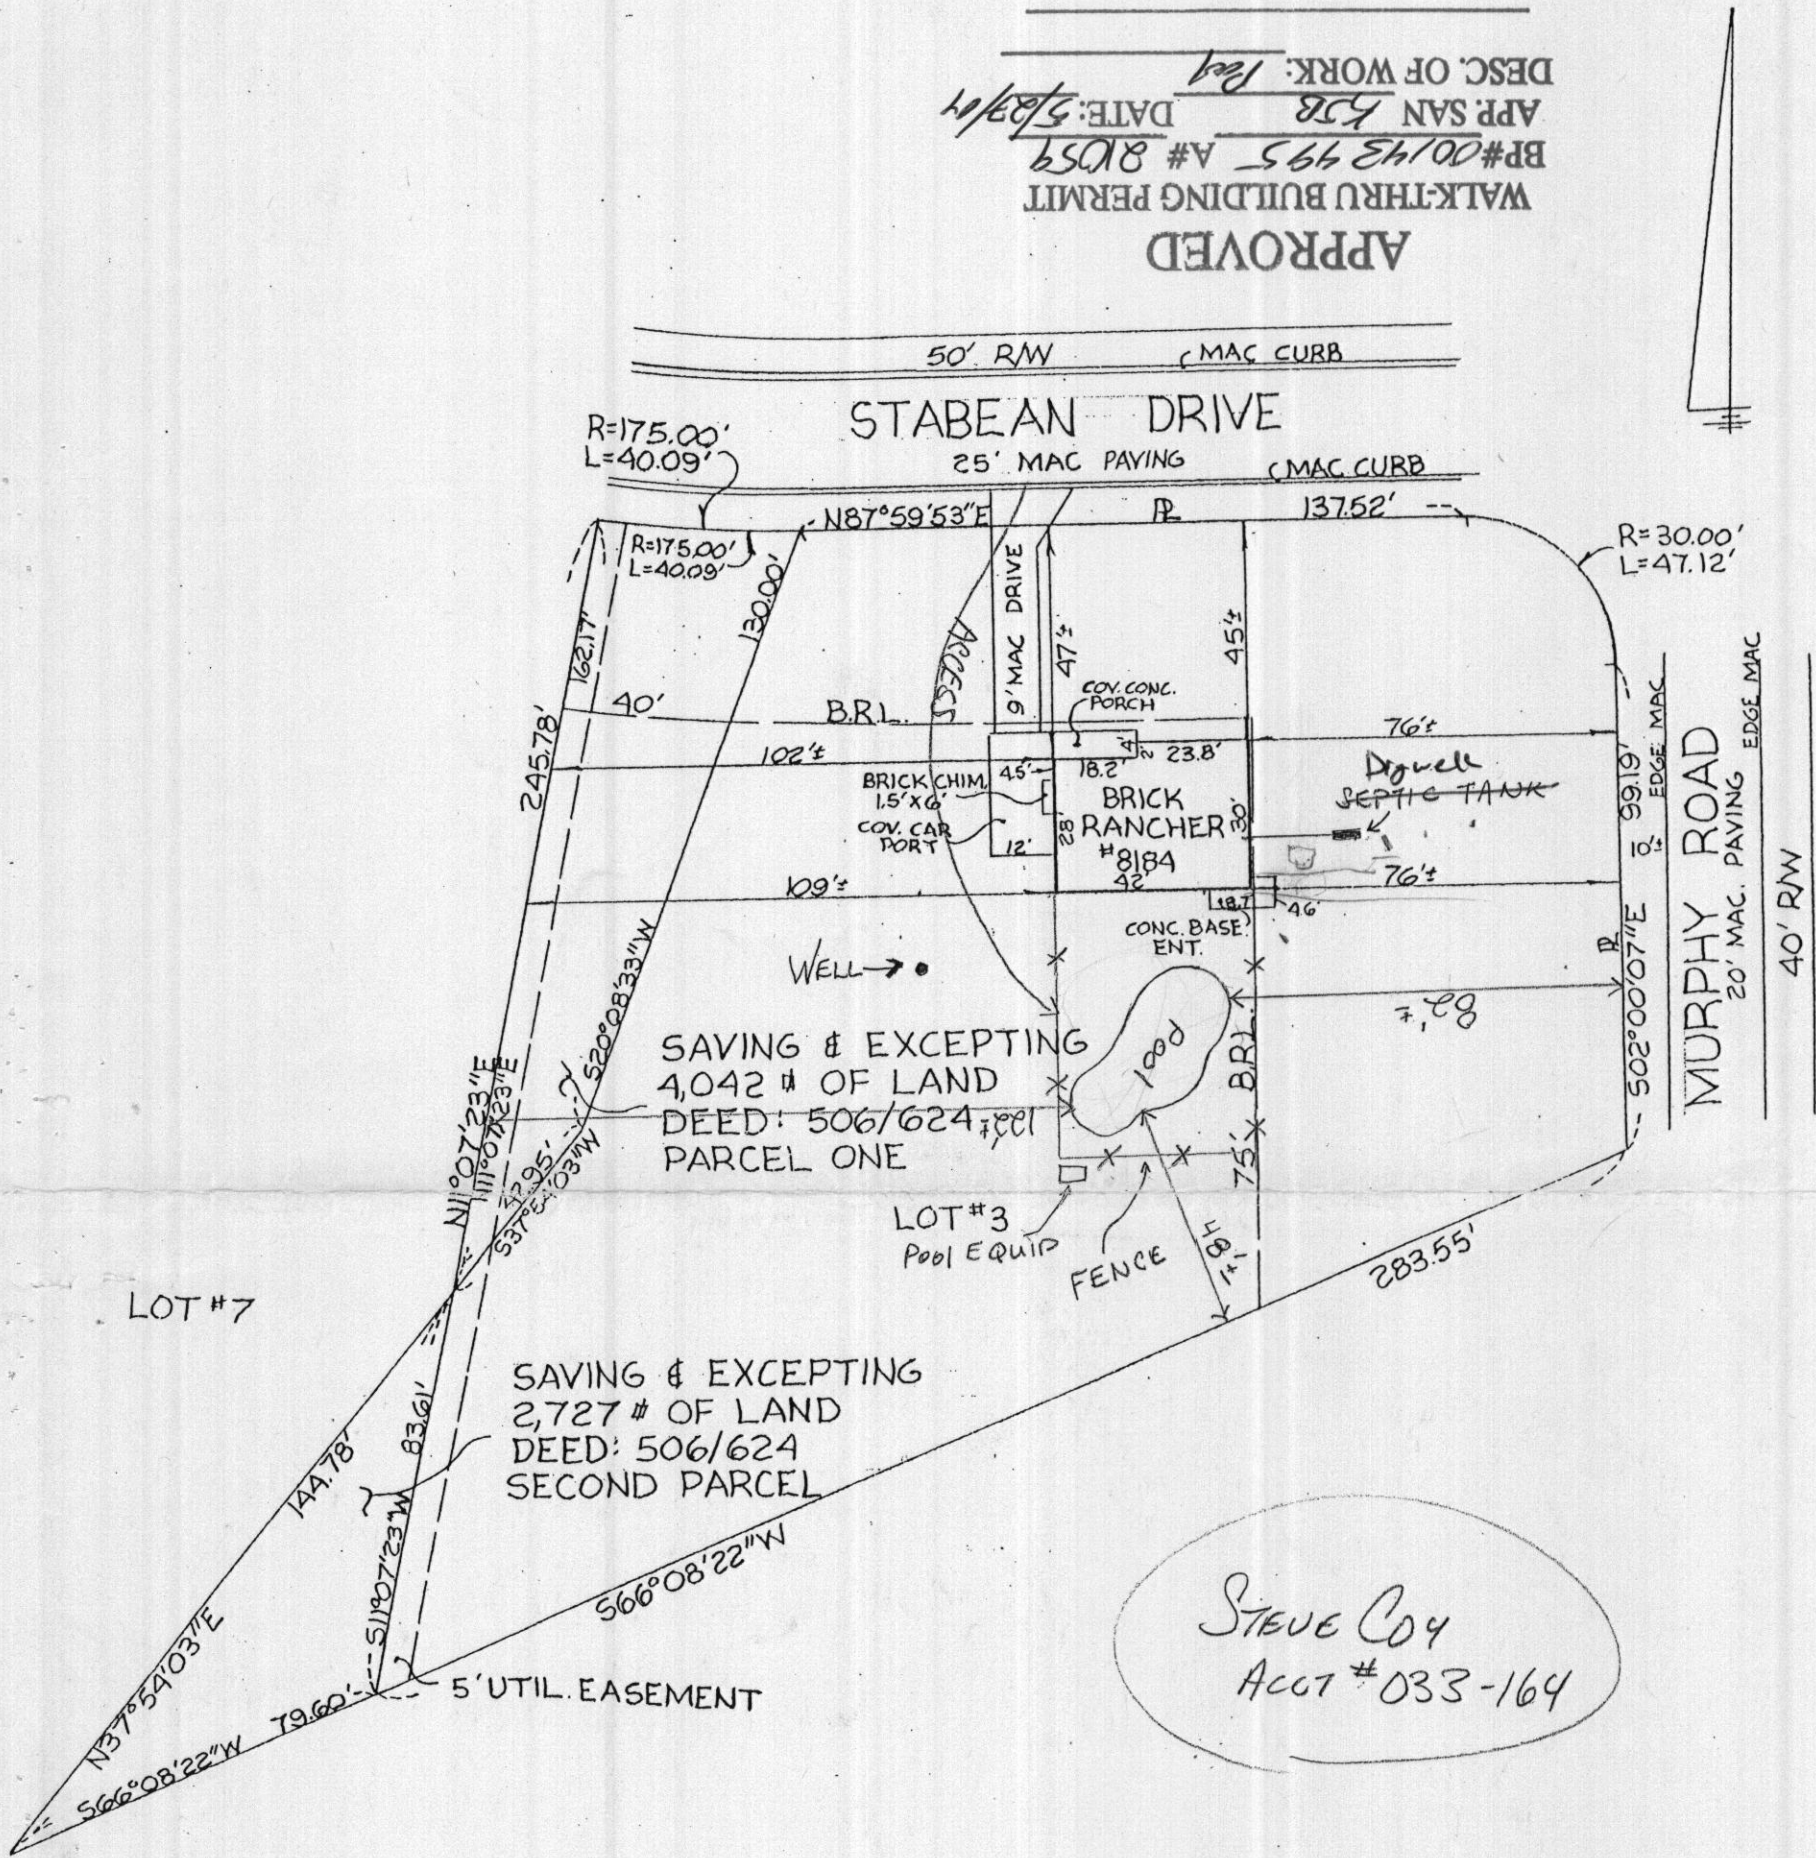

THIS PLAT IS NOT INTENDED FOR THE USE
IN THE ESTABLISHMENT OF PROPERTY LINES

DON LYNCH ASSOC., INC.
4907 HARFORD ROAD
BALTIMORE, MD. 21214

Scale: 1" = 40'

Date: 12/12/86

Sourabh Munshi.

PR 1/6/05
January 5, 2005

KJB
CK 1300
cc 82676
25
1/6/05

Avis L. Corbin, Chief
Licenses & Permits Division
Department of Inspections, Licenses and Permits
George Howard Building
3430 Court House Drive
Ellicott City, MD 21043

Re: Building Permit B00148871 ^A (8184 Stabean Drive, Fulton, MD 20759)

Ms. Corbin,

This letter will service as notice of our request to modify our existing building permit (B00148871) with Howard County as follows:

- 1) Adding a 442 sq. ft. **deck** to the existing house and new addition 42'x4' 27'x4' 23'-10"x6'
- 2) Adding a 16 sq. ft. **bump out bay** to the new addition Irregular Shape
- 3) Adding a 180 sq. ft. concrete slab **front porch**

We have enclosed three sets of drawings of the amendments as well as three drawings of our plat. If you have any questions, please feel free to contact Tim Ebel directly at (301) 641-0424 or the co-owner, Stephen Coy, via email at (scoy@acc.org).

Thank you in advance for your consideration.

Tim Ebel & Stephen Coy
Homeowners
8184 Stabean Drive
Fulton, MD 20759

Approved Septic System Plan
Howard County Health Department
approval

Signature

2/23/05
Date

REVIEWED FOR
CODE COMPLIANCE

DEPARTMENT OF INSPECTIONS,
LICENSING AND PERMITS
HOWARD COUNTY

DATE 1/19/05

BY [Signature]

☐ SUBJECT TO COMMENTS BY LETTER

☒ SUBJECT TO FIELD CODES

☐ SUBJECT TO COMMENTS BY PLANS

☒ SUBMITTANT

amended deck porch / deck & bumpout

FILE INQUIRY FORM

Property Address: 8184 Stabean Dr.

talked w/ homeowner about upgrading their
septic tank to 1250 gal for 4 bed house.
hold on BP until upgrade is complete

7/15/04
(KJB)


7-26-04

KEV TOLD OWNER TO GIVE ELEVATIONS,
Why collapsing S.T.? He could
keep EX. TANK FOR extra storage capacity
TOLD HIM TO ✓ INTEGRITY TO Fill w/ water
measure, & remeasure in 24 hrs
TOLD HIM TO CALL you FOR
Approval (KN)

⊙ New Well
HO 943966

B02148871
OLD B1
SFO 823/04

6/21/04
- proposed addition OK
not adding any new bedrooms.
(KJB)
- waiting for well abandonment
Report.

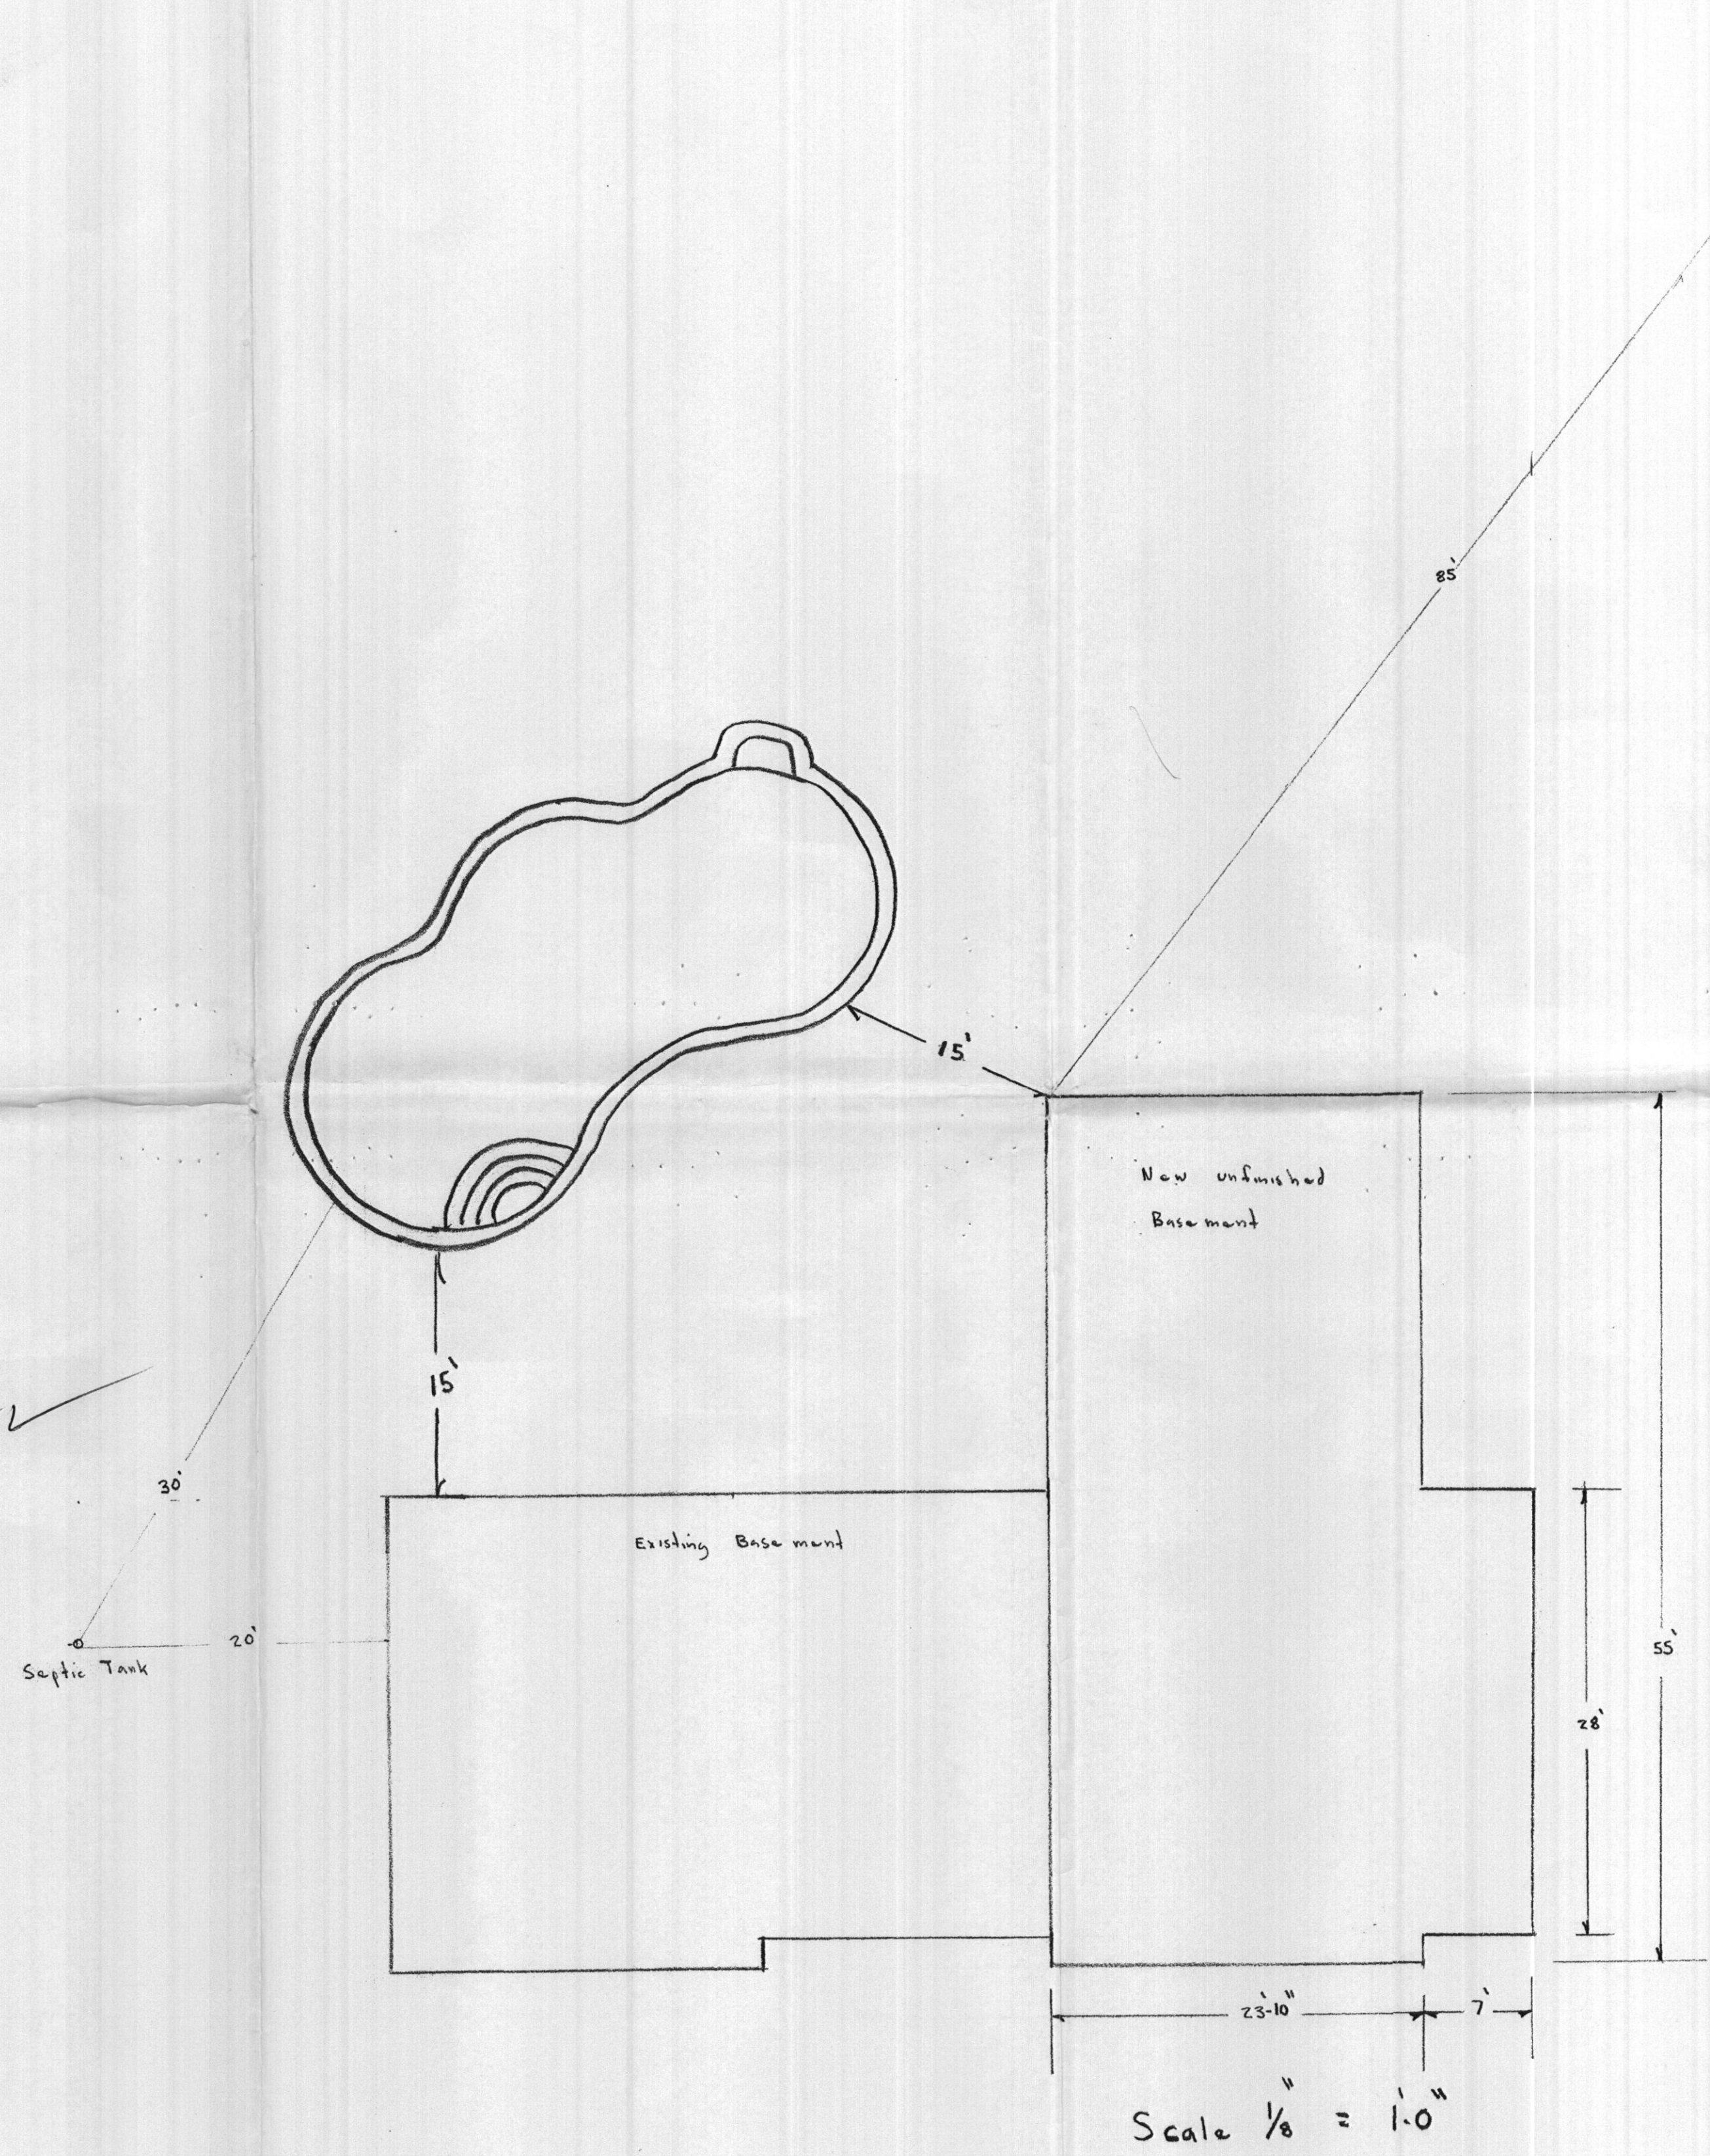

8184 STABE
Fulton MD 20
301-641-0424
- Tim Ebel -