LAYOUT	INSP 4	
INSP 2	INSP 5	Market Control of the
INSP 3	INSP 6	
ISSUE DATE:	DE	P 521759
APPROVAL DATE:		DEXED A
ľ	HOWARD COUNTY	E DISPOSAL SYSTEM HEALTH DEPARTMENT RONMENTAL HEALTH
		IS PERMITTED TO INSTALL ⊠ ALTER □
ADDRESS:	1996	PHONE NUMBER:
SUBDIVISION: D	OGWOOD	LOT NUMBER: 12, 13
ADDRESS: 68181	REDBERRY ROAD	PROPERTY OWNER: WILLIAM DILDAY
SEPTIC TANK CAPACITY (GALLONS):		OUTLET BAFFLE FILTER REQUIRED
PUMP CHAMBER C.	APACITY (GALLONS):	COMPARTMENTED TANK REQUIRED
NUMBER OF BEDRO	OOMS:	
SQUARE FEET PER	BEDROOM:	
LINEAR FEET OF TI	RENCH REQUIRED:	
TRENCHES:		nlet feet below original grade. Bottom maximum depth Effective area begins at feet below original grade. feet of pe.
LOCATION:		
10		
NOTES:		
PLANS APPROVED:		DATE:
NOTE: PERMIT VOID AFTE NOTE: CONTRACTOR RESI NOTE: WATERTIGHT SEPT	PONSIBLE FOR SCHEDULING A PRE	-CONSTRUCTION INSPECTION FOR ALL INSTALLATIONS

NOTE: ALL PARTS OF SEPTIC SYSTEM SHALL BE 100 FEET FROM ANY WATER WELL NOTE: MANHOLE RISERS REQUIRED ON ALL SEPTIC TANKS AND PUMP CHAMBERS UNLESS SPECIFICALLY AUTHORIZED

NEITHER THE HOWARD COUNTY COUNCIL NOR THE HEALTH DEPARTMENT IS RESPONSIBLE FOR THE SUCCESSFUL OPERATION OF ANY SYSTEM PERMITTEE RESPONSIBLE FOR OBTAINING FINAL APPROVAL ON THIS PERMIT CALL 410-313-2640 FOR INSPECTION OF SEPTIC SYSTEM

1/22/15

PERMIT

SEWAGE DISPOSAL SYSTEM

P_2/759_

MARYLAND STATE DEPARTMENT OF HEALTH

HOWARD COUNTY

SUCCESSFUL OPERATION OF ANY SYSTEM

INDEXED


ELLICOTT CITY
DISTRICT 5th

DATE 7/3/75

landPHONE286-2140
ROAD 6818 Redberry Lane LOT off Holl Sup Pat -11' Att. 32
of Hall Sup Fdr. NV. 32
, Md. Phone: 286-2258
ET. BOTTOM AREA 5Q. FT.
DE WALL AREASQ FT.
GALLONS
DISPOSAL AREA 22% & TANK CAPACITY 50%.
hen ground is opened up so Sanitarian
75 TILE FIELD OFF OLD
APER HILL STO DEL
· c
7/3/75

NEITHER THE HÖWARD COUNTY COMMISSIONERS NOR THE HEALTH DEPARTMENT IS RESPONSIBLE FOR THE

J 3175

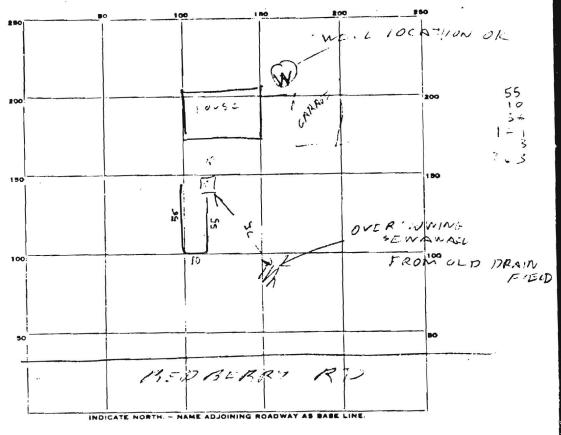

PERMIT CARD	2
SEPTIC TANK, LEVEL CLEANOUTS	
DISTRIBUTION BOX, LEVEL	
TILE FIELD, DEPTH 3 4-5 L FT. TRENCH WIDTH 3 FT.	フ
GRAVEL DEPTH 1? IN. TOTAL LENGTH 121 FT.	3)360
NUMBER OF TRENCHES TOTAL BOTTOM AREA 363	, , ,
SEEPAGE PITS, INSIDE DIAMETERFT. DEPTH BELOW INLETFT.	21-11
ABSORBENT AREASQ. FT.	a /
REMARKS 7/22/75 755 AM - HULE NOUS NEX 10 TANK 10	4 FT WEER
NATUR COMES IN 9FT ALLSANDY & WICE OLD	SYSTEM 13
7 LU FICOD IN USE 14 YILS OLD 7/22/75 230841	MAIN
V1660 2257 016212	
DATE SYSTEM APPROVED AT TELESCORE	1.