


10-21-04
Plan to
scale

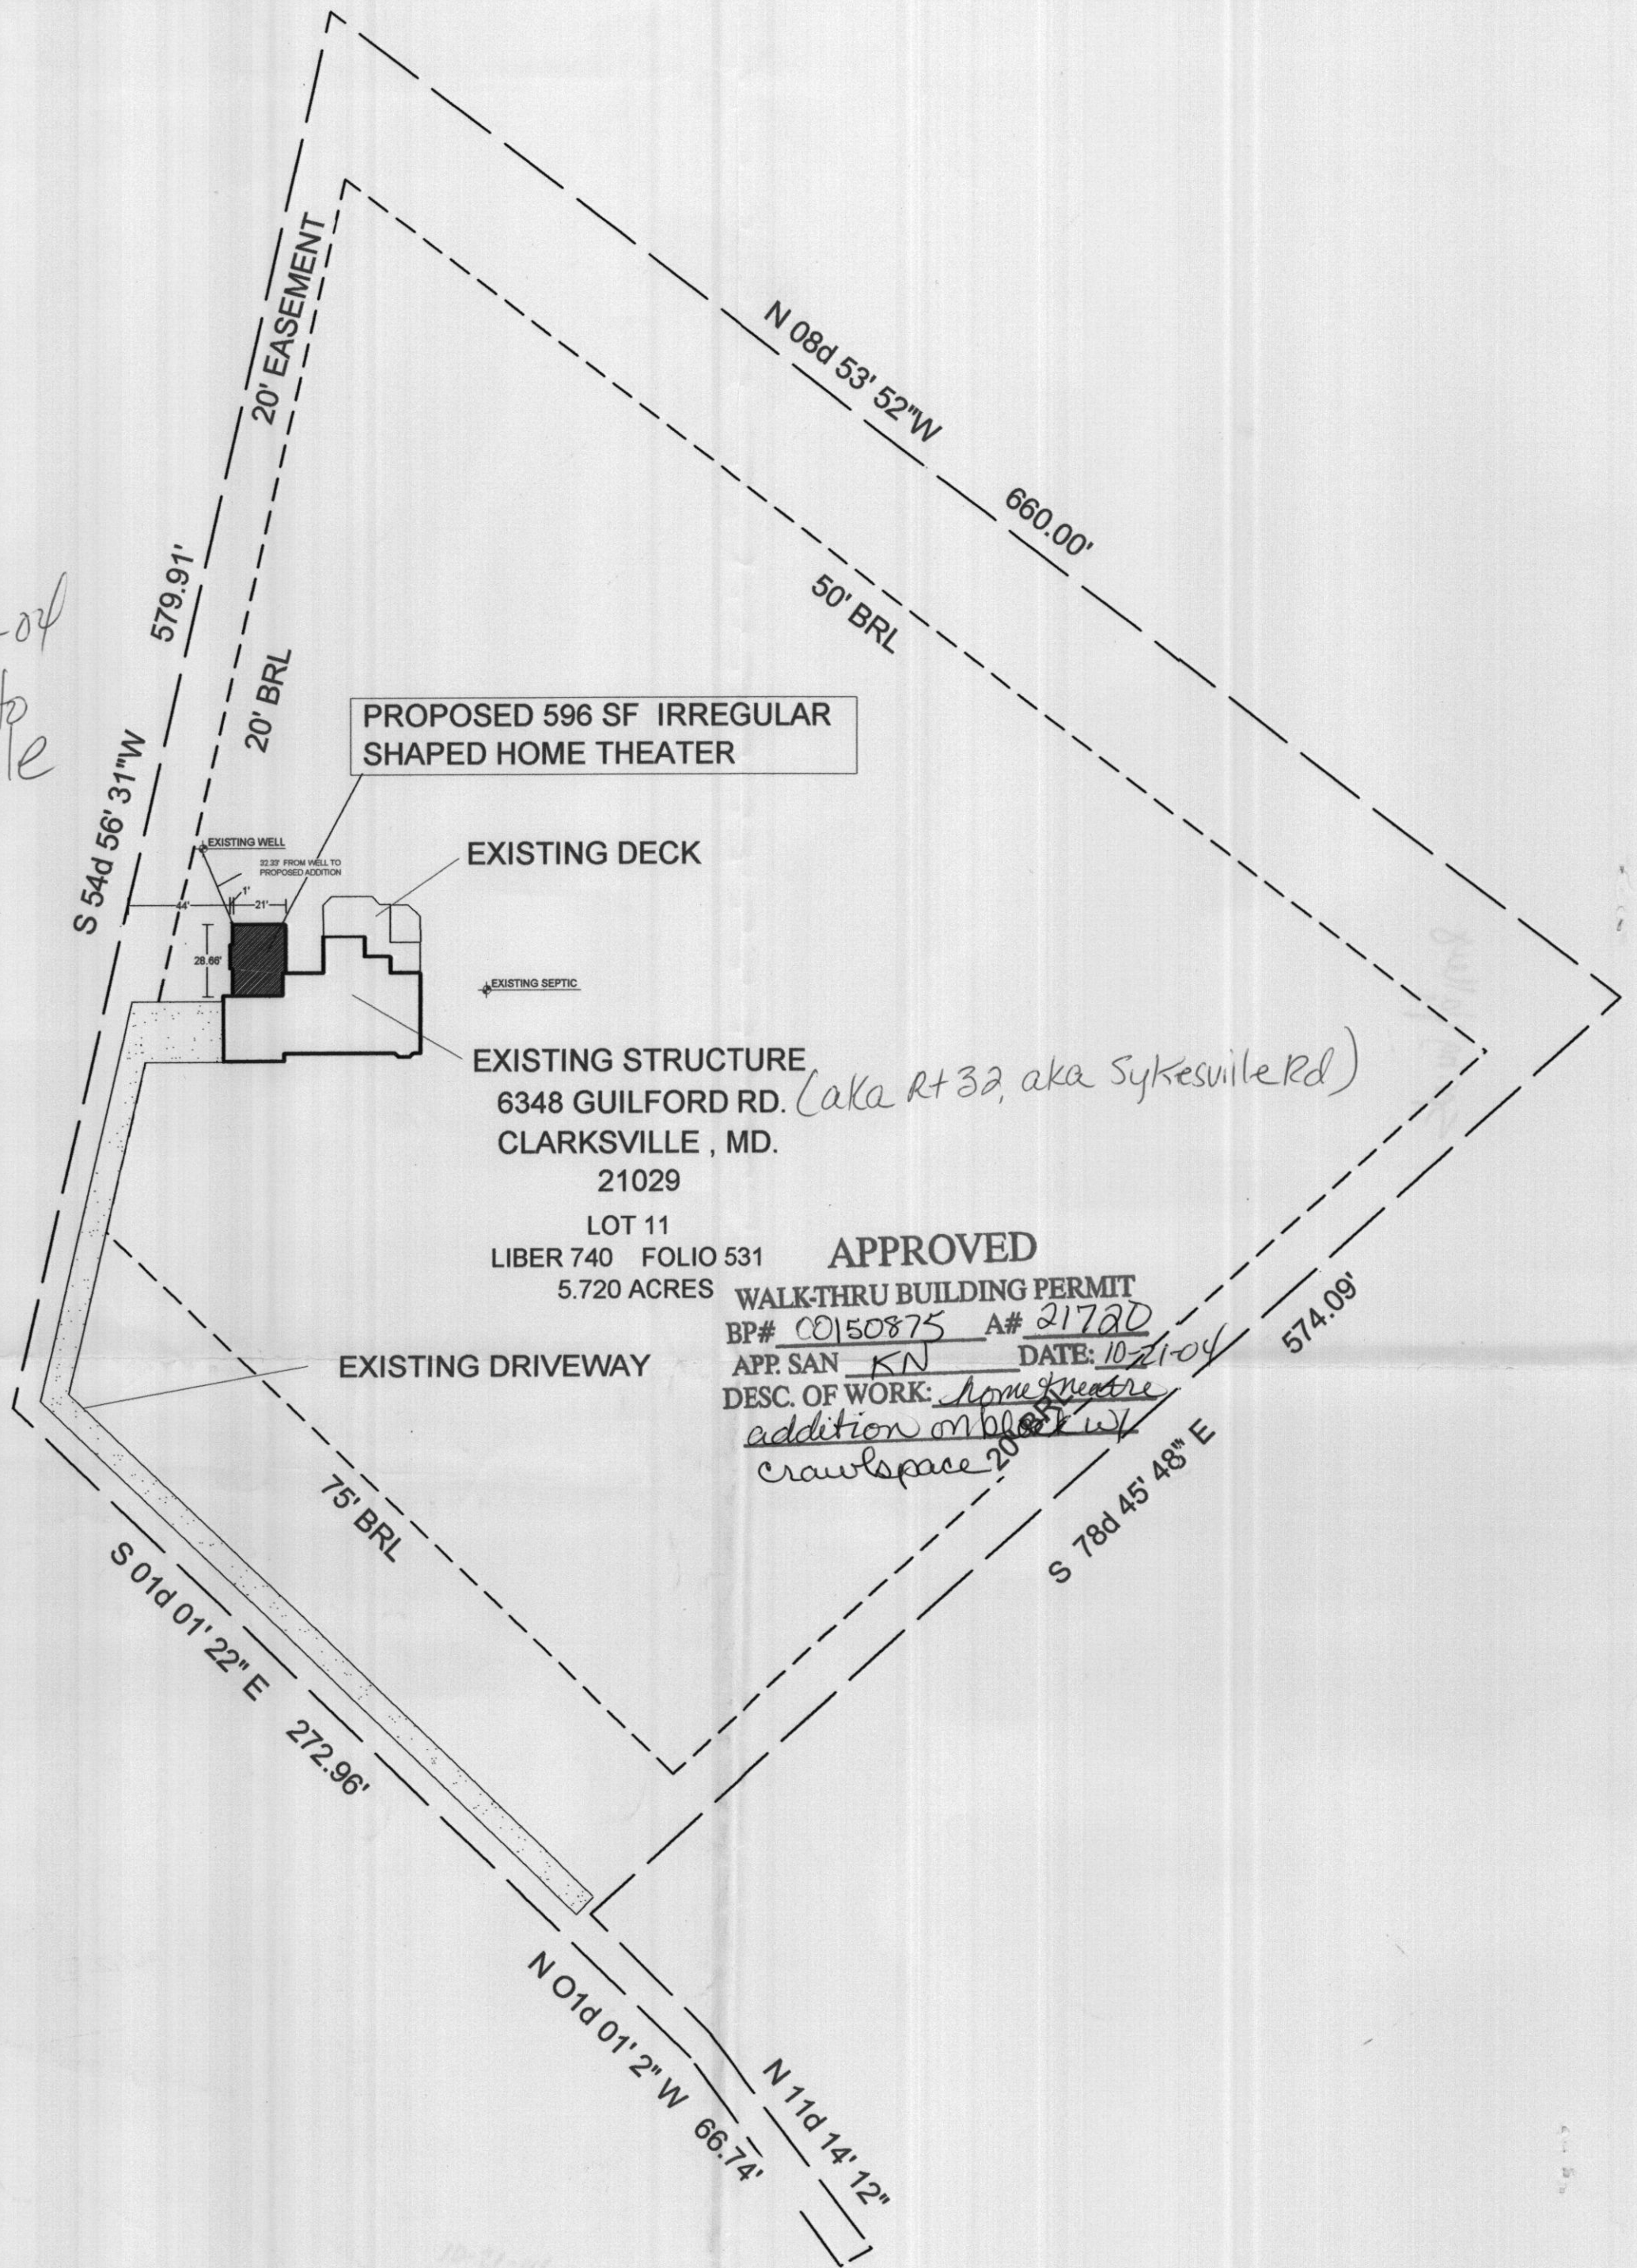

PLAT PLAN 1" = 60'

3/16" = 1'-0"

REVISED
10/07/04

9/13/04

The Baywood Design/Build Group, Inc.
5550 Sterrett Place Suite 100
Columbia, MD 21044
410.995.6363 Fax 410.992.3211

TURNER
ADDITION

COPYRIGHT 2004
THE BAYWOOD DESIGN/BUILD GROUP, INC.
ALL RIGHTS RESERVED
No use or intended use
without expressed written approval