

11/17/76 file wt.

PERMIT

SEWAGE DISPOSAL SYSTEM

MARYLAND STATE DEPARTMENT OF HEALTH

HOWARD COUNTY

INDEXED

ELLICOTT CITY

DISTRICT 5th

DATE 7/30/76

P 23629

A 21720

521720

Robert L. Turner

IS PERMITTED TO INSTALL ☒ ALTER

ADDRESS 4416 Greenwood Road, Beltsville, Md. 20705

PHONE 572-4958

A SEWAGE DISPOSAL SYSTEM LOCATED AT

SUBDIVISION SPRING VALLEY FARMS

ROAD 6348 Rt. 32 Clarksville LOT 11 Par. 327

PROPERTY OWNER Robert L. Turner

ADDRESS

SPECIFICATIONS 3 Bedroom

DRAIN FIELD DEPTH FEET, BOTTOM AREA SQ. FT.

SEEPAGE PITS ABSORBENT SIDE WALL AREA SQ. FT.

SEPTIC TANK CAPACITY 1000 GALLONS

FOR GARBAGE GRINDER, INCREASE DISPOSAL AREA 22% & TANK CAPACITY 50%.

OTHER DRY WELL: 125 sq. ft. effective absorbent sidewall area per bedroom below the first & 3 1/2 ft. of non-absorbent soil at original grade. Maximum depth of DW to be 11 1/2. Locate drywell 190 ft. from right lot line and 175 ft. from the edge of the right of way, as seen when facing lot from right of way.

PERMIT VOID AFTER 3 YEARS.

NOTE: ALL PIPE FROM HOUSE TO DISPOSAL AREA MUST CAST IRON.

NOTE: INSTALL STAND PIPE ON SEPTIC TANK AND DRY WELL. STAND PIPE MUST BE 6 INCHES IN DIAMETER, CAST IRON, CONCRETE, OR TERRA COTTA ACCEPTABLE

PLANS APPROVED BY William W. Zepp

DATE 7/8/75


FILL SEPTIC TANK AND DISTRIBUTION BOX WITH WATER BEFORE CALLING FOR AN INSPECTION. COVER NO WORK UNTIL INSPECTED AND APPROVED.

NEITHER THE HOWARD COUNTY COMMISSIONERS NOR THE HEALTH DEPARTMENT IS RESPONSIBLE FOR THE SUCCESSFUL OPERATION OF ANY SYSTEM.

A 521720

TAX ID # 05-357055
TAX MAP 34 PARCEL 327

A 21720

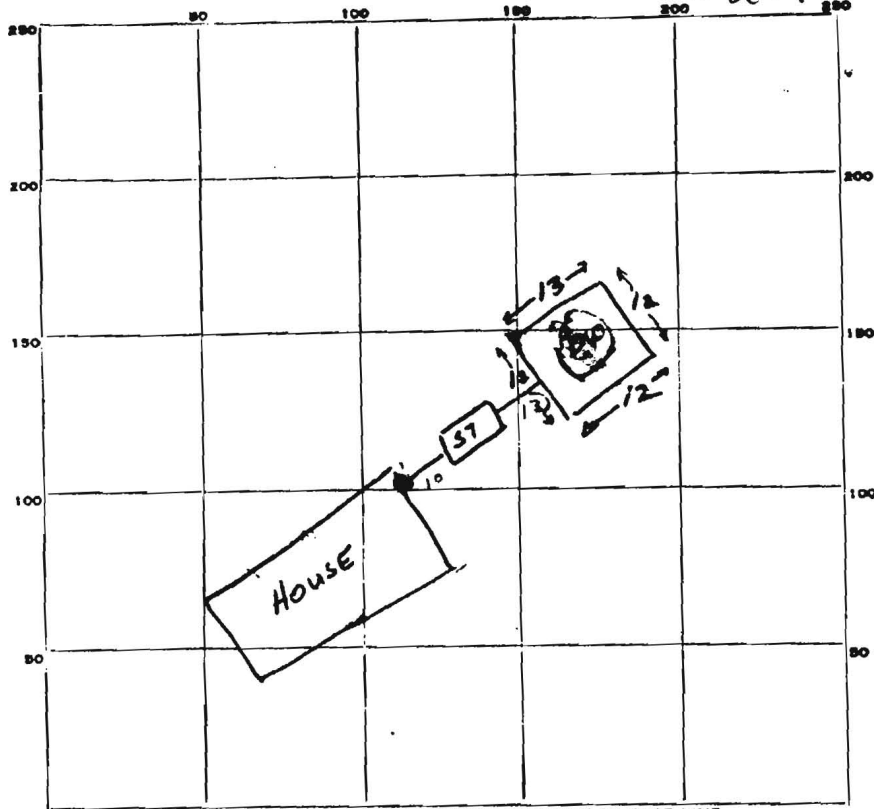

INDICATE NORTH. - NAME ADJOINING ROADWAY AS BASE LINE.

PERMIT CARD ☒

RoW

to ROUTE 32

SEPTIC TANK, LEVEL 1000 gal ☒

CLEANOUTS

ST | DW

DISTRIBUTION BOX, LEVEL

TILE FIELD, DEPTH _____ FT. TRENCH WIDTH _____ FT.

419

GRAVEL DEPTH _____ IN. TOTAL LENGTH _____ FT.

8

392

NUMBER OF TRENCHES _____ TOTAL BOTTOM AREA _____

SEEPAGE PITS, outside perimeter 49 FT. DEPTH BELOW INLET 8 1/2 FT.

8' effective

ABSORBENT AREA 392 SQ. FT.

REMARKS 12/16/76 DW is 12' deep w inlet @ 3 1/2'

DATE SYSTEM APPROVED 12/16/76

INSPECTOR Phillip H. Jupp