

APPLICATION

A 21720

P _____

SEWAGE DISPOSAL TESTING

STATE OF MARYLAND · DEPARTMENT OF HEALTH AND MENTAL HYGIENE

HOWARD COUNTY HEALTH DEPARTMENT
ENVIRONMENTAL HEALTH SERVICES
P. O. BOX 475, ELLICOTT CITY, MARYLAND 21043
TELEPHONE 465-5000, EXT. 336

DISTRICT 5

DATE 6/25/75

TO THE COUNTY HEALTH OFFICER
ELLICOTT CITY, MARYLAND

I, HEREBY, APPLY FOR THE NECESSARY TEST IN ORDER TO CONSTRUCT (OR RECONSTRUCT) A SEWAGE DISPOSAL SYSTEM

PROPERTY OWNER Robert E. Turner

ADDRESS 4416 Greenwood Road, Beltsville, Md. 20705 PHONE Any questions call:
John Schneider
465-7777

937-4436

PROPERTY LOCATION

SUBDIVISION (Spring Valley Farms) LOT NO 11

ROAD AND DESCRIPTION 441 St. 32

SIZE OF LOT 5.74 acres TYPE BLDG. 3 or 4

NUMBER OF BEDROOMS
(Single Only. Dblg.)

IF NOT SINGLE RESIDENCE DESCRIBE _____

THE SYSTEM INSTALLED UNDER THIS APPLICATION IS ACCEPTABLE ONLY UNTIL PUBLIC FACILITIES BECOME AVAILABLE.

SIGNATURE OF APPLICANT /s/ John Schneider

APPROVED BY _____ FOR _____ DATE _____

(KIND OF SYSTEM)

REJECTED BY _____ FOR _____ DATE _____

(KIND OF SYSTEM)

HOLD PENDING FURTHER TESTS _____ DATE _____

REASONS FOR REJECTION OR HOLDING _____

THIS IS NOT A PERMIT


798-1
12-20

5.720 acres

Holds 29-11
are in 2021
2021-

Turner
Spring Valley
lot 11

BP 47253
Jul 81 - shed

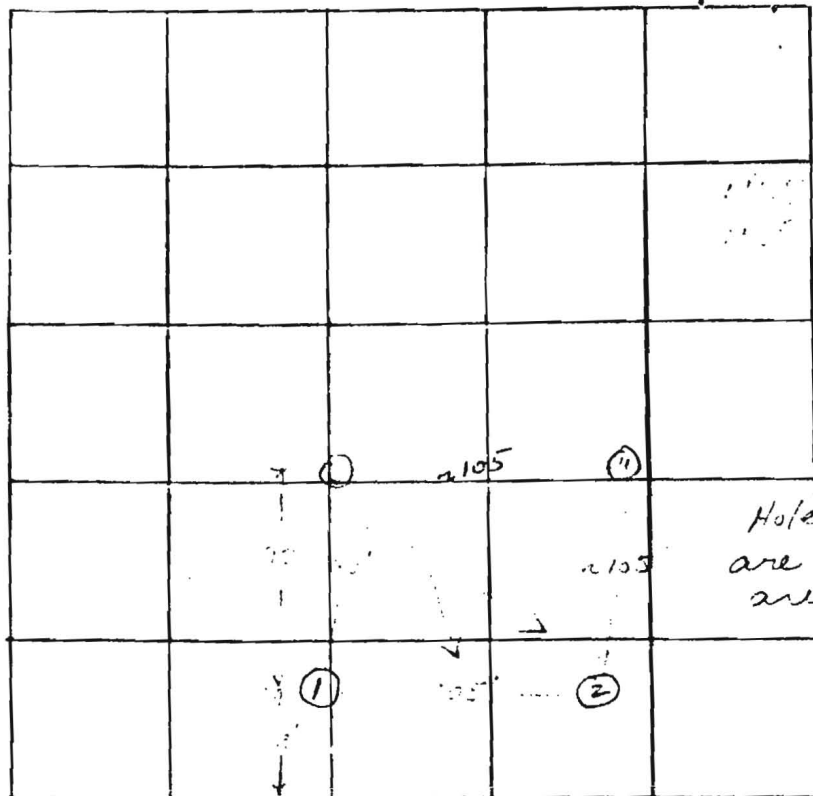

INDICATE NORTH - NAME ADJOINING ROADWAY AS BASE LINE

K. O. N.

BASE LINE Culvert under road

DATE	TEST NO	DEPTH	PRF. WET		TEST - 1" DROP		TIME
			START	STOP	START	STOP	
20/75	1	4 1/2	9:56	1:57	9:52	9:59	2
	1-A	12	9:55	9:38	9:58	1:02	4
	2	5	10:16	10:19	10:19	10:23	9
	2-A	11	10:33	10:37	10:37	10:45	8
	2-B	13	11:06				
	3	4	10:51	10:52	10:52	10:54	2
	3	12 1/2	10:51	10:52	10:52	10:55	3
	4	12	11:01	1	11:01	11:01	

$$\bar{f} = \leq y_{\min}$$

REMARKS

TYPE OF SOIL

TESTED BY

ALSO PRESENT: