

LAYOUT _____ INSP 4 _____
INSP 2 12/23/04-AM INSP 5 _____
INSP 3 _____ INSP 6 _____

ISSUE DATE: 12/10/2004

APPROVAL DATE: 12/21/04

PERMIT
INDEXED

P 521613

A 50619-J

TAX ID # 04-359704

ON-SITE SEWAGE DISPOSAL SYSTEM
HOWARD COUNTY HEALTH DEPARTMENT
BUREAU OF ENVIRONMENTAL HEALTH
3525-H ELLICOTT MILLS DRIVE, ELLICOTT CITY, MD 21043

Level Land, Inc. IS PERMITTED TO INSTALL ☒ ALTER ☐

ADDRESS: PO Box 100, Lisbon, MD 21765 PHONE NUMBER: 443-677-0627

SUBDIVISION: Holly Hills 15

ADDRESS: ³³²⁶~~3226~~ Sang Road PROPERTY OWNER: Patuxent Builders, Inc.

SEPTIC TANK CAPACITY (GALLONS): 1250 OUTLET BAFFLE FILTER REQUIRED ☐

PUMP CHAMBER CAPACITY (GALLONS): N/A COMPARTMENTED TANK REQUIRED ☐

NUMBER OF BEDROOMS: 4

SQUARE FEET PER BEDROOM: 180

LINEAR FEET OF TRENCH REQUIRED: 200 HOUSE SERVED BY PUBLIC WATER ☐

TRENCHES:	Trench to be 3.0 feet wide. Inlet 4.0 feet below original grade. Bottom maximum depth 6.0 feet below original grade. Effective area begins at 5.0 feet below original grade. 2.0 feet of stone below distribution pipe.
LOCATION:	Place the distribution box as shown on the approved building permit plan.
NOTES:	

PLANS APPROVED: Frank Alfonso  DATE: 4/15/04

NOTES: PERMIT VOID AFTER 2 YEARS

CONTRACTOR IS RESPONSIBLE FOR SCHEDULING A PRE-CONSTRUCTION INSPECTION FOR ALL INSTALLATIONS

WATERTIGHT SEPTIC TANKS REQUIRED


ALL PARTS OF SEPTIC SYSTEM SHALL BE 100 FEET FROM ANY WATER WELL UNLESS SPECIFICALLY AUTHORIZED

MANHOLE RISERS REQUIRED ON ALL SEPTIC TANKS AND PUMP CHAMBERS UNLESS SPECIFICALLY AUTHORIZED

CONTRACTOR RESPONSIBLE FOR COMPLIANCE WITH APPLICABLE REGULATIONS, GUIDELINES AND THE TERMS OF THIS PERMIT

**NEITHER THE HOWARD COUNTY COUNCIL OR THE HEALTH DEPARTMENT IS
RESPONSIBLE FOR THE SUCCESSFUL OPERATION OF ANY SYSTEM
PERMITTEE RESPONSIBLE FOR OBTAINING FINAL APPROVAL ON THIS PERMIT
CALL 410-313-2640 FOR INSPECTION OF SEPTIC SYSTEM
DO NOT LEAVE ANY REQUEST FOR INSPECTION ON VOICEMAIL**

P521613

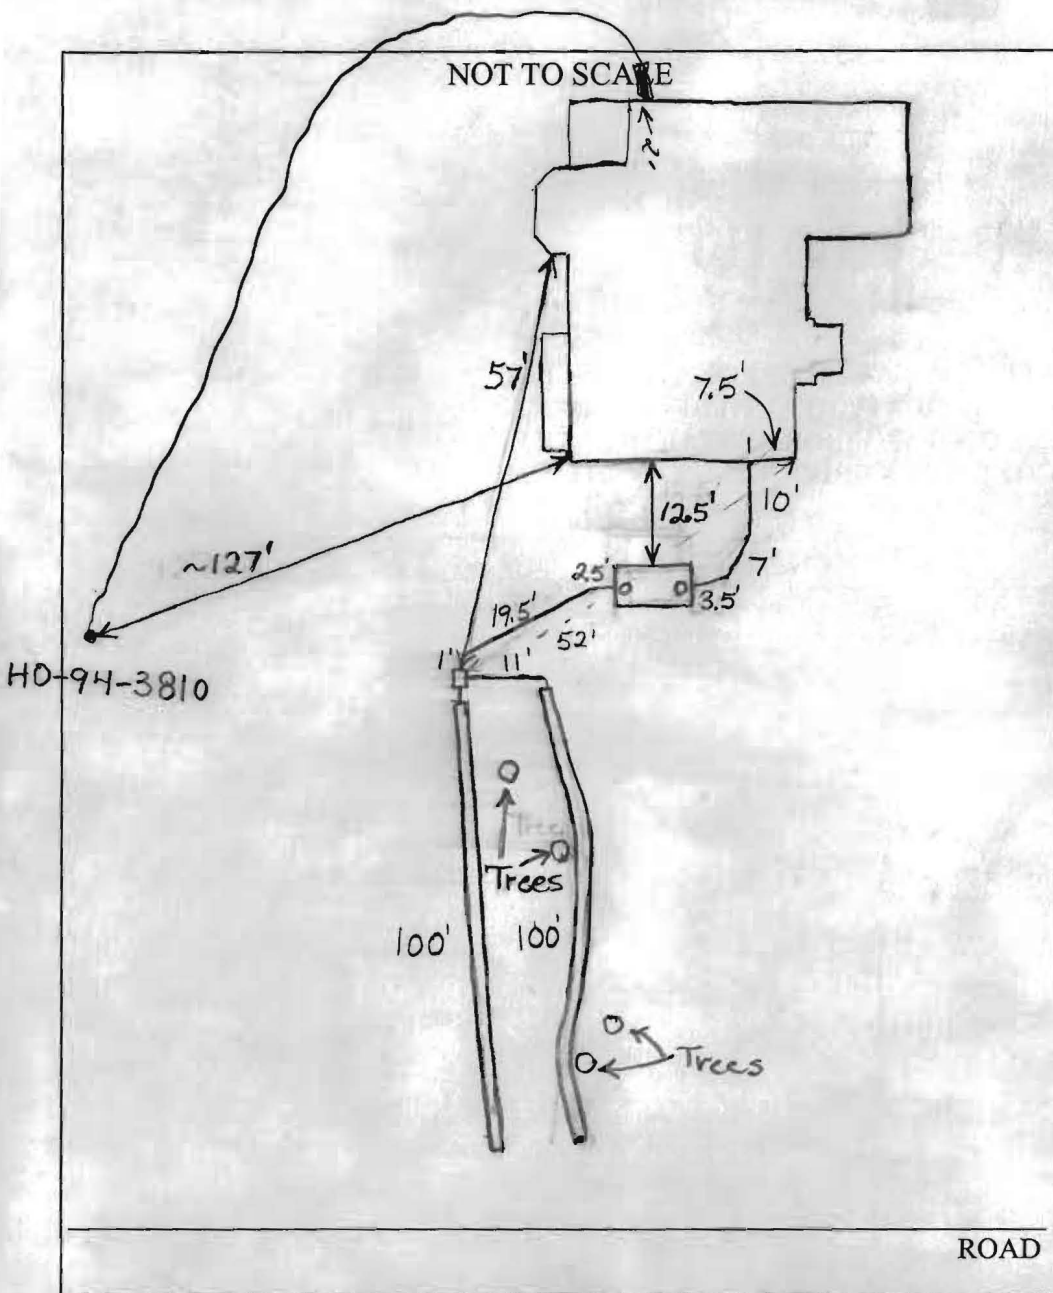


TRENCH/DRAINFIELD DATA		
WIDTH	INLET	BOTTOM
3'	4'	6'
NUMBER OF TRENCHES 2		
TOTAL LENGTH 200'		
ABSORPTION AREA 600+Sidewall		
DISTRIBUTION BOX LEVEL Yes		
DISTRIBUTION BOX BAFFLE Yes		
DISTRIBUTION BOX PORT No		

SEPTIC TANK DATA		
SEPTIC TANK 1 LEVEL		
2-Comp.	CAPACITY 1500	GAL
	SEAM LOC Top	
	TANK LID DEPTH ~1'	
	BAFFLES Yes	
	BAFFLE FILTER No	
	MANHOLE LOC None	
	6" PORT LOC Front+Rear	
	WATERTIGHT TEST No	
SEPTIC TANK 2 LEVEL N/A		
	CAPACITY	GAL
	SEAM LOC	
	TANK LID DEPTH	
	BAFFLES	
	BAFFLE FILTER	
	MANHOLE LOC	
	6" PORT LOC	
	WATERTIGHT TEST	

PRE-CONSTRUCTION 12/20/04 Tank set. Install 2 - 100' trenches at the top of the septic easement. Work around trees as best possible to conserve area. (BB)

INSTALLATION 12/21/04 Trenches dug to avoid trees. O.K. to cover everything. (BB)

FINAL INSPECTOR B. Baker DATE OF APPROVAL 12/21/04

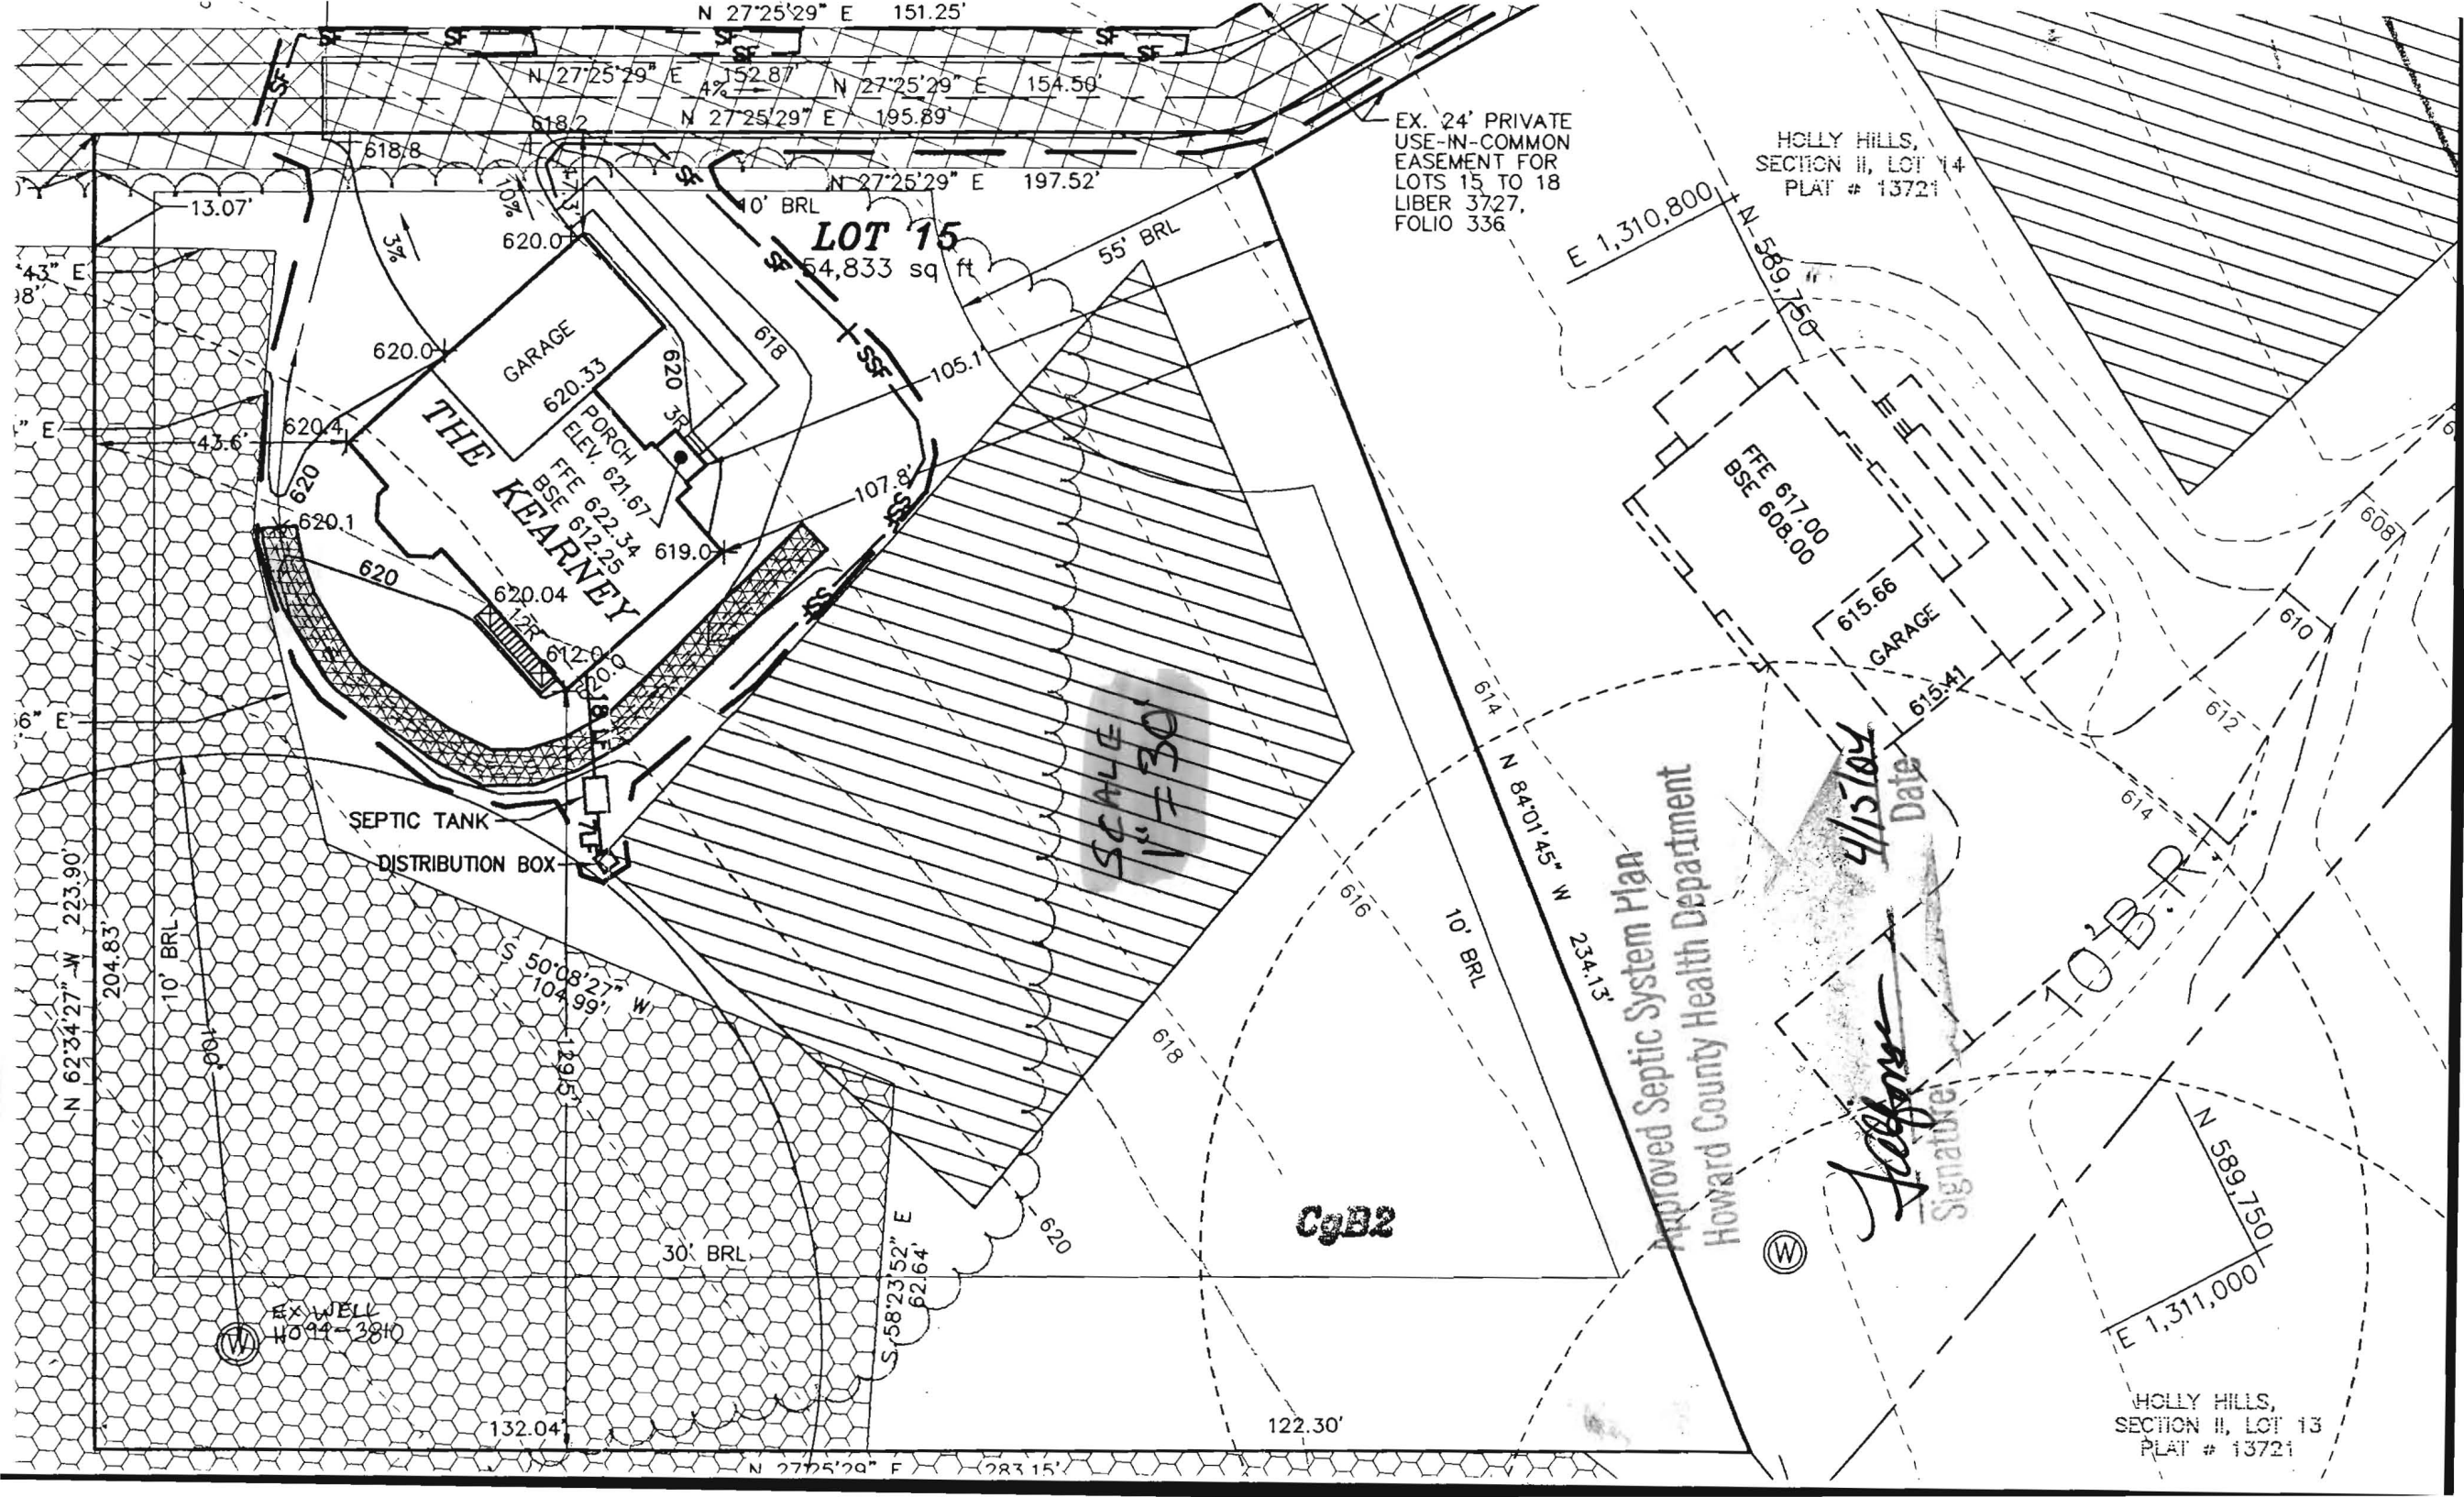

SANG ROAD

EX. 10' TREE
MAINT. EASE.

R=450.00' L=6.00'

HOLLY HILLS,
SECTION II, LOT 14
PLAT NO. 12602

N 02°55'43" W 214.73'
PRIVATE USE-IN-COMMON
EASEMENT FOR LOTS 15 TO 18

N 84°01'45" W

234.13'

LOT 15
54,833 S.F.

SEPTIC AREA

LOT 15

PLAT OF REVISION

HOLLY HILLS SECTION 2

LOTS 14 THRU 22 LOTS 15 THROUGH 18

A RESUBDIVISION OF OPEN SPACE LOT 23 &
& PRESERVATION PARCEL A

PLAT NO. 13721

ELECTION DISTRICT No. 4

HOWARD COUNTY, MARYLAND


TOP OF WALL ELEV.= 621.7

ADDRESS: 3326 SANG ROAD

THE INFORMATION SHOWN HAS BEEN ESTABLISHED BY CURRENT
ACCEPTABLE SURVEY PROCEDURES AND FROM AVAILABLE RECORD
INFORMATION. THIS DRAWING IS TO BE USED FOR TITLE TRANSFER
FINANCING, OR REFINANCING ONLY AND IS NOT TO BE USED FOR
THE ESTABLISHMENT OF PROPERTY LINES, LOCATION OF FENCES,
GARAGES, BUILDINGS, OR OTHER EXISTING OR FUTURE IMPROVEMENTS.

**MILDENBERG
BOENDER, & ASSOC., INC.**

Engineers Planners Surveyors
5072 Dorsey Hall Drive, Suite 202, Ellicott City, Maryland 21042
(410) 997-0296 Balt. (301) 621-5521 Wash. (410) 997-0298 Fax.

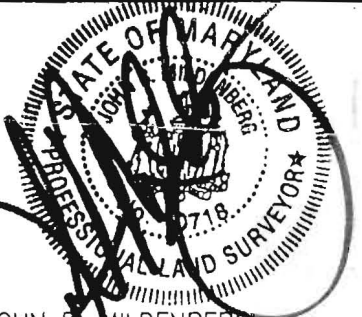

JOHN B. MILDENBERG
PROF. LAND SURVEYOR
MARYLAND No. 10718

FOUNDATION

DATE:

07/07/04

FINAL

DATE:

DRAWN BY:

MES

SCALE:

1"= 50'

PROJECT NO.:

04-023

LOCATION DRAWING