

APPLICATION

PERCOLATION TESTING

A 50619

P _____

HOWARD COUNTY HEALTH DEPARTMENT

BUREAU OF ENVIRONMENTAL HEALTH

3525-H ELLICOTT MILLS DRIVE/ELLICOTT CITY, MARYLAND 21043

TELEPHONE: 313-2640

DISTRICT _____

DATE 9-29-95

TO: THE COUNTY HEALTH OFFICER
ELLICOTT CITY, MARYLAND

I HEREBY APPLY FOR THE NECESSARY TEST PRIOR TO APPLICATION FOR PERMIT TO CONSTRUCT (OR RECONSTRUCT) A SEWAGE DISPOSAL SYSTEM.

PROPERTY OWNER WAYNE NEWSOME

ADDRESS P.O. BOX 39, COLUMBIA, MD 21045 PHONE (410) 792-2100

AGENT OR PROSPECTIVE BUYER _____

ADDRESS _____ PHONE _____

PROPERTY LOCATION:

SUBDIVISION HOLLY HILLS ESTATES LOT NO. 4 ^{ORIGINAL LOT 15} ~~NEW LOT 8~~

ROAD AND DESCRIPTION PROPERTY HAS APPROX. 75' OF FRONTAGE ON BURNWOODS ROAD - 21 LOT (17 NEW SFD'S) SUBDIVISION EXTENSION OF SANG ROAD

TAX MAP 14 PARCEL # 92

SIZE OF LOT LOT 8 : 40,093 SQ FT TYPE BLDG. SFD
(SINGLE FAMILY DWELLING OR COMMERCIAL)

THE SYSTEM INSTALLED UNDER THIS APPLICATION IS ACCEPTABLE ONLY UNTIL PUBLIC FACILITIES BECOME AVAILABLE. I FULLY UNDERSTAND THE FEE CONNECTED WITH THE FILING OF THIS PERC TEST APPLICATION IS NON-REFUNDABLE UNDER ANY CIRCUMSTANCES. I ALSO AGREE TO COMPLY WITH ALL M.O.S.H.A. REQUIREMENTS IN TESTING THIS LOT.

Stephanie Demchuk
(SIGNATURE OF APPLICANT)

APPROVED BY _____ FOR _____ DATE _____

APPROVED BY _____ FOR _____ DATE _____

OLD PENDING FURTHER TESTS _____

REASONS FOR REJECTION OR HOLDING _____

PERCOLATION TEST PLAT/PRELIMINARY PLAT - TITLE OR I.D. # _____ DATE _____

DEVELOPMENT PLAN/FINAL PLAT - TITLE OR I.D. # _____ DATE _____

THIS IS NOT A PERMIT

50619-J

COUNTY #

SOIL PROFILE

0' 556
 TOPSOIL
 1' LIGHT TAN
 3' SILTY CLAY
 PINK + YELLOW
 SILT LOAM
 5' PINK
 SANDY
 SILT
 LOAM

11' 554


1' TOPSOIL
 BROWNISH
 ORANGE
 CLAY
 3' MIXED
 PINK
 +
 YELLOW
 SILT
 11'

555

1' TOPSOIL
 BROWN
 CLAY
 LOAM
 4' PINK
 + YELLOW
 SANDY
 SILT
 LOAM
 11' 6"

SOIL PROFILE

0' 557
 TOPSOIL
 1' MED BROWN
 SILTY
 CLAY
 LOAM
 PINK
 SANDY
 SILT
 MICA
 LOAM

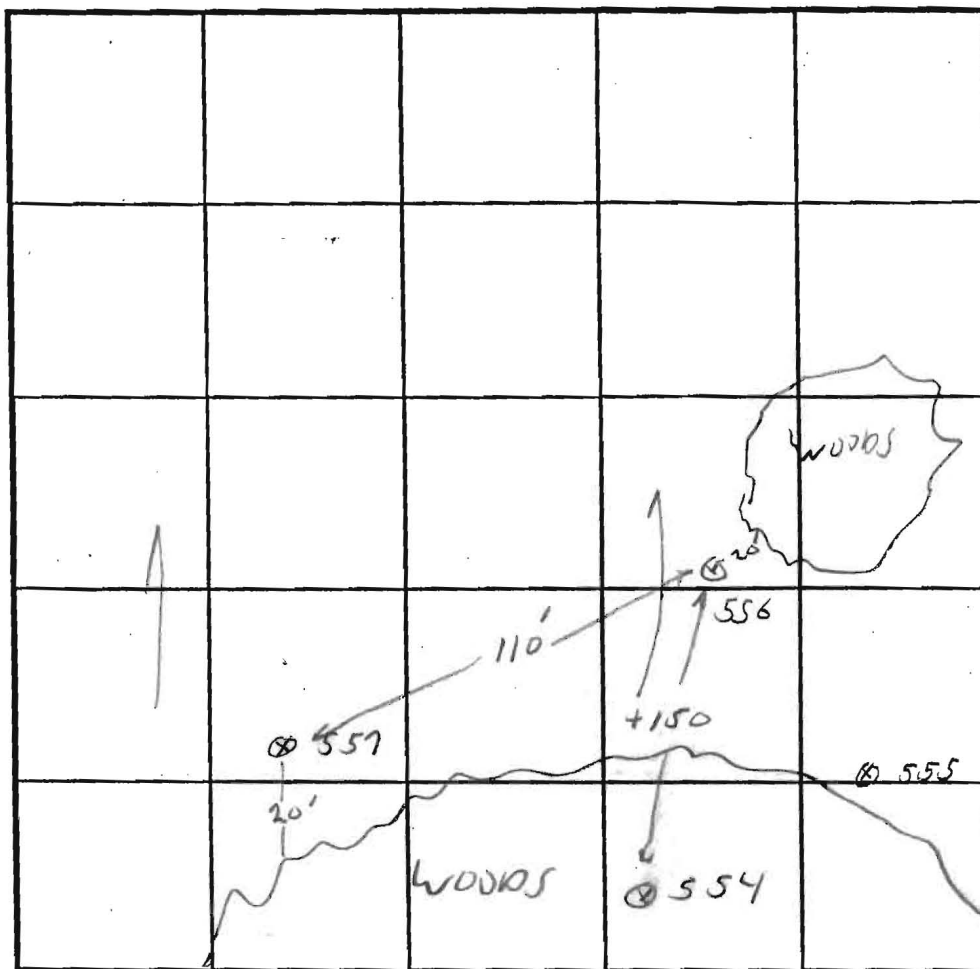

INDICATE NORTH - NAME ADJOINING ROADWAY AS BASE LINE.

DATE	TEST NO.	DEPTH	PRE-WET		TEST - 1" DROP		TIME
			START	STOP	START	STOP	
9/29/95	557	5'	12:44	12:48	12:48	12:54	6 MIN
		7'	12:45	12:46	12:46	12:48	2 MIN
	556	4' 4"	2:04	2:06	2:06	2:11	5 MIN
	554	5'	2:12	2:18	2:18	2:28	10 MIN
	555	4' 6"	2:19	2:22	2:22	2:27	5 MIN

REMARKS LOT 15

TYPE OF SOIL


TESTED BY GLEN SAVAGE

ALSO PRESENT WILLIAM H. HELDER

TRENCH DESIGN DATA: AVERAGE PERCOLATION TIME TRENCH WIDTH

INLET DEPTH MAXIMUM BOTTOM DEPTH SQ. FT./BEDROOM

⑦ Approximate location of hand dug well that was supposed to be abandoned

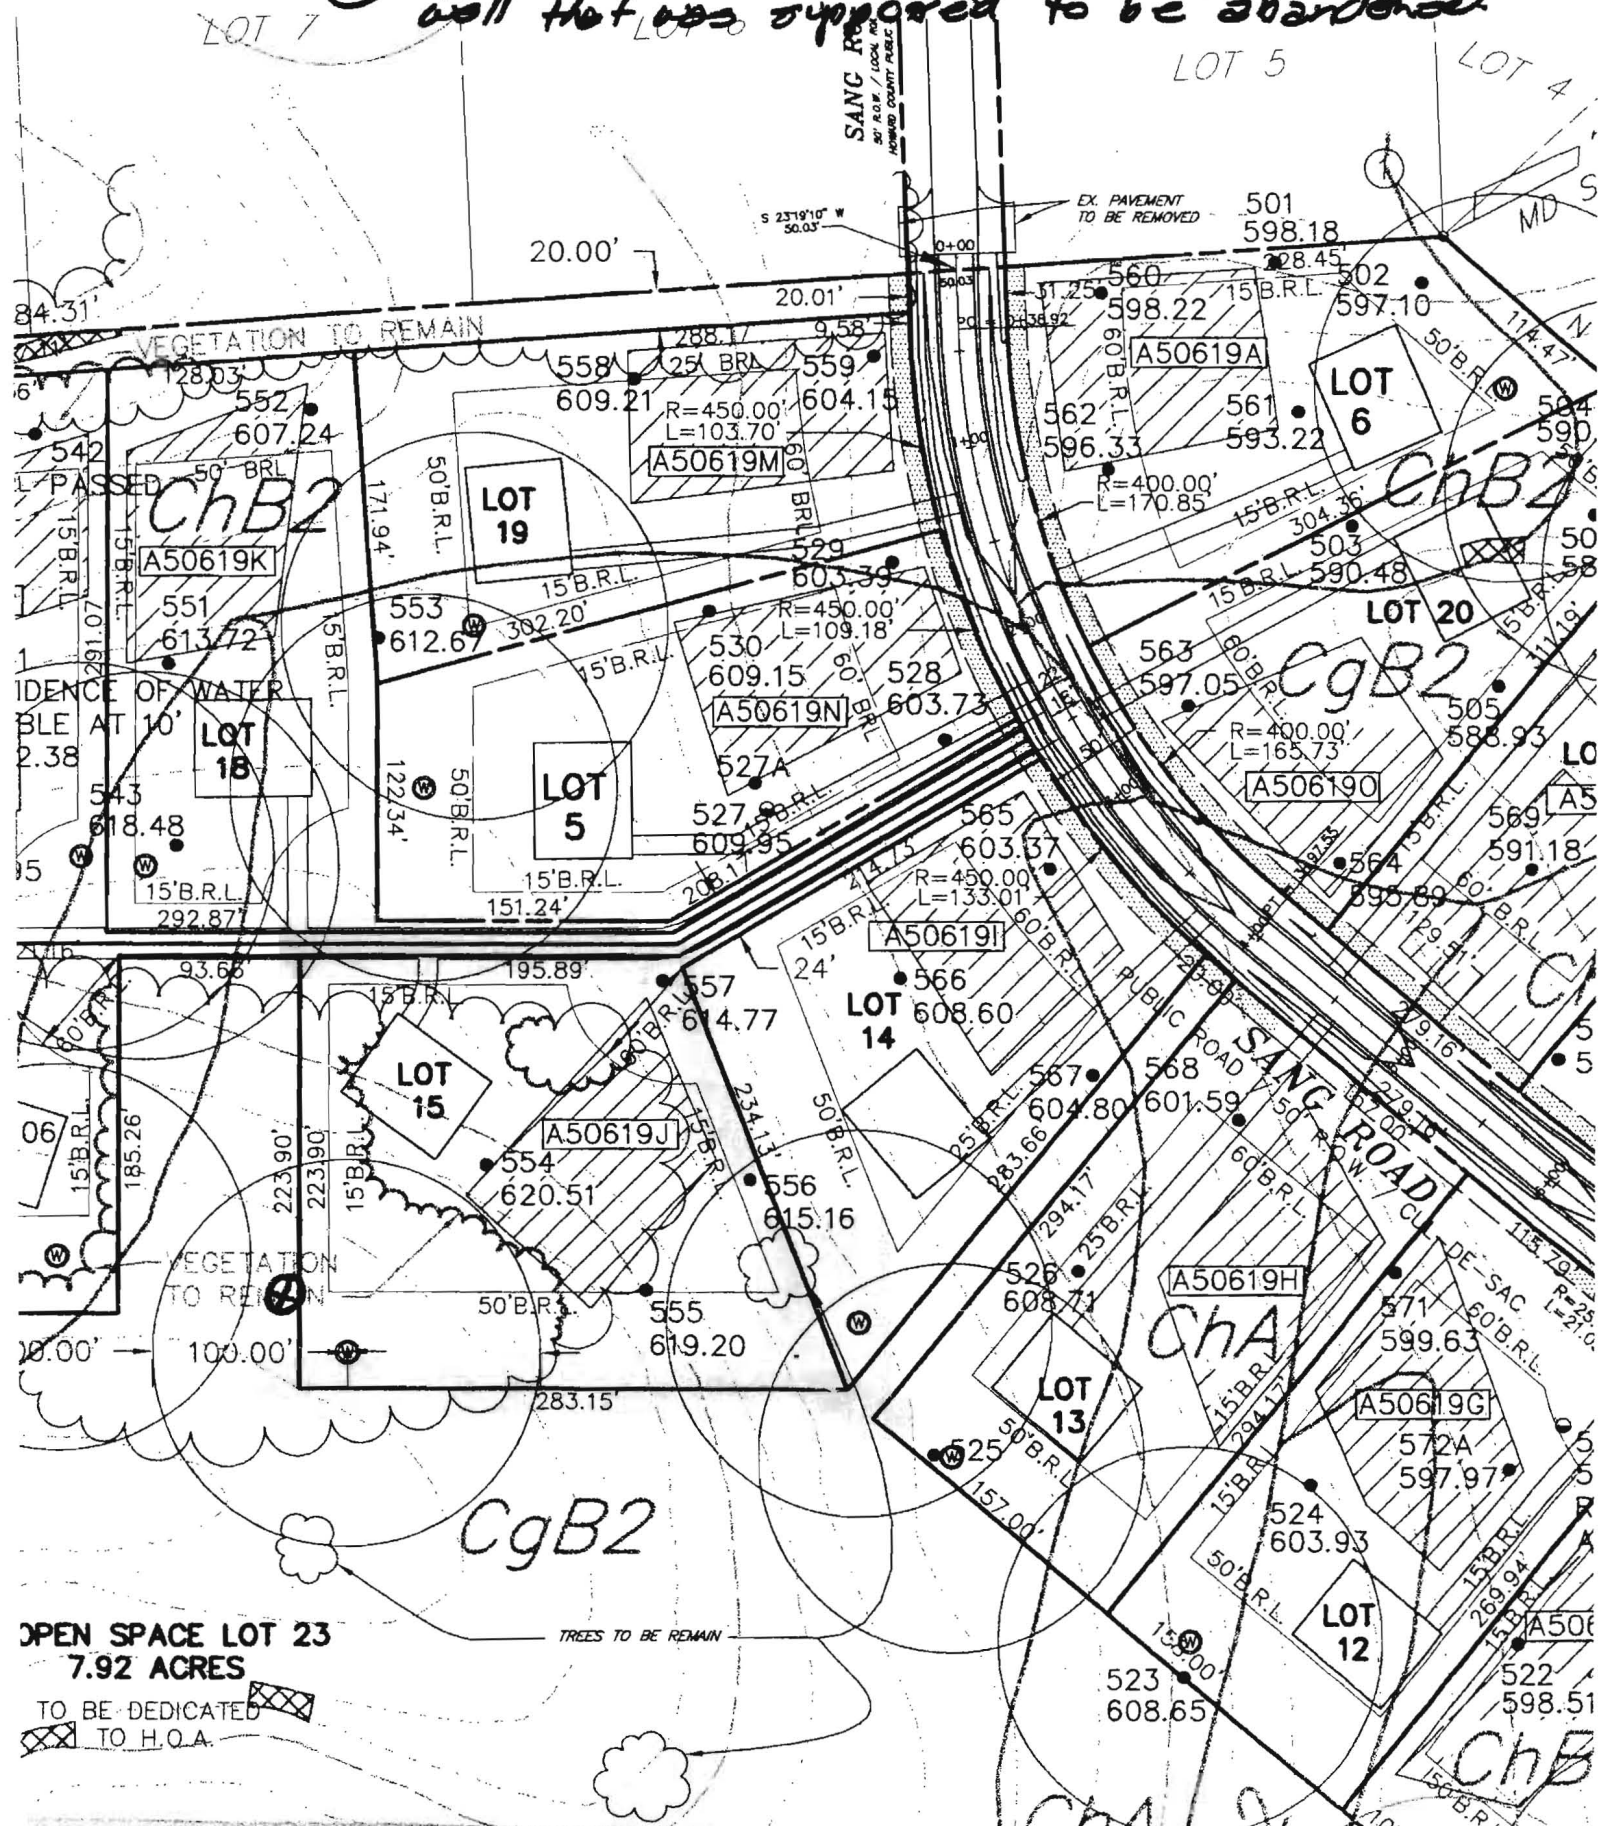

LOT 7

PRESERVATION PARCEL "A"

16.40 ACRES
(0.13 ACRES THIS SHEET)

N 23°19'19" E 556.55'

SHEET 3 OF 3

HOLLY HILLS,
SECTION II, LOT 19
PLAT NO. 12602

L=103.70'

EX. 10' TREE
MAINTENANCE
EASEMENT
PLAT NO. 12190

N 02°55'43" W 212.98'
N 02°55'43" W 211.31'
N 02°55'43" W 209.72'

HOLLY HILLS,
SECTION I, LOT 5
PLAT NO. 12190

L=105.38'

L=139.02'

N 27°25'29" E 152.87'
N 27°25'29" E 154.50'
N 27°25'29" E 197.52'
S 62°34'31" E 6.00'
S 62°34'31" E 6.00'
S 62°34'31" E 6.00'
S 62°34'31" E 6.00'

N 29°09'43" E 30.98'
S 57°52'24" E 48.63'

S 76°16'56" E 53.95'

N 62°34'27" W 223.90'
(LOT 15)

LOT 15

54,833 sq ft

24' PRIVATE
USE-IN-COMMON
EASEMENT FOR
LOTS 15 TO 18
LIBER 3727,
FOLIO 336

HOLLY HILLS,
SECTION II, LOT 14
PLAT NO. 12602

HOLLY HILLS,
SECTION II, LOT 1
PLAT NO. 1

N 80°30'00" E 14.02'

MATCHLINE

N 27°25'29" E 283.15'

30' B.R.L.

117.75' (THIS SHEET)

S 47°59'48" W 504.29'

FOREST CONSERVATION EASEMENT C
4.12 ACRES (2.77 ACRES THIS SHEET)

EXISTING FOREST CONSERVATION
EASEMENT TO BE ABANDONED
BY THIS PLAT OF REVISION

N 62°34'27" W 263.92'

166.74'

128.79'

108.04'

LOT 13

LOT 14

S 29°13'51" W

LOT 15

LOT

PRESERVATION PARCEL "A"

16.40 ACRES (2.38 ACRES THIS SHEET)

EASEMENT TO BE HELD BY
HOWARD COUNTY AND HOLLY HILLS
FAMILY ASSOCIATES HOMEOWNERS
ASSOCIATION, INC.

OPEN SPACE LOT 23

0.53 ACRES
DEDICATED TO H.O.A.

GWENLEE ESTATES,
PLAT 3923 ZONE

Copy of
signed
record
plat

L PROPERTY ARTICLE,
PLACEMENT VOLUME,
DATE TO THE MAKING
ERS HAVE BEEN

3/3/99
DATE

3/5/99
DATE

3/5/99
DATE

THIS SHEET

RECORDED 1

RECORDED 0

RECORDED 1

RECORDED 2

RECORDED 1.40 AC ±