

LAYOUT _____ INSP 4 _____

INSP 2 _____ INSP 5 _____

INSP 3 _____ INSP 6 _____

ISSUE DATE: _____

P _____

APPROVAL DATE: _____

A 521550-B

PERMIT INDEXED

ON-SITE SEWAGE DISPOSAL SYSTEM HOWARD COUNTY HEALTH DEPARTMENT BUREAU OF ENVIRONMENTAL HEALTH

_____ IS PERMITTED TO INSTALL ☒ ALTER ☐

ADDRESS: _____ PHONE NUMBER: _____

SUBDIVISION: _____ LOT NUMBER: _____

ADDRESS: 1565 Woodstock Road PROPERTY OWNER: Dawn Tittsworth

SEPTIC TANK CAPACITY (GALLONS): _____ OUTLET BAFFLE FILTER REQUIRED ☐PUMP CHAMBER CAPACITY (GALLONS): _____ COMPARTMENTED TANK REQUIRED ☐

NUMBER OF BEDROOMS: _____

SQUARE FEET PER BEDROOM: _____

LINEAR FEET OF TRENCH REQUIRED: _____

TRENCHES:	Trench to be feet wide. Inlet feet below original grade. Bottom maximum depth feet below original grade. Effective area begins at feet below original grade. feet of stone below distribution pipe.
LOCATION:	
NOTES:	

PLANS APPROVED: _____ DATE: _____

NOTE: PERMIT VOID AFTER 2 YEARS

NOTE: CONTRACTOR RESPONSIBLE FOR SCHEDULING A PRE-CONSTRUCTION INSPECTION FOR ALL INSTALLATIONS

NOTE: WATERTIGHT SEPTIC TANKS REQUIRED

NOTE: ALL PARTS OF SEPTIC SYSTEM SHALL BE 100 FEET FROM ANY WATER WELL

NOTE: MANHOLE RISERS REQUIRED ON ALL SEPTIC TANKS AND PUMP CHAMBERS UNLESS SPECIFICALLY AUTHORIZED

**NEITHER THE HOWARD COUNTY COUNCIL NOR THE HEALTH DEPARTMENT IS
RESPONSIBLE FOR THE SUCCESSFUL OPERATION OF ANY SYSTEM
PERMITTEE RESPONSIBLE FOR OBTAINING FINAL APPROVAL ON THIS PERMIT
CALL 410-313-2640 FOR INSPECTION OF SEPTIC SYSTEM**

SITE INSPECTION SHEET

OWNER: Dawn Titsworth

PHONE #: _____

ADDRESS: 1565 Woodstock

CONTRACTOR: Easterday

WELL TAG #: _____


SUBDIVISION: _____

LOT: _____

COUNTY #: _____

PROPOSAL: Ex. hand dug has low flow / sediment problems.

LOCATION DIAGRAM

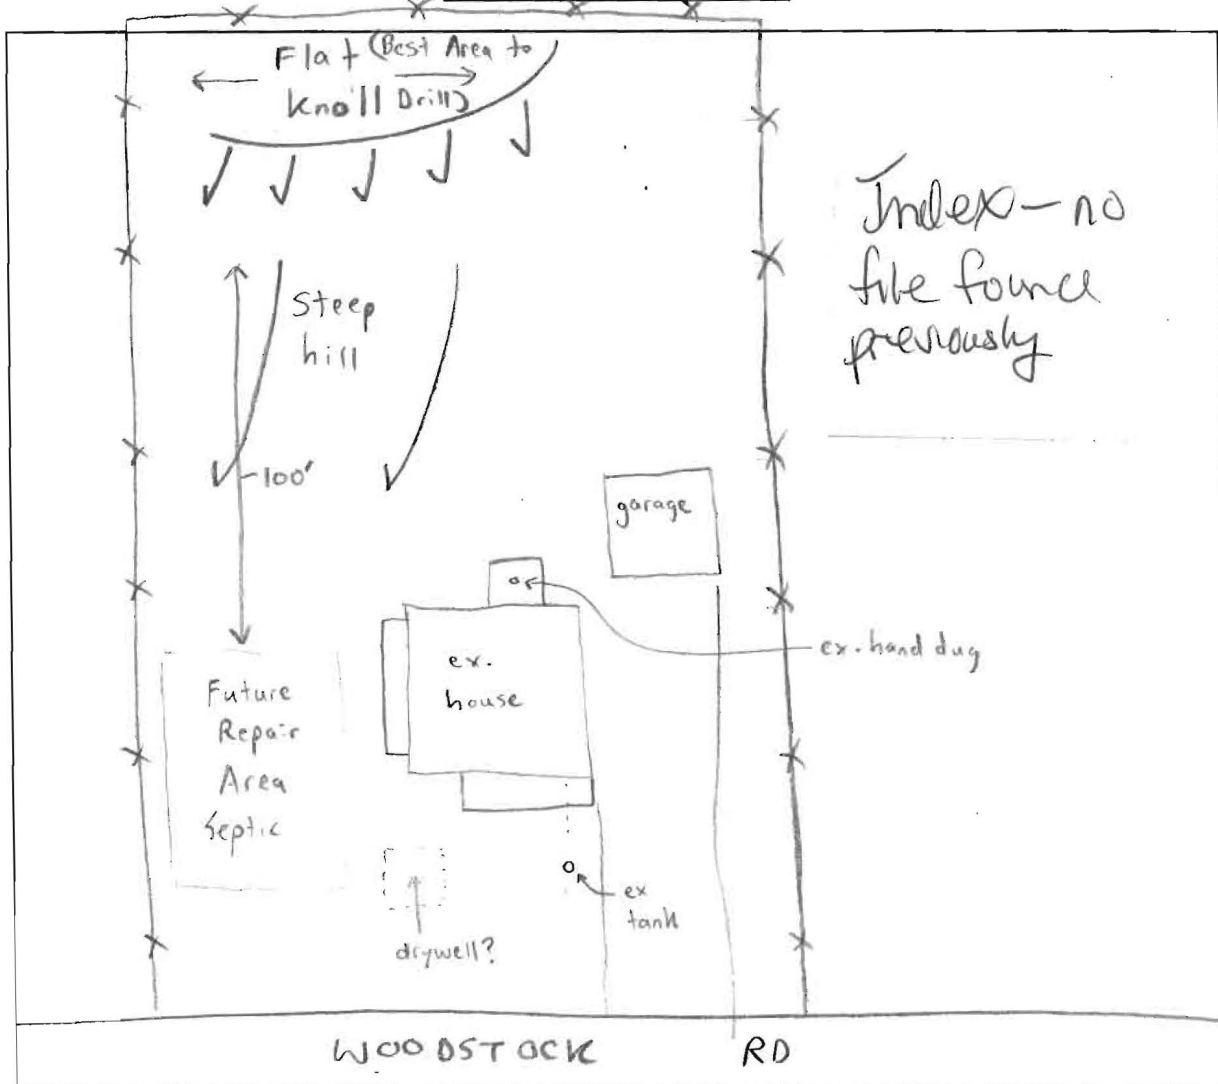

COMMENTS: Met driller (George Easterday) & owner (Dawn Titsworth). Discussed problems of access to site and potential solutions of obtaining an easement for a new well. Also discussed area of future septic repair.

DATE: 11/21/02

INSPECTOR: Steven R. Krieg

FILE INQUIRY FORM

Property Address: 1565 WOODSTOCK ROAD

7/26/04 Spoke to J.D. MARTINO ON MONDAY. HE WANTED HCAHD TO BE AWARE THAT THERE MAY BE LEGAL PROCEEDINGS FILED AGAINST HCAHD REGARDING THE DRILLING OF A WELL THAT SOMEONE (PREVIOUS OWNER) CLAIMS WAS REQUIRED BY HCAHD IN A COURT OF LAW. THERE ARE NO NOTES OR DOCUMENTS INDICATING THAT HCAHD WAS INVOLVED IN ANY COURT PROCEEDINGS. A NEW WELL WAS NEVER DRILLED BY THE PREVIOUS OWNER + SUPPOSEDLY THEY TOOK THE MONEY (\$13,000*) THAT WAS AWARDED TO THEM TO DO SO + SOLD PROPERTY TO A NEW PERSON. THIS NEW OWNER APPARENTLY FEELS THAT HCAHD IS AT FAULT FOR NOT FOLLOWING THROUGH WITH THE DRILLING OF THE WELL. I TOLD MR. MARTINO THAT I DIDN'T BELIEVE HCAHD WOULD HAVE GOTTEN INVOLVED IN THIS REAL ESTATE TRANSACTION. Stephane Nielson

* NO WELL PERMIT APPEARS TO HAVE BEEN ISSUED