

APPLICATION

SEWAGE DISPOSAL TESTING

STATE OF MARYLAND - DEPARTMENT OF HEALTH AND MENTAL HYGIENE

HOWARD COUNTY HEALTH DEPARTMENT
ENVIRONMENTAL HEALTH SERVICES

P. O. BOX 476 ELLICOTT CITY, MARYLAND 21043
TELEPHONE: 992-2330

A 34979

P _____

DISTRICT 5th ELECTION

DATE 2-14-85

TO: THE COUNTY HEALTH OFFICER
ELLICOTT CITY, MARYLAND

I, HEREBY, APPLY FOR THE NECESSARY TEST IN ORDER TO CONSTRUCT (OR RECONSTRUCT) A SEWAGE DISPOSAL SYSTEM.

PROPERTY OWNER HUNTINGTON INTERNATIONAL CORPORATION

ADDRESS 4951 ROCKWOOD PARKWAY N.W., WASH, D.C. 20016 PHONE (202) 659-2474

PROPERTY LOCATION: WATERFORD
SUBDIVISION HUNTINGTON ESTATES Section 2 LOT NO. 12 Prelim 12

ROAD AND DESCRIPTION ON BRIGHTON ROAD 1800' WEST OF TEN OAKS ROAD
INTERSECTION

SIZE OF LOT 3.20 AC± TYPE BLDG. SINGLE FAMILY DWELLING
(NUMBER OF BEDROOMS)

THE SYSTEM INSTALLED UNDER THIS APPLICATION IS ACCEPTABLE ONLY UNTIL PUBLIC FACILITIES BECOME AVAILABLE. I FULLY UNDERSTAND THE
FEE CONNECTED WITH THE FILING OF THIS PERC TEST APPLICATION IS NON-REFUNDABLE UNDER ANY CIRCUMSTANCES. I ALSO AGREE TO COMPLY
WITH ALL M.O.S.H.A. REQUIREMENTS IN TESTING THIS LOT. Chas. J. Conner

(SIGNATURE OF APPLICANT)

APPROVED BY Seckey Abue FOR Shallow tile fields DATE 4-1-87

REJECTED BY _____ FOR _____ DATE _____


HOLD PENDING FURTHER TESTS _____ DATE _____

REASONS FOR REJECTION OR HOLDING 4-2-85 SATISFACTORILY PERC. H₂O in 1' HOLE HOLD FOR REVIEW,
SUBDIVISION PLAT FOR HOLE LOCATION, HOUSE AND WELL SIDE. SYSTEM
FIRST. SAME 12/13/85 SHALLOW SYSTEM ONLY. S. Abue

THIS IS NOT A PERMIT

④
SOIL PROFILE

0"	A1-3
6"	RED BROWN CLAY LOAM 100% SAPROLITE
3'	BROWN SILTY SAND <10% SAPROLITE

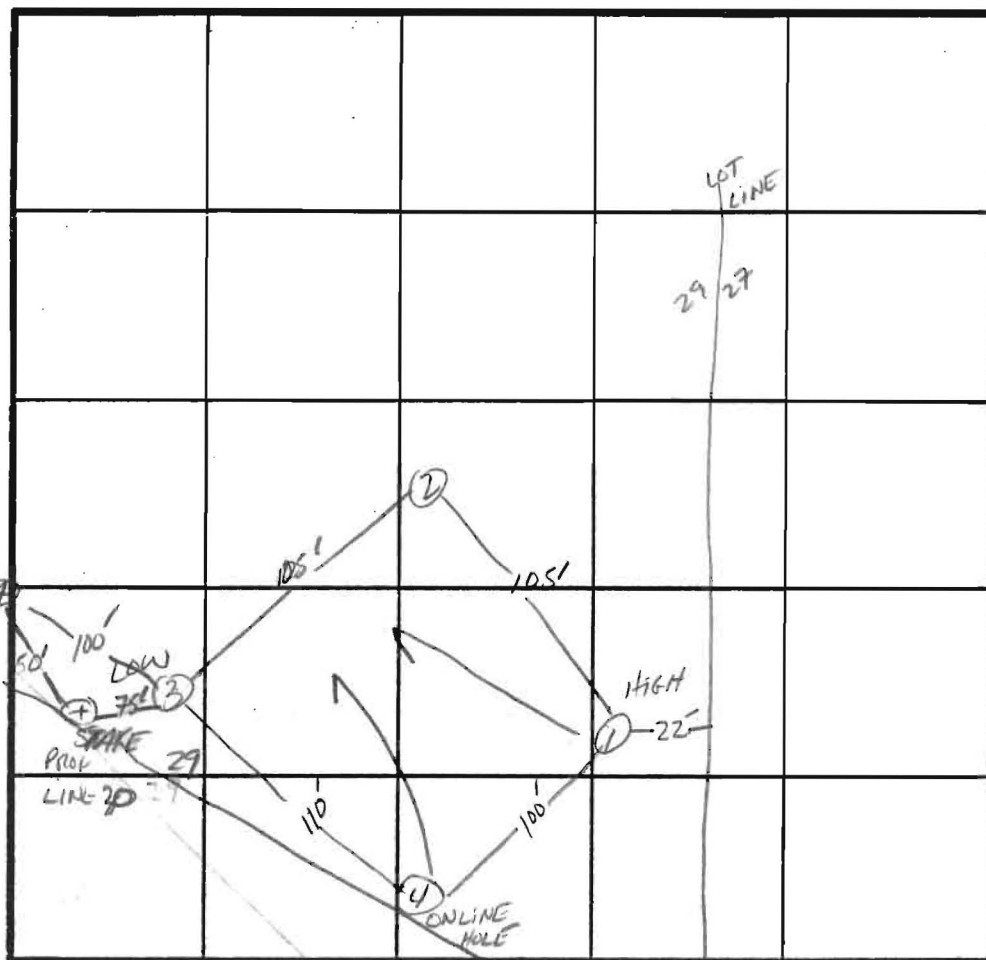

X PERC TIME
3min
INLET 3.5'
BOTTOM 5.0'

INDICATE NORTH - NAME ADJOINING ROADWAY AS BASE LINE.

BRIGHTON DAM Rd.

DATE	TEST NO.	DEPTH	PRE-WET		TEST - 1" DROP		TIME
			START	STOP	START	STOP	
4/2/85	1S	3.5'	11:03	11:04	11:04	11:07	3min
	1V	12.5'	UNIFORM SOIL STRUCTURE Below 3'				
	2S	3'	11:08	11:09	11:09	11:11	2min
	2V	12'	UNIFORM SOIL Below 2'				
	3S	5'	11:20	11:22	11:22	11:25	3min
	3V	12'	H2O AT 12' UNIFORM Below 4'				
	4S	4'	11:23	11:25	11:25	11:29	4min
	4V	12.5'	UNIFORM SOIL STRUCTURE Below 3'				

A WATER AT 9'

REMARKS

~~SYSTEM FIRST~~ High AREA OF LOT - SHALLOW System only S. of lot
12/13/85

TYPE OF SOIL

S. Abel

TESTED BY

LES, TERRY, DONNY

ALSO PRESENT