

7AUG64 incomplete *8/14/64 approved*
PERMIT
SEWAGE DISPOSAL SYSTEM
MARYLAND STATE DEPARTMENT OF HEALTH
HOWARD COUNTY
ELLICOTT CITY
DISTRICT 5
DATE 5/28/64

INDEXED

Elwood Scaggs IS PERMITTED TO INSTALL ☒ ALTER
ADDRESS Box 267D, Laurel, Maryland PHONE PA 5-0324
A SEWAGE DISPOSAL SYSTEM LOCATED AT _____
SUBDIVISION Moorestfield ROAD Wayneridge Court LOT 14, Blk. C
PROPERTY OWNER W. M. Robbins
ADDRESS _____
SPECIFICATIONS 3 bedrooms
DRAIN FIELD _____ DEPTH _____ FEET, BOTTOM AREA _____ SQ. FT.
SEEPAGE PITS _____ ABSORBENT SIDE-WALL AREA _____ SQ. FT.
SEPTIC TANK CAPACITY 750 GALLONS
FOR GARBAGE GRINDER, INCREASE DISPOSAL AREA 22% & TANK CAPACITY 50%.
OTHER Dry well - two dry wells. Each dry well must be 10 ft. diameter and 8 ft. deep below the inlet pipe. Inlet pipe must be 5 1/2 ft. below original grade. Place each dry well about 78 ft. from front lot line with one dry well about 25 ft. from right sideline and other dry well about 55 ft. from right side line as seen when facing lot from Wayneridge Court. Dry wells must be 30 ft. apart edge to edge.

PLANS APPROVED BY Donald W. Monaghan DATE 12/11/63
FILL SEPTIC TANK AND DISTRIBUTION BOX WITH WATER BEFORE CALLING FOR AN INSPECTION. COVER NO WORK UNTIL INSPECTED AND APPROVED.
NEITHER THE HOWARD COUNTY COMMISSIONERS NOR THE HEALTH DEPARTMENT IS RESPONSIBLE FOR THE SUCCESSFUL OPERATION OF ANY SYSTEM.

A 07815


A#07815

12/11/63 tested in area of S.W. location
18 min. at 10 ft. 1st 5 1/2' clay Duv.

11
8
14
8
29

10 3 1/2
248

18 6 1/2
3/500
16 1/2
6 6 1/2

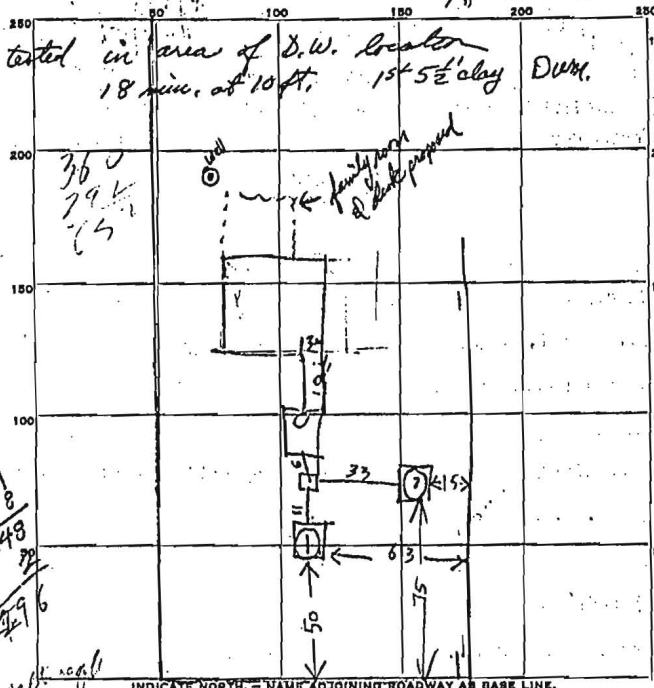

INDICATE NORTH - NAME ADJOINING ROADWAY AS BASE LINE.

PERMIT CARD

SEPTIC TANK, LEVEL OK 1000 collect CLEANOUTS 195
 TOP OF 1st below ground OK
 DISTRIBUTION BOX, LEVEL 275
 TILE FIELD, DEPTH 2925 FT. TRENCH WIDTH 75 FT.
 GRAVEL DEPTH 48 IN. TOTAL LENGTH 600 FT.
 NUMBER OF TRENCHES 300 TOTAL BOTTOM AREA 3600
 SEEPAGE PITS, INSIDE DIAMETER 10 FT. DEPTH BELOW INLET 9 FT.

7 AUG 64 ABSORBENT AREA 650 SQ. FT. total counting stone
 REMARKS Drain Well #1 - 10 ft. below ground, diameter 10 ft, depth
below inlet 9 ft. Diameter of Drain Well is 48 ft. Effective depth is 7.5 ft
Sidewall area counting stone is 360 sq ft
Drain Well #2 - 4 ft below ground, diameter is 8 ft, depth below
inlet is 9 ft. Diameter is 37 ft. Effective depth is 7.5 ft,
Sidewall area counting stone is 292 sq ft
 NO HOUSE SEWER 10 INSTALL HOUSE SEWER & call for REINSPECTION
 DATE SYSTEM APPROVED 11/64 INSPECTOR J.W. Manag