

Building Address1050 St. Michaels Rd
Mt. Airy MD 21771

Suite/Apt. #:SDP/WP/Petition #:

Census TractSubdivisionPoplar Heights

SectionArea5.12^{AC}LotH

Tax Map7Parcel27Grid8

ZoningMap CoordinatesLot Size5.12^{AC}

Existing Use

Proposed UseDeck

Estimated Construction Cost\$1500.00

Description of WorkDeck 20x40

Occupant or TenantMash + Mary Esfanaaji

Contact NameMash + Mary Esfanaaji

Address1050 St. Michaels Rd

CityMt. AiryStateMDZip Code21771

Phone410-489-5613Fax

Property Owner's NameMashhood Esfanaaji

Address1050 St. Michaels Rd

CityMt. AiryStateMDZip Code21771

Home Phone410-489-5613Work Phone

Applicant's Name & Mailing Address, (if other than stated herein):

Phone410-489-5613Fax

Contractor CompanyN/A

Contact PersonSelf

Address1050 St. Michaels Rd

CityMt. AiryStateMDZip Code21771

License No.N/A

Phone410-489-5613Fax

Engineer or Architect CompanyN/A

Contact PersonSame as above

Address

CityStateZip Code

PhoneFax

BUILDING DESCRIPTION – COMMERCIAL

Building Characteristics

Height:

No. of stories:

Gross area, sq. ft. per floor:

Use group:

Construction type:

Reinforced Concrete

Structural Steel

Masonry

Wood Frame

State Certified Modular

Utilities

Water Supply:

Public

Private

Sewage Disposal:

Public

Private

ElectricYesNo

GasYesNo

Heating System:

ElectricOil

Natural Gas

Propane Gas

Sprinkler system: N/A

Full

Partial

Other Suppression

of Heads

BUILDING DESCRIPTION – RESIDENTIAL

Building Characteristics

SF DwellingXSF Townhouse

DepthWidth

1st floor:

2nd floor:

Basement:

Finished BasementUnfinished BasementCrawl spaceSlab on Grade

No. of Bedrooms

Multi-family dwellings:

No. of efficiency units:

No. of 1 BR units:

No. of 2 BR units:

No. of 3 BR units:

Other Structure:

Dimensions:

Footings:

Roof:

State Certified Modular

Manufactured Home

Utilities

Water Supply:

Public

Private

Sewage Disposal:

Public

Private

ElectricYesNo

GasYesNo

Heating System:

ElectricOil

Natural Gas

Propane Gas

Sprinkler system: N/A

NFPA #13D

NFPA #13R

Other:

THE UNDERSIGNED HEREBY CERTIFIES AND AGREES AS FOLLOWS: (1) THAT HE/SHE IS AUTHORIZED TO MAKE THIS APPLICATION; (2) THAT THE INFORMATION IS CORRECT; (3) THAT HE/SHE WILL COMPLY WITH ALL REGULATIONS OF HOWARD COUNTY WHICH ARE APPLICABLE THERETO; (4) THAT HE/SHE WILL PERFORM NO WORK ON THE ABOVE REFERENCED PROPERTY NOT SPECIFICALLY DESCRIBED IN THIS APPLICATION; (5) THAT HE/SHE GRANTS COUNTY OFFICIALS THE RIGHT TO ENTER ONTO THIS PROPERTY FOR THE PURPOSE OF INSPECTING THE WORK PERMITTED AND POSTING NOTICES.

M. Esfanaaji

Applicant's Signature

OWNER

Title/Company

Mashhood Esfanaaji

Print Name

6-25-2009

Date

Checks payable to: DIRECTOR OF FINANCE OF HOWARD COUNTY
PLEASE WRITE NEATLY AND LEGIBLY.
- FOR OFFICE USE ONLY -

AGENCYDATESIGNATURE APPROVAL

Land Development, DPZ

State Highways

Building Officials

Dev. Engineering, DPZ

Health6-25-09 D. Bernard

Fire Protection

Is Sediment Control approval required prior to issuance?

YESNO

CONTINGENCY CONSTRUCTION START: ONE STOP SHOP:

DPZ SETBACK INFORMATION

Front:

Rear:

Side:

Side St.:

All minimum setbacks met?

YESNO

Is Entrance Permit Required?

YESNO

Historic District?

YESNO

Lot Coverage for New Town Zone

SDP/Red-line approval date

Filing fee\$

Permit fee\$

Excise tax\$

Add'l per fee\$

TOTAL FEES\$

Sub-total paid\$


Balance due\$

Check#

Validation#

Accepted by

Distribution of Copies - White: Building Officials Green: LDD, DPZ Yellow: DED, DPZ Pink: Health Gold: SHA
T:Operations/Updated forms

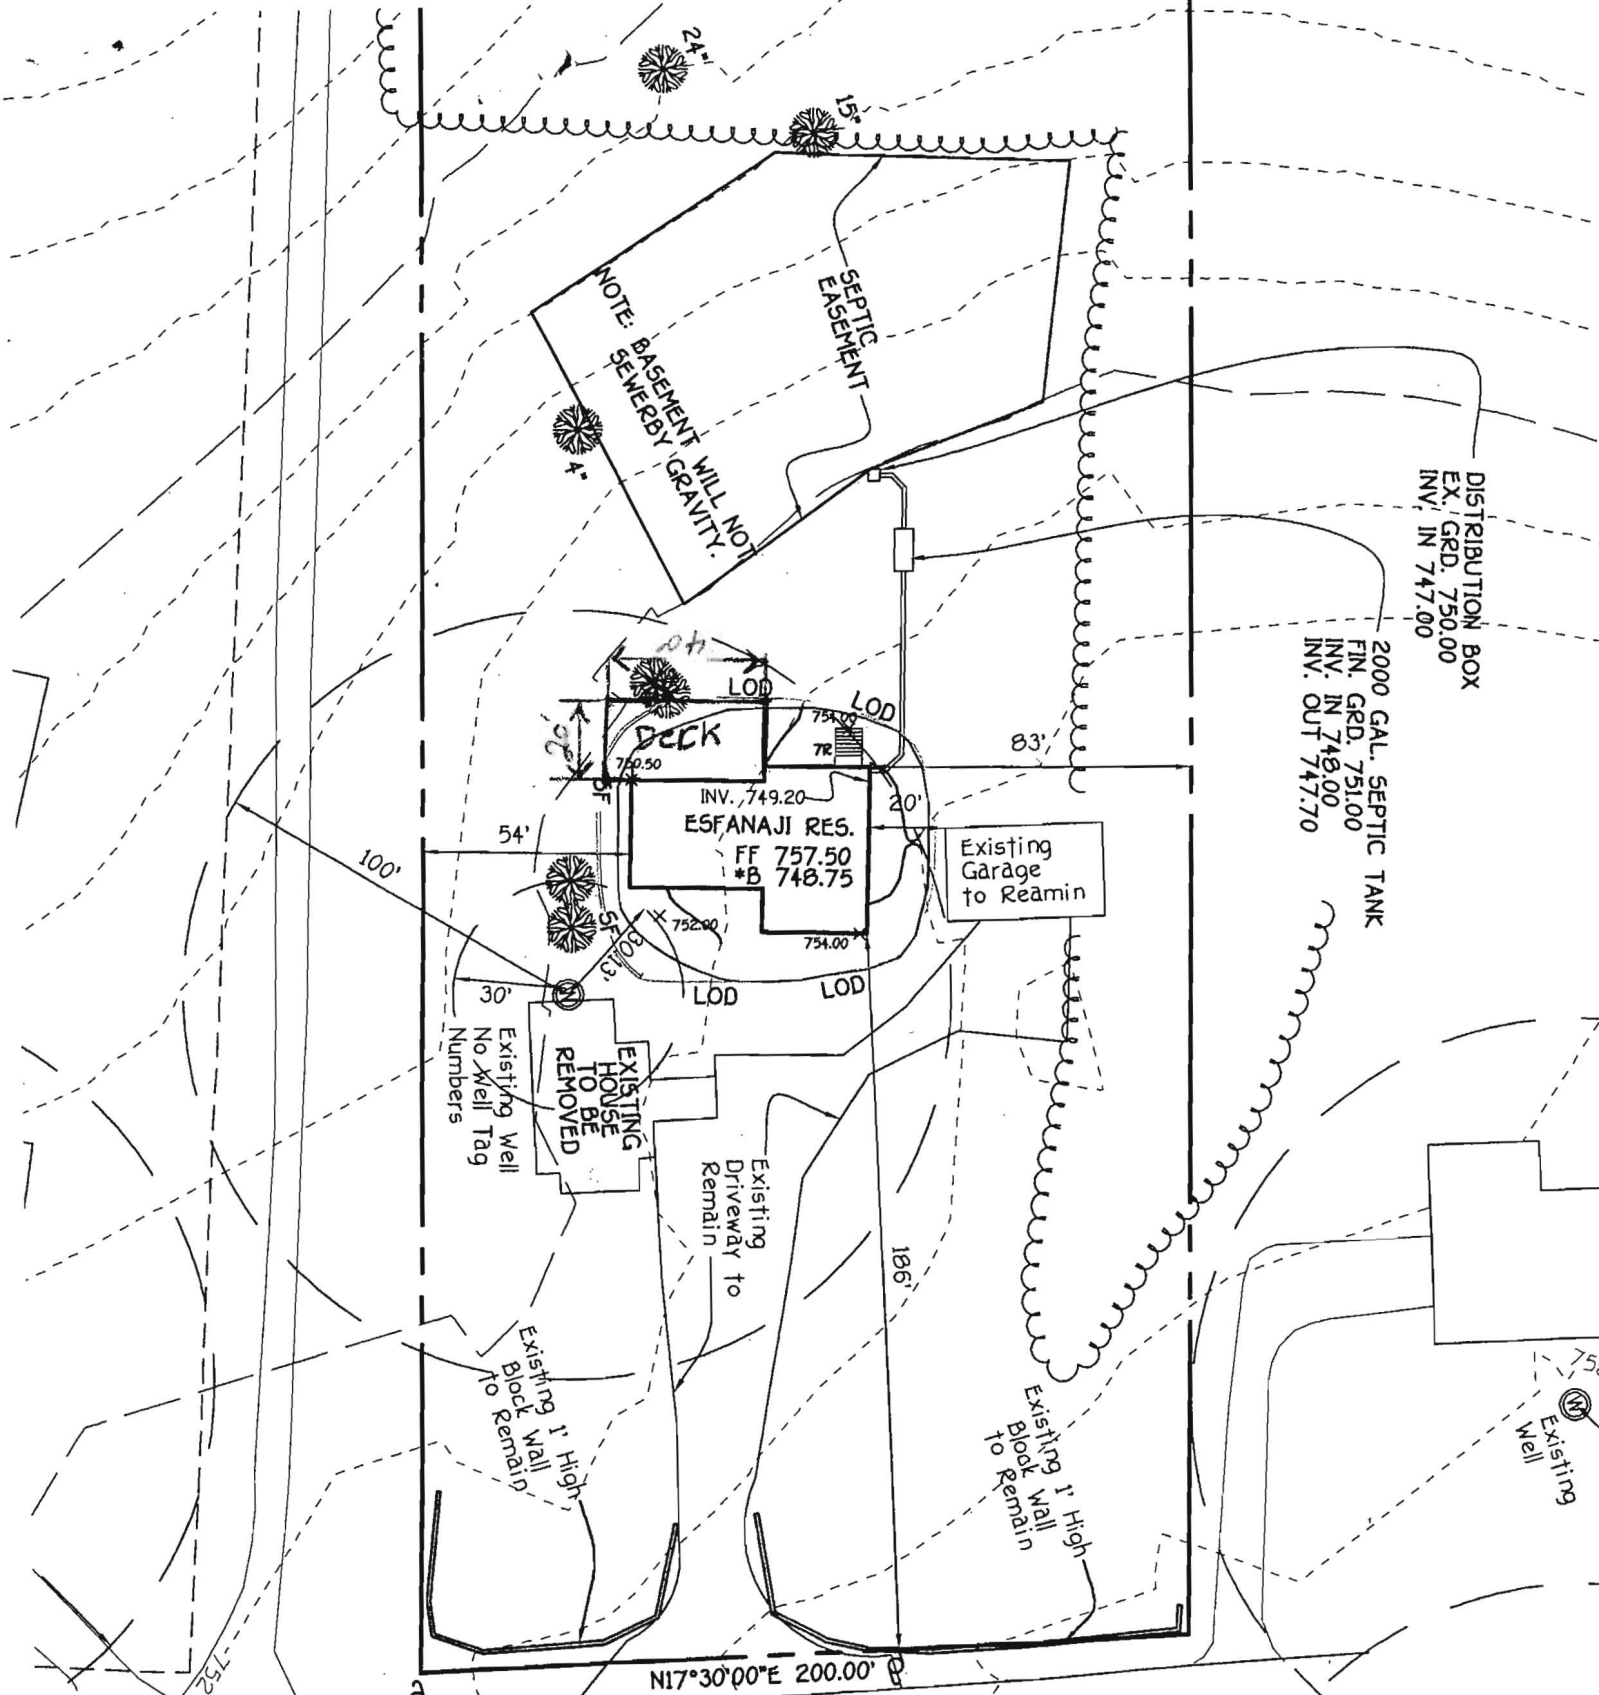

SAINT MICHAEL ROAD APPROVED

WALK-THRU BUILDING PERMIT
 BP# _____ A# _____
 APP. SAND Bernard DATE: 6-25-09
 DESC. OF WORK: 20 X 40
Approved as shown

Scale: 1" = 50'
 1050 St. Michael Road
 Mt Airy MD 21771

HOWARD COUNTY
PERMIT APPLICATION

PERMIT NUMBER

B00157080

Building Address 1050 ST MICHAELS RD
MT Airy Md 21771-3206
 Suite/Apt. #: 04-317483 SDP/WP/Petition #: _____
 Census Tract 6041001 Subdivision Drayton
 Section _____ Area _____ Lot H
 Tax Map 7 Parcel 27 Grid 8
 Zoning RCDED Map Coordinates 309 Lot size 5.124

Existing Use Single Family Dwelling
 Proposed Use Single Family Dwelling
 Estimated Construction Cost \$ 250,000

Description of Work Replacement SFD
6BR 3 1/2 Bath finished basement
Basement

Occupant or Tenant Owner
 Contact Name Mary Esfawaji
 Address 1050 St Michaels Rd
 City Mt Airy State Md Zip Code 21771
 Phone _____ Fax _____

Property Owner's Name MARY ESFAWAJI
 Address 1050 ST MICHAELS RD
 City Mt Airy State Md Zip Code 21771-3206
 Home Phone 410-489-5613 Work Phone _____
 Applicant's Name & Mailing Address, (if other than stated hereon): _____

Phone _____ Fax _____

Contractor Company PERFECT FINISH REMODELING
 Contact Person JOHN H KEMSH
 Address 4335 Roxbury Mill Rd
 City Brownsville State Md Zip Code 20833
 License No. 35732 MHBR # 4823 5921
 Phone 410-489-9797 Fax 410-301-455-1248

Engineer or Architect Company PRINCE-GEORGE HENRY
 Contact Person ED CLARK
 Address 101 Airport Rd
 City Schuylkill State PA Zip Code _____
 Phone 800-786-4754 Fax _____

BUILDING DESCRIPTION - COMMERCIAL

Building Characteristics

Height: _____
 No. of stories: _____
 Gross area, sq. ft. per floor: _____
 Use group: _____
 Construction type:
☐ Reinforced Concrete
☐ Structural Steel
☐ Masonry
☐ Wood Frame
☐ State Certified Modular

Utilities

Water Supply:
☒ Public N/A
☐ Private
 Sewage Disposal:
☐ Public
☒ Private
 Electric Yes ☒ No ☐
 Gas Yes ☐ No ☒
 Heating System:
 Electric ☐ Oil ☒
 Natural Gas ☐
 Propane Gas ☐
 Sprinkler system: N/A ☒
☐ Full
☐ Partial
☐ Other Suppression
☐ # of Heads

BUILDING DESCRIPTION - RESIDENTIAL

Building Characteristics

SF Dwelling ☒ SF Townhouse ☐
 Depth Width
 1st floor: 27'7" 30'7"
 2nd floor: 11' 30'7"
 Basement: 27'7" 30'7"
☐ Finished Basement ☒ Unfinished Basement
☐ Crawl space ☐ Slab on Grade ☐
 No. of Bedrooms 6
 Multi-family dwellings:
 No. of efficiency units: _____
 No. of 1 BR units: _____
 No. of 2 BR units: _____
 No. of 3 BR units: _____
 Other Structure: _____
 Dimensions: _____
 Footings: _____
 Roof: _____
☒ State Certified Modular
☐ Manufactured Home

Utilities

Water Supply:
☐ Public
☒ Private
 Sewage Disposal:
☐ Public
☒ Private
 Electric Yes ☒ No ☐
 Gas Yes ☐ No ☒
 Heating System:
 Electric ☐ Oil ☒
 Natural Gas ☐
 Propane Gas ☐
 Sprinkler system: N/A ☒
☐ NFPA #13D
☐ NFPA #13R
☐ Other:

THE UNDERSIGNED HEREBY CERTIFIES AND AGREES AS FOLLOWS: (1) THAT HE/SHE IS AUTHORIZED TO MAKE THIS APPLICATION; (2) THAT THE INFORMATION IS CORRECT; (3) THAT HE/SHE WILL COMPLY WITH ALL REGULATIONS OF HOWARD COUNTY WHICH ARE APPLICABLE THERETO; (4) THAT HE/SHE WILL PERFORM NO WORK ON THE ABOVE REFERENCED PROPERTY NOT SPECIFICALLY DESCRIBED IN THIS APPLICATION; (5) THAT HE/SHE GRANTS COUNTY OFFICIALS THE RIGHT TO ENTER ONTO THE PROPERTY FOR THE PURPOSE OF INSPECTING THE WORK PERMITTED AND POSTING NOTICES.

JOHN H KEMSH III
 Applicant's Signature

JOHN H KEMSH III
 Print Name

 Title/Company

 Date

Checks payable to: DIRECTOR OF FINANCE OF HOWARD COUNTY
 ** PLEASE WRITE NEATLY AND LEGIBLY **
 - FOR OFFICE USE ONLY -

AGENCY DATE SIGNATURE APPROVAL
☒ Land Development, DPZ
☒ State Highways
☒ Building Official
☒ Dev. Engineering, DPZ
☒ Health 12-10-05 KACU HONAN
☒ Fire Protection
 Is Sediment Control approval required prior to issuance?
 YES ☒ NO ☐
 CONTINGENCY CONSTRUCTION START: ☐
 ONE STOP SHOP: ☐

DPZ SETBACK INFORMATION

Front: _____
 Rear: _____
 Side: _____
 Side St.: _____
 All minimum setbacks met? YES ☐ NO ☐
 Is Entrance Permit required? YES ☐ NO ☐
 Historic District? YES ☐ NO ☐
 Lot Coverage for NewTown Zone _____
 SDP/Red-line approval date _____

PROPERTY ID#:

67836
 Filing fee \$ 100.00
 Permit fee \$ _____
 Excise tax \$ _____
 Add'l per. fee \$ _____
 TOTAL FEES \$ _____
 Sub-total paid \$ _____
 Balance due \$ _____
 Check # 6958
 Validation # 103133

Accepted by A

Distribution of Copies: White: Building Official Green: LDD, DPZ Yellow: DED, DPZ Pink: Health Gold: SHA

Mike Davis
Howard County Well and Septic

August 1, 2006

Mike,

The Old Septic tank and drywell at 1050 St Michaels Rd has been pumped out, and the tanks and drywell have been collapsed and backfilled. Per permit #A-522507,P-523799 and B00157080.

John Komsa



Perfect Finish Remodeling Inc
4335 Roxbury Mill Rd
Brookeville. Md 20833