

4-26-71  
20W70

# PERMIT

SEWAGE DISPOSAL SYSTEM

MARYLAND STATE DEPARTMENT OF HEALTH

4/23/71  
Ready

HOWARD COUNTY

P. 15723

A. 15509

ELLICOTT CITY

DISTRICT 4

DATE 2/19/71

INDEXED

Howard Pickett

IS PERMITTED TO INSTALL ☒ ALTER ☐

ADDRESS Watersville Road, Mt. Airy, Md.

PHONE 829-0543

A SEWAGE DISPOSAL SYSTEM LOCATED AT

SUBDIVISION

18<sup>th</sup> Ave

ROAD

St. Michael's Church

LOT

PROPERTY OWNER

Dayton Barnard & wife

Rd. - approx. 1/4 mile in on left side  
(new house)

ADDRESS

SPECIFICATIONS - 3 bedrooms

DRAIN FIELD \_\_\_\_\_ DEPTH \_\_\_\_\_ FEET, BOTTOM AREA \_\_\_\_\_ SQ. FT.

SEEPAGE PITS \_\_\_\_\_ ABSORBENT SIDE-WALL AREA \_\_\_\_\_ SQ. FT.

SEPTIC TANK CAPACITY 1,000 GALLONS

FOR GARBAGE GRINDER, INCREASE DISPOSAL AREA 22% & TANK CAPACITY 50%.

OTHER Dry well to be 390 sq. ft. of absorbent sidewall area below the inlet pipe.

Inlet pipe to begin 4 ft. below original grade. Maximum depth of dry well to be 12 ft.

below original grade. Locate dry well 42 ft. from property line that runs parallel

with St. Michael's Road and 132 ft. from left side of 50 ft. right-of-way road

to property as lot is seen standing on St. Michael's Road facing lot.

NOTE: CALL FOR INSPECTION WHEN COMPLETED. ALL PIPE FROM HOUSE TO SEPTIC TANK MUST BE  
PLANS APPROVED BY James T. Wright DATE 9/22/70 CAST IRON.  
PERMIT VOID AFTER THREE YEARS.

FILL SEPTIC TANK AND DISTRIBUTION BOX WITH WATER BEFORE CALLING FOR AN INSPECTION. COVER NO WORK  
UNTIL INSPECTED AND APPROVED.

NEITHER THE HOWARD COUNTY COMMISSIONERS NOR THE HEALTH DEPARTMENT IS RESPONSIBLE FOR THE  
SUCCESSFUL OPERATION OF ANY SYSTEM.

15509



9/3/70

# PERMIT

SEWAGE DISPOSAL SYSTEM

MARYLAND STATE DEPARTMENT OF HEALTH

HOWARD COUNTY

P-15485

A-15429

ELLICOTT CITY

DISTRICT 4

DATE 8/20/70

INDEXED

Herman Sirk

IS PERMITTED TO INSTALL ☒ ALTER

ADDRESS Annapolis Rock Road, Woodbine, Md.

PHONE HU 9-4724

A SEWAGE DISPOSAL SYSTEM LOCATED AT

SUBDIVISION

ROAD Corner of St. Michael's Lot Rd. & Florence Rd.

PROPERTY OWNER Charles Layton & wife

ADDRESS

SPECIFICATIONS - 3 bedrooms - existing house

DRAIN FIELD DEPTH FEET, BOTTOM AREA SQ. FT.

SEEPAGE PITS ABSORBENT SIDE-WALL AREA SQ. FT.

SEPTIC TANK CAPACITY 1,000 GALLONS

FOR GARBAGE GRINDER, INCREASE DISPOSAL AREA 22% & TANK CAPACITY 50%.

OTHER Dry well - dig pit 16 ft. square (set block and top for 12 ft. diameter

fill in rest of pit with gravel.) Dry well effective depth to be 6 ft. below

the first 5 ft. non-absorbent ground. Locate dry well about 21 ft. behind shed.

Dry well must be 100 ft. away from well. All pipe must be cast iron with leaded joints.

PERMIT VOID AFTER THREE YEARS.


PLANS APPROVED BY D. W. Monaghan

DATE 7/30/70

FILL SEPTIC TANK AND DISTRIBUTION BOX WITH WATER BEFORE CALLING FOR AN INSPECTION. COVER NO WORK UNTIL INSPECTED AND APPROVED.

NEITHER THE HOWARD COUNTY COMMISSIONERS NOR THE HEALTH DEPARTMENT IS RESPONSIBLE FOR THE SUCCESSFUL OPERATION OF ANY SYSTEM.

A 15429

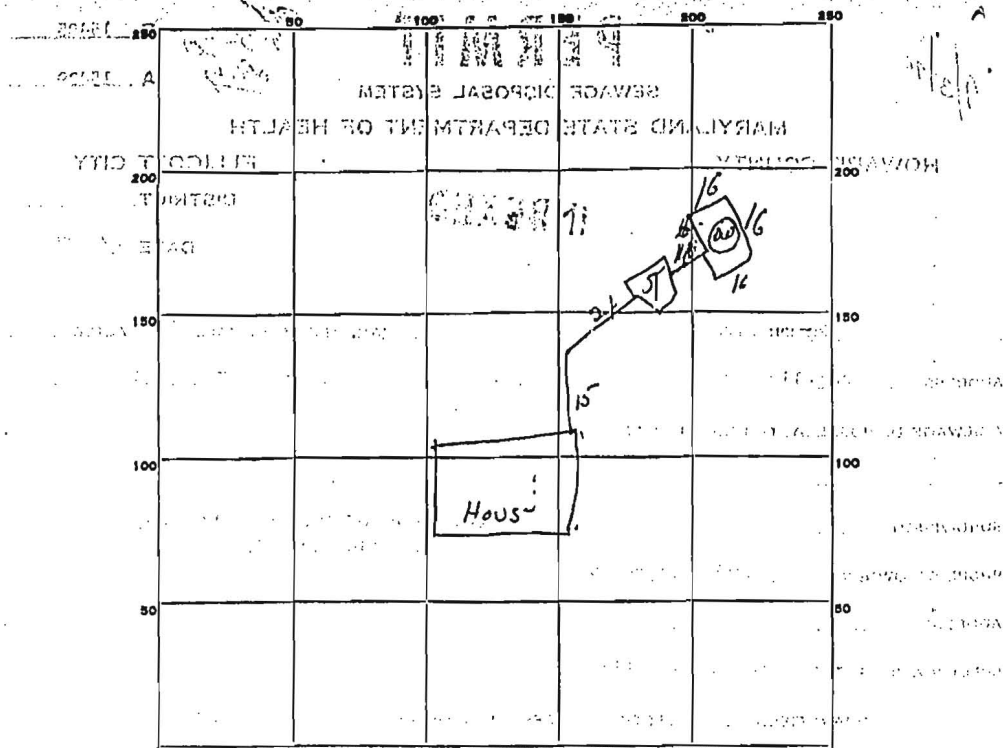

INDICATE NORTH - NAME ADJOINING ROADWAY AS BASE LINE.

*St Michaels View*

PERMIT CARD OK

SEPTIC TANK, LEVEL OK CLEANOUTS OK

DISTRIBUTION BOX, LEVEL \_\_\_\_\_

TILE FIELD, DEPTH \_\_\_\_\_ FT. TRENCH WIDTH \_\_\_\_\_ FT.

GRAVEL DEPTH \_\_\_\_\_ IN. TOTAL LENGTH \_\_\_\_\_ FT.

NUMBER OF TRENCHES \_\_\_\_\_ TOTAL BOTTOM AREA \_\_\_\_\_

SEEPAGE PITS, INSIDE DIAMETER Perimeter 14 FT. DEPTH BELOW INLET 6 ft FT.

ABSORBENT AREA 38 4 SQ. FT.

REMARKS \_\_\_\_\_

DATE SYSTEM APPROVED 9/3/77 INSPECTOR JW Mung