

PUB. SEWER STATUS VERIFIED BY _____

ISSUE DATE: 8/16/05

APPROVAL DATE: 8/17/05

PERMIT

INDEXED

03-304027

**ON-SITE SEWAGE DISPOSAL SYSTEM
HOWARD COUNTY HEALTH DEPARTMENT
BUREAU OF ENVIRONMENTAL HEALTH**

P 523134

A REPAIR 522880

Spann Mechanical Inc

IS PERMITTED TO INSTALL ☐ ALTER ☒

ADDRESS: 2534 B Old Frederick Road

PHONE NUMBER: 410-813-0251

SUBDIVISION: Henryton Heights

LOT NUMBER: 3

ADDRESS: 11834 Ramsburg Road

PROPERTY OWNER: Lloyd Butts

SEPTIC TANK CAPACITY (GALLONS):

Existing

Trench 2' Wide

PUMP CHAMBER CAPACITY (GALLONS):

Inlet 1.5'

NUMBER OF BEDROOMS:

5

Bottom 7.5'

SQUARE FEET PER BEDROOM:

180

6' stone Below Pipe

LINEAR FEET OF TRENCH REQUIRED:

122

TRENCHES:	Trench to be _____ feet wide. Inlet _____ feet below original grade. Bottom maximum depth _____ feet below original grade. Effective area begins at _____ feet below original grade. _____ feet of stone below distribution pipe.
LOCATION:	<u>Pump out and fill in existing drywell. With Dirt</u>
PURPOSE:	Existing septic system has failed. Call for inspection when ground is opened so sanitarian can recommend repair.

PLANS APPROVED: _____

DATE: _____

NOTE: PERMIT VOID AFTER 2 YEARS

NOTE: CONTRACTOR RESPONSIBLE FOR SCHEDULING A PRE-CONSTRUCTION INSPECTION FOR ALL INSTALLATIONS

NOTE: WATERTIGHT SEPTIC TANKS REQUIRED


NOTE: ALL PARTS OF SEPTIC SYSTEM SHALL BE 100 FEET FROM ANY WATER WELL

NOTE: MANHOLE RISERS REQUIRED ON ALL SEPTIC TANKS AND PUMP CHAMBERS

**NEITHER THE HOWARD COUNTY COUNCIL OR THE HEALTH DEPARTMENT IS
RESPONSIBLE FOR THE SUCCESSFUL OPERATION OF ANY SYSTEM
PERMITTEE RESPONSIBLE FOR OBTAINING FINAL APPROVAL ON THIS PERMIT
CALL 410-313-2640 FOR INSPECTION OF SEPTIC SYSTEM**

4522880

NOT TO SCALE

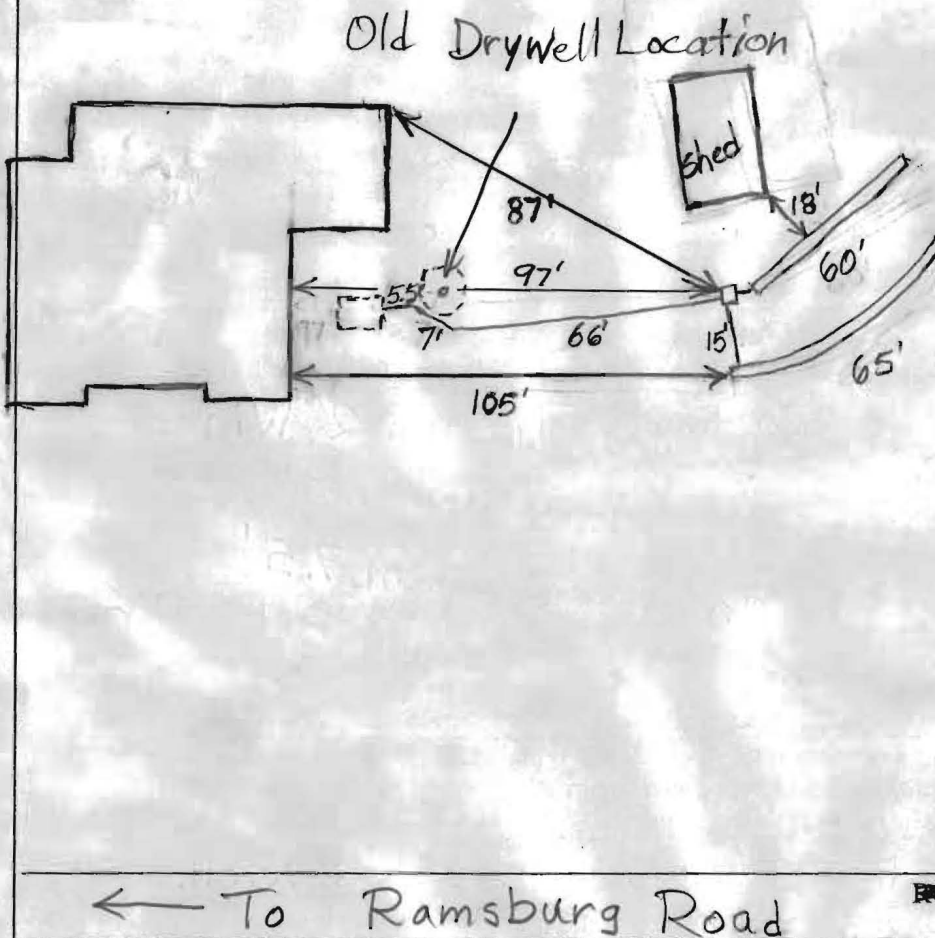

TRENCH/DRAINFIELD DATA		
WIDTH	INLET	BOTTOM
2'	2'-2.5'	7.5'
NUMBER OF TRENCHES 2		
TOTAL LENGTH 125'		
ABSORPTION AREA 672		
DISTRIBUTION BOX LEVEL Need Levelers		
DISTRIBUTION BOX BAFFLE Need		
DISTRIBUTION BOX PORT No		

SEPTIC TANK DATA	
SEPTIC TANK 1 LEVEL	
CAPACITY	Existing GAL
SEAM LOC	Midseam
TANK LID DEPTH	1'
BAFFLES	
BAFFLE FILTER	
MANHOLE LOC	
6" PORT LOC	
WATERTIGHT TEST	
SEPTIC TANK 2 LEVEL N/A	
CAPACITY	GAL
SEAM LOC	
TANK LID DEPTH	
BAFFLES	
BAFFLE FILTER	
MANHOLE LOC	
6" PORT LOC	
WATERTIGHT TEST	

PRE-CONSTRUCTION 7/25/05 Put a distribution box on the other side of the driveway and install 2 trenches on contour

INSTALLATION directly below the shed (BB) 8/16/05 Trenches off contour slightly and trench inlets almost 1' deeper than what was wanted. Need to put levelers and baffle in dist. box and pump out and fill in drywell. (BB) 8/17/05 Installer said he would put baffle and levelers in dist. box. Drywell to be pumped out and filled with dirt. Gave O.K. to cover everything. (BB)

FINAL INSPECTOR B. Baker

DATE OF APPROVAL 8/17/05

Repair

Paid \$165.00
7/7/07

A522880

SEPTIC SYSTEM REPAIR / UPGRADE

Please fill out this form completely and check off the reason

Date requested: ASAP

Reason for request:

BAD DRY WELL

Failing System (includes surface discharge or inadequate flow)

Has the contractor verified through excavation, pumping

MIKE SPANN

In support of a building permit. Type of building addition:

© 443-398-0947

*System relocation for proposed addition for setback compliance

④ 410-813-0251

*Verification of adequate system capacity per COMAR 26.11.01

To replace collapsed septic tank or upgrade tank capacity:

To replace collapsed drywell

Septic Contractor:

SPANN MECHANICAL INC

ST# 6868

Contractor's Address:

2534B OLD FREDERICK RD

OBELA MD 21228

Contractor's Phone #:

410-750-2038

Property Address:

11834 RAMSBURG RD 21104

Property (Subdivision) & Lot #

HUNTERTON HGTS

Owner's Name:

MR & MRS LLOYD BUTTS

Is public sewer available/nearby:

NO

Names of Any Previous Owners:

Year House Built:

1977

of Existing Bedrooms:

5

of Bedrooms after completion of addition:

Has this request been discussed previously with a Sanitarian?

If public sewer is close, further research will be performed at public sewer.

A Sanitarian will be in contact within three business days to coordinate the scheduling of the repair/upgrade/evaluation. If collection at the office.

Environmental Sanitarian tentatively assigned

FAX TO 410-813-0251

MICHAEL D. SPANN
PRESIDENT

OFFICE: (410) 750-2038
RESIDENCE: (410) 750-1905
PAGER: (410) 813-0251

SPANN MECHANICAL
PLUMBING & HEATING
INC.



2534B OLD FREDERICK ROAD

CATONSVILLE, MD 21228