

Re-test
12/10/65
g.s.

APPLICATION

SEWAGE DISPOSAL TESTING

MARYLAND STATE DEPARTMENT OF HEALTH

HOWARD COUNTY

ELLICOTT CITY

DISTRICT 4

DATE 12/3/65

750 gal. septic Tank.
Dry well 10 ft. in dia. by 10 ft. deep
below the inlet located 137 ft. from
the rear property line and 278 ft. off the
right side property line as seen when facing
the lot from Roxbury Mill road. Foster
inlet pipe 3 ft. below original grade.

TO: THE COUNTY HEALTH OFFICER
ELLICOTT CITY, MARYLAND

I, HEREBY, APPLY FOR THE NECESSARY TESTS IN ORDER TO CONSTRUCT OR RECONSTRUCT A SEWAGE DISPOSAL SYSTEM.

PROPERTY OWNER Eugene Connors

ADDRESS 6704 - 44th Avenue - Hyattsville, Md. PHONE 277-5024

PROPERTY LOCATION:

SUBDIVISION _____ LOT NO. _____

ROAD AND DESCRIPTION Corner of Rt. 97 & Roxbury Mill Rd. - South west corner
of Rt. 97 from Rt. 140

OCCUPANT _____ PHONE _____

PERSON TO CONSTRUCT SYSTEM _____

ADDRESS _____ PHONE _____

SIZE OF LOT 4.847 acres approx. TYPE BLDG. 3
NUMBER OF BEDROOMS

IF NOT SINGLE RESIDENCE DESCRIBE _____

SIGNATURE OF APPLICANT E. Connors

APPROVED BY J. Harnigan

FOR Dry Well

(KIND OF SYSTEM)

DATE 12-10-65

REJECTED BY _____

FOR _____

(KIND OF SYSTEM)

DATE _____

HOLD PENDING FURTHER TESTS _____

DATE _____

REASONS FOR REJECTION OR HOLDING _____

THIS IS NOT A PERMIT

APPLICATION

SEWAGE DISPOSAL TESTING

MARYLAND STATE DEPARTMENT OF HEALTH

HOWARD COUNTY

ELLICOTT CITY

DISTRICT 4

DATE 11/13/64

Hold for final plat. m. 7L2C.
300 sqft sidewalk
220 ft to 260 ft
from the fence along the back lot line
which is 635 ft long and 90 ft to 160 ft
from the back line which is 440 ft long (the
line which separates this property
from the property with the
Swimming Pool & white house)

TO: THE COUNTY HEALTH OFFICER
 ELLICOTT CITY, MARYLAND

I, HEREBY, APPLY FOR THE NECESSARY TESTS IN ORDER TO CONSTRUCT (OR RECONSTRUCT) A SEWAGE DISPOSAL SYSTEM.

PROPERTY OWNER Eugene Cannara

ADDRESS 6704 - 44th Avenue - Hyattsville, Md. PHONE 277-5024

PROPERTY LOCATION:

SUBDIVISION

LOT NO.

ROAD AND DESCRIPTION Corner of Rt. 97 & Roxbury Mill Rd. - South west corner of Rt. 97 from Rt. 40

Thid is berry mill Rd is dual
beside stream which leads to abandoned Cistern

OCCUPANT

PHONE

PERSON TO CONSTRUCT SYSTEM

ADDRESS

PHONE

SIZE OF LOT 5 acres

TYPE BLDG.

NUMBER OF BEDROOMS 3

IF NOT SINGLE RESIDENCE DESCRIBE

SIGNATURE OF APPLICANT

Eugene Cannara

APPROVED BY

Raymond Hodges

FOR

Dr. J. Well

(KIND OF SYSTEM)

DATE

2 DEC 64

REJECTED BY

FOR

(KIND OF SYSTEM)


DATE

HOLD PENDING FURTHER TESTS

DATE

REASONS FOR REJECTION OR HOLDING

THIS IS NOT A PERMIT

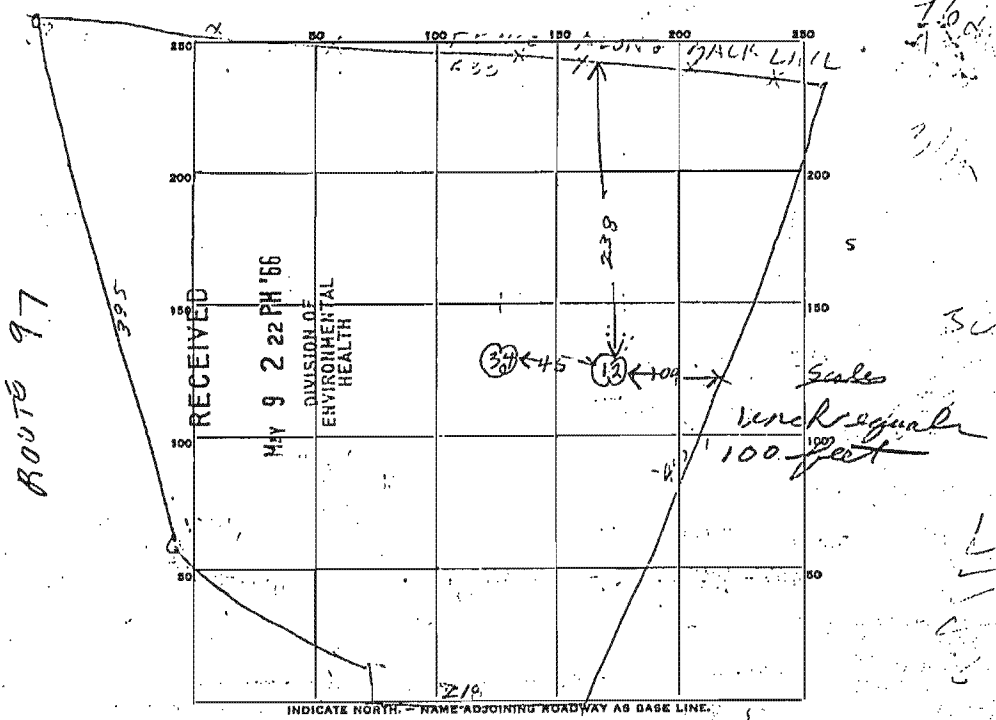

ROXBURY MILL RD

DATE	TEST NO.	DEPTH	PRE-WET		TEST - 1" DROP		TIME
			START	STOP	START	STOP	
DEC 64	1	9 1/2	127	127 1/2	127 1/2	128	1/2
" "	2	4	128	130	130	132	2
" "	3	9	135	136	136	139	3
" "	4	4 1/2	135	136	136	137	1

SOIL AUGER FINDING _____

TESTED BY Raymond Hodges

REMARKS _____

ALSO PRESENT Clayton Lingo LOT NO. _____