


Mike Etheridge
Cell 301-785-9592

② Auger Soil
At point A
TO ADJUST
SDA, SURR.
WELLS
TO BE LOCATED

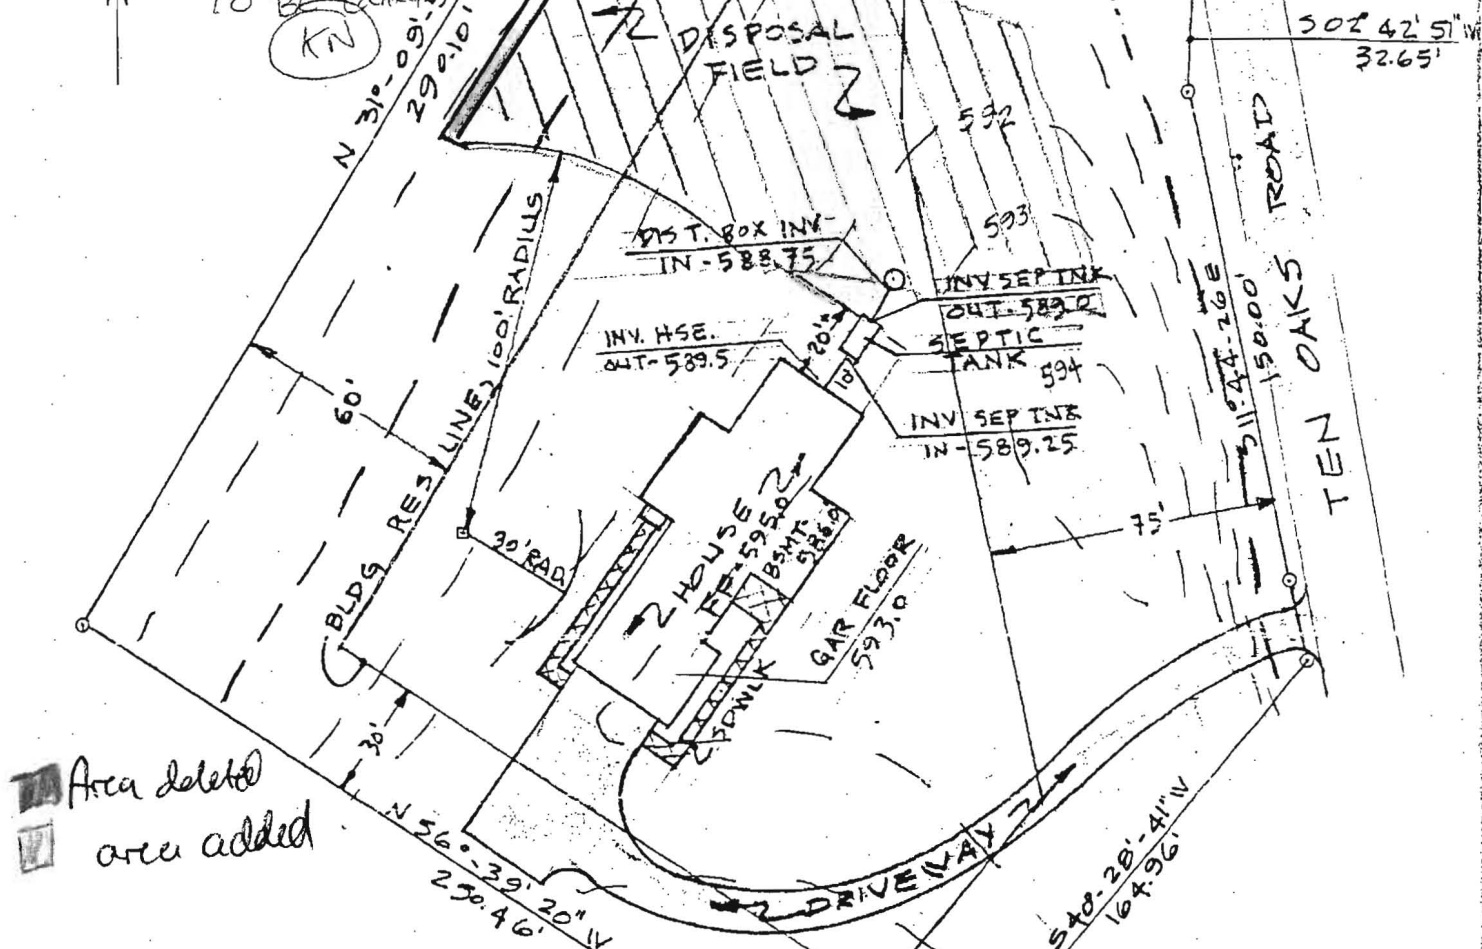

NOTES:

1. NO BASEMT SEWERAGE
2.  SEWERAGE DISPOSAL AREA - 10,000 SF MIN.

~~APPROVED~~

WALK-THRU BUILDING PERMIT
BP# 600154309 A# 22311
APP. SAN PAY DATE: 5/12/05
DESC. OF WORK: shed

ASSIGN
BP to SAN
W

APPROVED
WALK-THRU BUILDING PERMIT
BP# _____ A# 2231
APP. SAN RJS
DESC. OF WORK: 14 x 16' shed
DATE: _____
STREET: _____
CITY: _____
COUNTY: _____
STATE: _____

SITE PLAN

LOT 20B
M & V ETHRIDGE
FIFTH ELECTION DIST.
HOWARD CO.
CLARKSVILLE, MD.

SCAD: 11-50 DATE 12-6-57