

APPLICATION

A 23407

P _____

SEWAGE DISPOSAL TESTING

STATE OF MARYLAND - DEPARTMENT OF HEALTH AND MENTAL HYGIENE

HOWARD COUNTY HEALTH DEPARTMENT 3 B.R. 4 B.R. DISTRICT 3
ENVIRONMENTAL HEALTH SERVICES 1000 gal. sept. tank 1250 gal. sept. tank
P. O. BOX 476, ELLICOTT CITY, MARYLAND 21043 DATE 6/15/76
TELEPHONE: 465-5000, EXT. 356

8/11/76
9:30
2/14/76
9:30
Drywell to have 130 SQ. FT. effective sidewall absorption area per bedroom to begin below the first 3 1/2 ft. of non-porous soil. Maximum depth permitted for drywell is 11 1/2 ft. below original grade. Place the drywell 190 ft. from the right side line and 330 ft. from the edge of Rover Mill Rd. as seen when facing the property from Rover Mill Road.

TO: THE COUNTY HEALTH OFFICER
ELLICOTT CITY, MARYLAND

I, HEREBY, APPLY FOR THE NECESSARY TEST IN ORDER TO CONSTRUCT (OR RECONSTRUCT) A SEWAGE DISPOSAL SYSTEM.

PROPERTY OWNER John & Evelyn Keenan (Mrs. Gallagher)ADDRESS 10 Chas. H. Steffey, Inc PHONE 465-8500PROPERTY LOCATION: 9338 BALT NATHAN PIKE
E.C., Md, 21043SUBDIVISION Rover Mill Estates LOT NO. #5ROAD AND DESCRIPTION Rover Mill Road - approx. 3/4 mile off
Jefferson Rd.SIZE OF LOT 5.038 Ac TYPE BLDG. 4

NUMBER OF BEDROOMS

IF NOT SINGLE RESIDENCE DESCRIBE _____

THE SYSTEM INSTALLED UNDER THIS APPLICATION IS ACCEPTABLE ONLY UNTIL PUBLIC FACILITIES BECOME AVAILABLE.


SIGNATURE OF APPLICANT John J. KeenanAPPROVED BY Frank Skinner FOR Drywell DATE 11/22/76
(KIND OF SYSTEM)REJECTED BY _____ FOR _____ DATE _____
(KIND OF SYSTEM)

HOLD PENDING FURTHER TESTS _____ DATE _____

REASONS FOR REJECTION OR HOLDING 8/11/76 Perc. O.K. F.S.

THIS IS NOT A PERMIT

all holes
0 clay
3 mixed
4 sandy
100 m
13

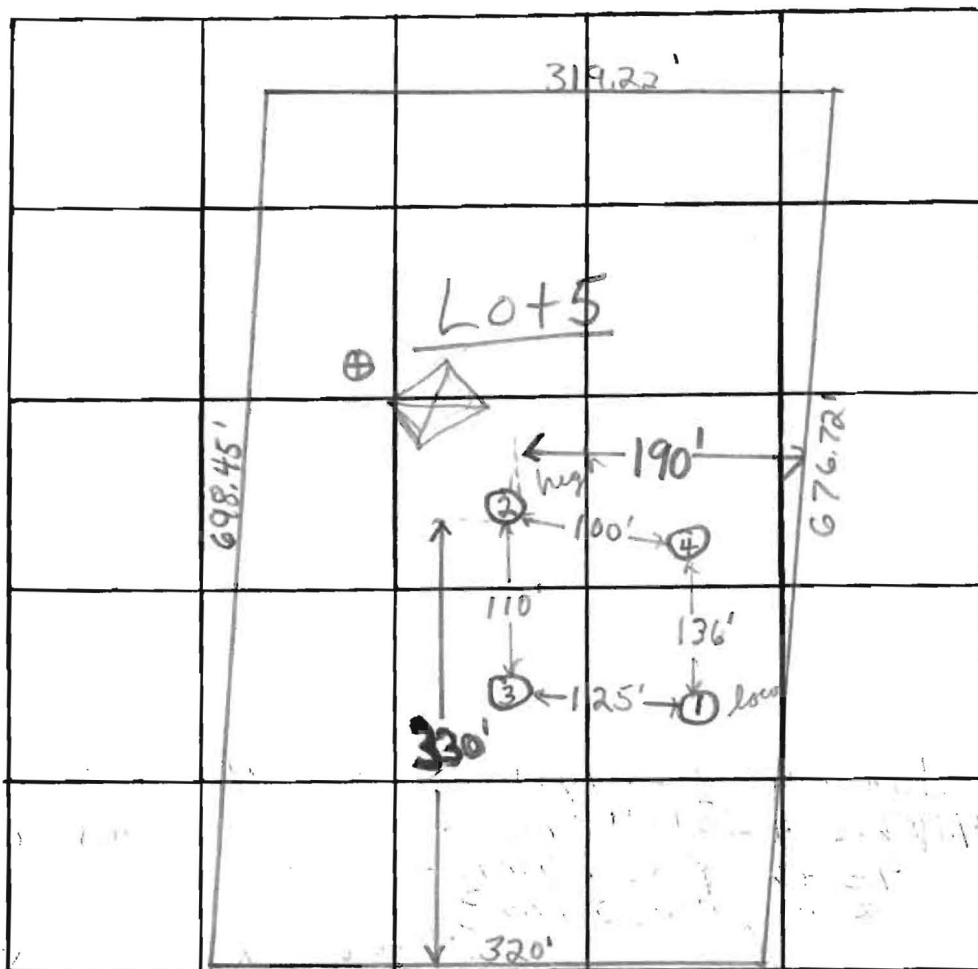

INDICATE NORTH. - NAME ADJOINING ROADWAY AS BASE LINE.

ROVER MILL ROAD

DATE	TEST NO.	DEPTH	PRE-WET		TEST - 1" DROP		TIME
			START	STOP	START	STOP	
8/11/76	1 low	5'	10:00	10:01	10:01	10:02	1 min
	1A	12 1/2'	10:00	10:02	10:02	10:05	3 min
	2 high	4 1/2'	10:05	10:08	10:08	10:13	5 min
	2A	13'	10:06	10:08	10:08	10:11	3 min
	3	4 1/2'	10:14	10:18	10:18	10:23	5 min
	3A	13'	10:14	10:16	10:16	10:21	5 min
	4	12'	Visual; clay to 4, sandy loam below				

REMARKS

TYPE OF SOIL

sandy loam below top 3-4' clayey soil

TESTED BY

F.S.


ALSO PRESENT:

Fyock & view

APPROVED: For private water and private
sewerage systems, Howard County Health Dept.

J. M. Boyles 11-9-76
County Health Officer Date

NOTE: The lot shown hereon complies with
minimum ownership width and lot area as re-
quired by The Maryland State Department of
Health Regulations.

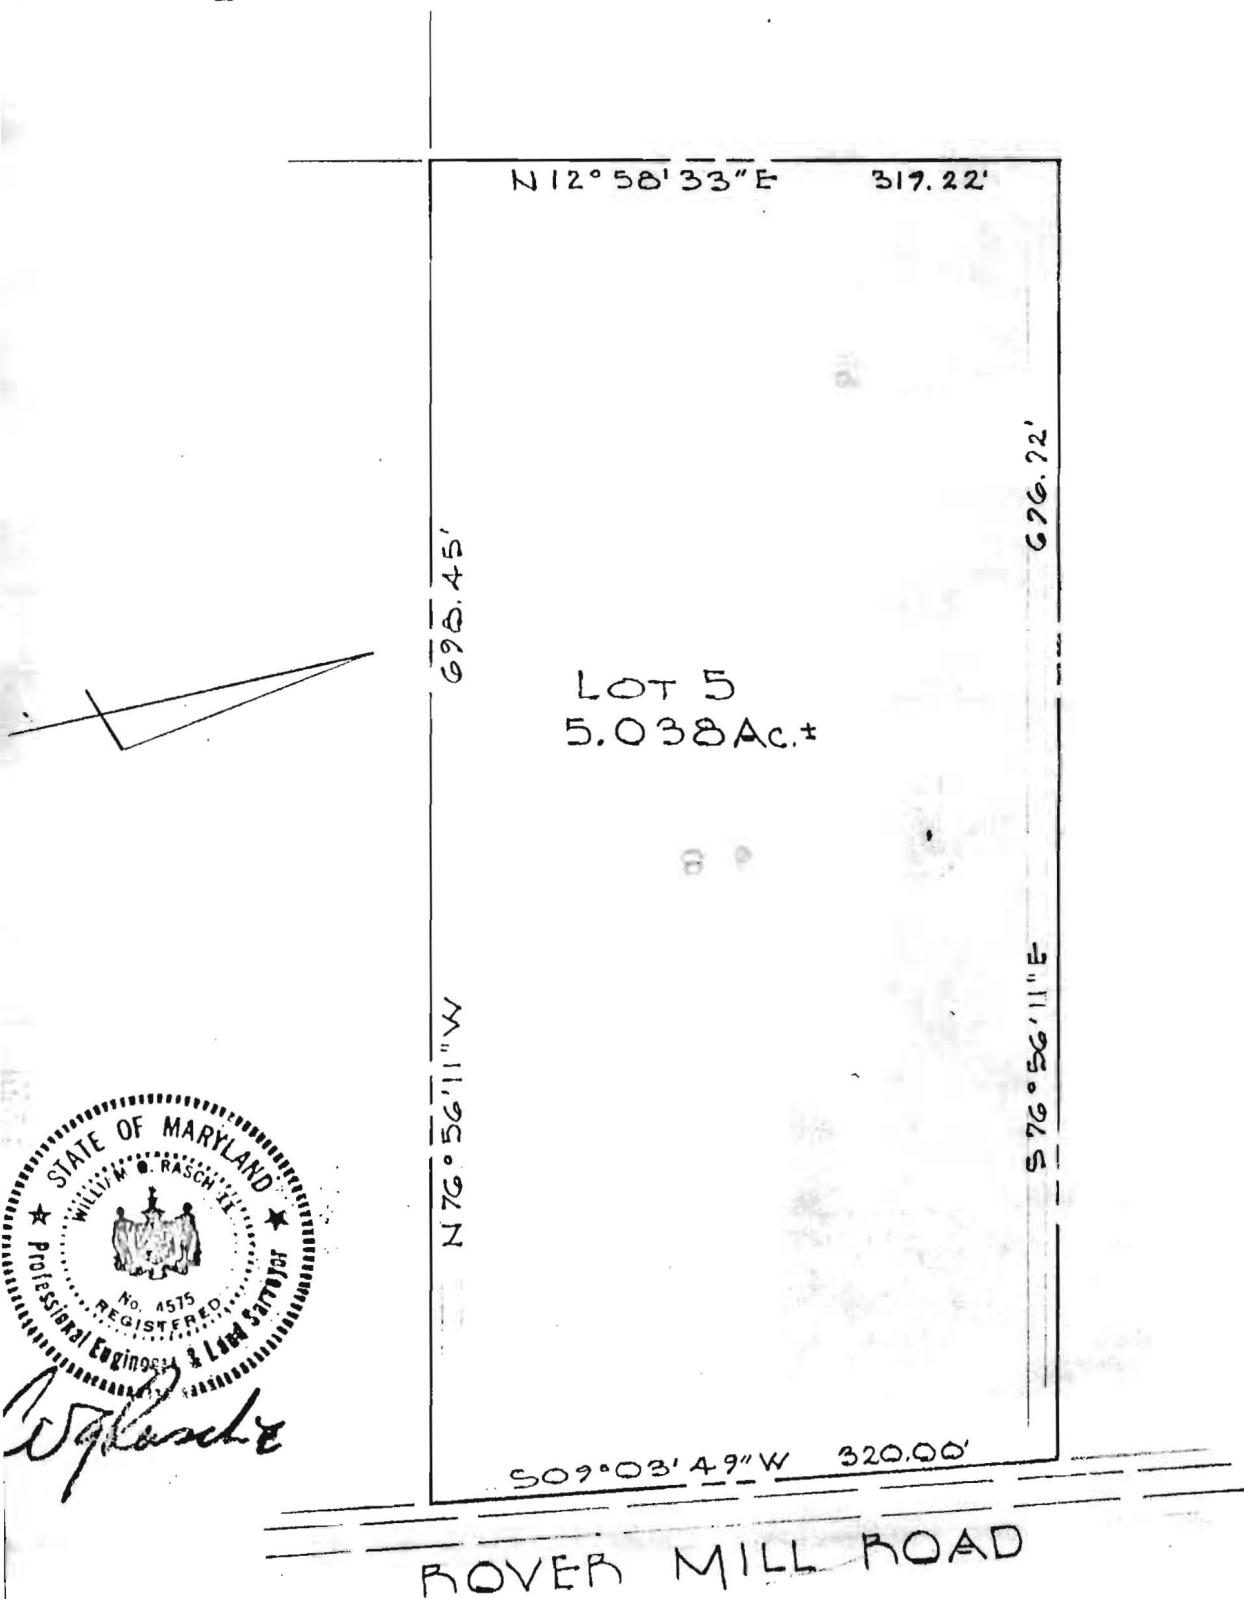

W. Raschke

FURDUM & JESCHKE
ENGINEERS &
LAND SURVEYORS
21037 PARK AVE.
ELLICOTT CITY, MARYLAND.

LOT No. 5
ROVER MILL ESTATES
4th ELECTION DISTRICT
HOWARD COUNTY, MARYLAND
JUNE 20, 1973
SCALE: 1"=100'