
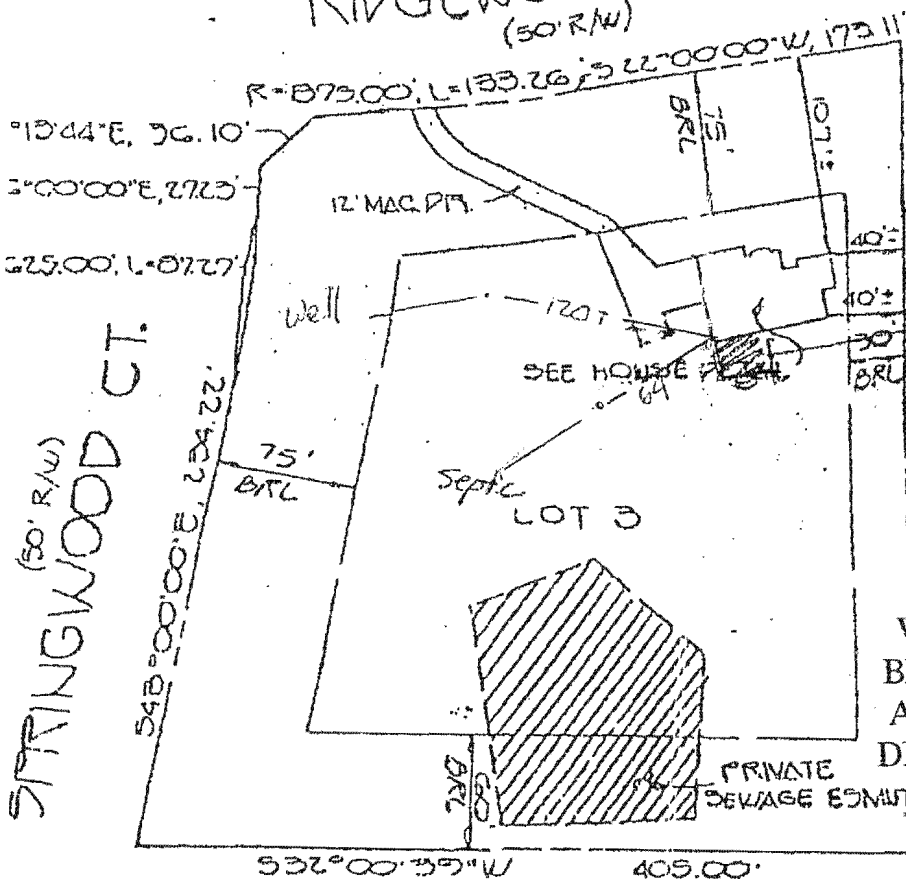


DATE: DECEMBER 4, 1986

$x|26$ or 27

SCALE: 1"=100'

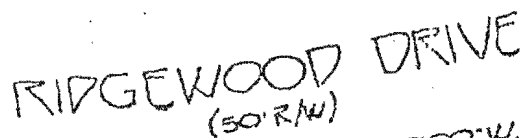

New revised Deck/Porch

APPROVED

WALK-THRU BUILDING PERMIT

BP# APV153549 A#



APP. SAN KJB

DATE: 5/4/05

DESC. OF WORK: $\approx 30 \times 20'$

Deck

BRL-BUILDING RESTRICTION LINE

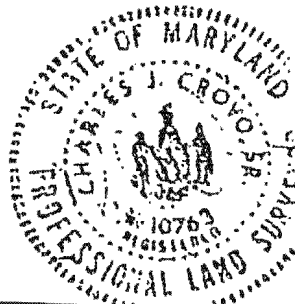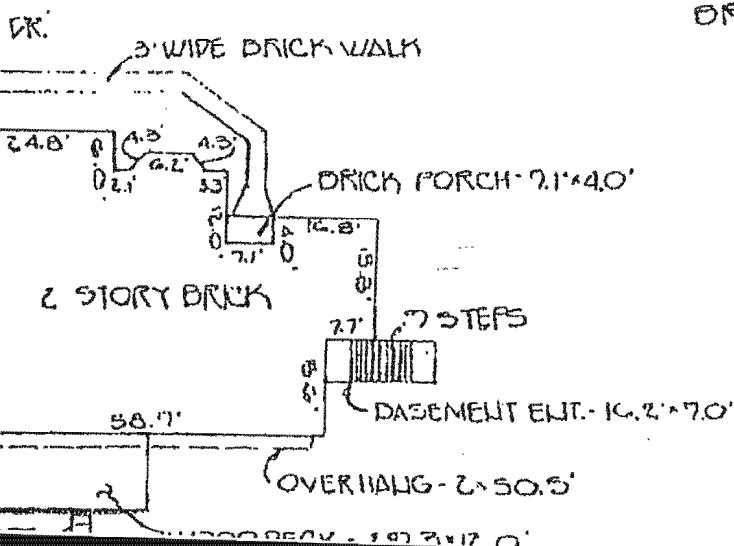

SITE INSPECTION SHEET

05-409195

OWNER: _____ PHONE #: _____


ADDRESS: 13307 Ridgewood CONTRACTOR: _____

WELL TAG #: _____

SUBDIVISION: _____ LOT: _____ COUNTY #: _____

PROPOSAL: Deck permit - need to locate S. Tank

LOCATION DIAGRAM

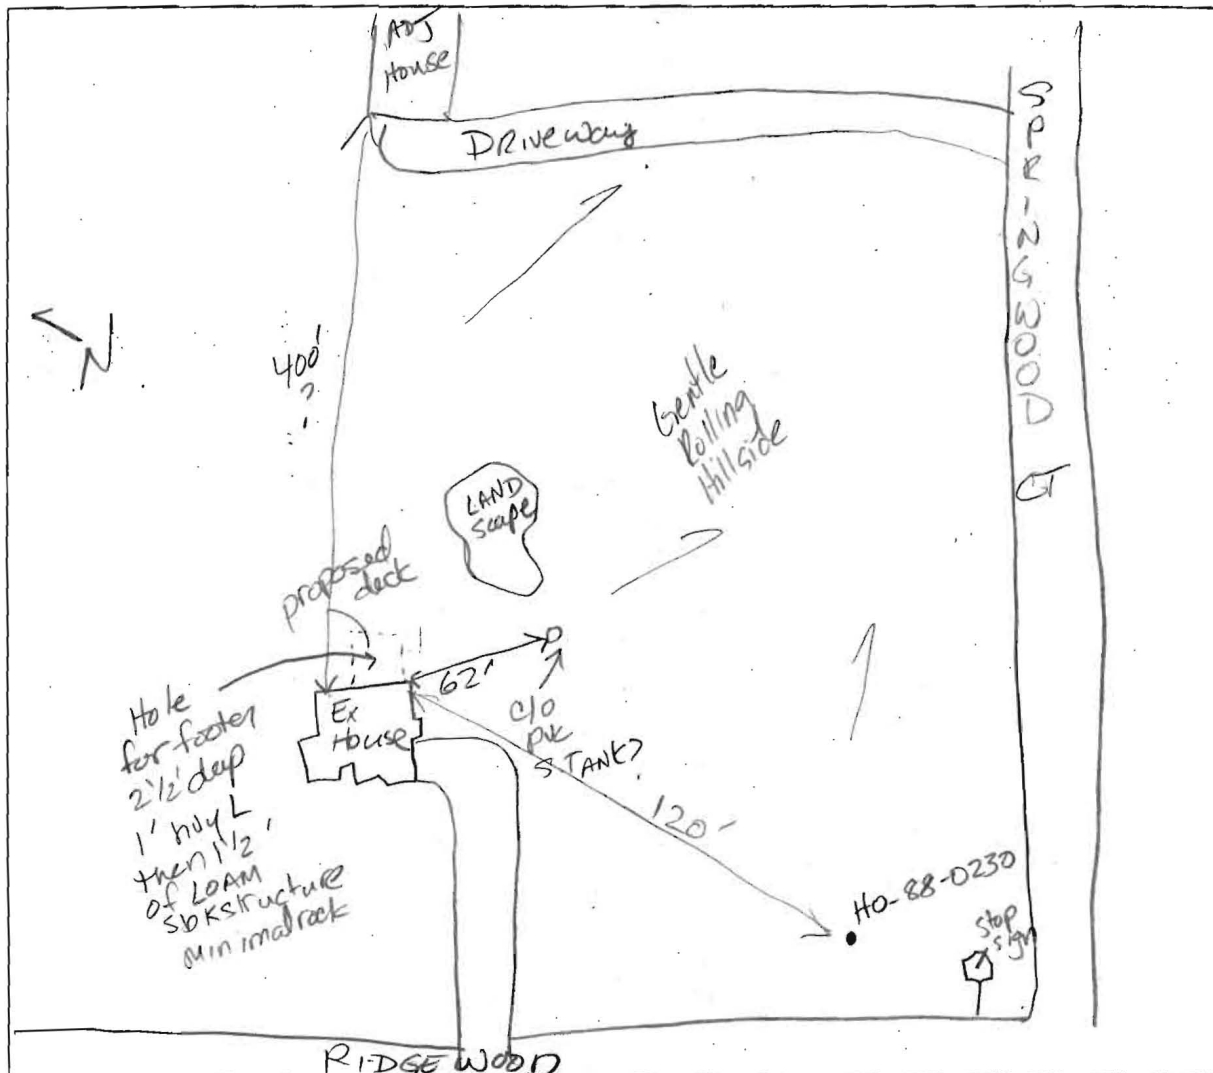

COMMENTS: 5/3/05 No evidence of S. Tank near
proposed deck location - OK to build (KN)

DATE: 5/3/05INSPECTOR: Rae Noonan