

APPROVED

BP# 60054021 A#

5.84°27

DATE: 5/25/05

DESC. OF WORK

Arch on some postscript

If any questions, call

2-177

or
1775

3.192 AC

2

Patricia B. Greenwald

NOTE: No title report furnished.

CERTIFICATION: This is to certify that the improvements



LANDTECH ASSOCIATES, INC.
1410 CRAIN HIGHWAY N.W. SUITE 70
GLEN BURNIE, MARYLAND 21061
(301) 768-2121

APPROVED

WALK-THRU BUILDING PERMIT


BP# 600154021 A#

APPROVED DATE: 5/25/05

DESC. OF WORK: replacing
potholes on same footprint

If any questions,
call
X 1771

or
1775

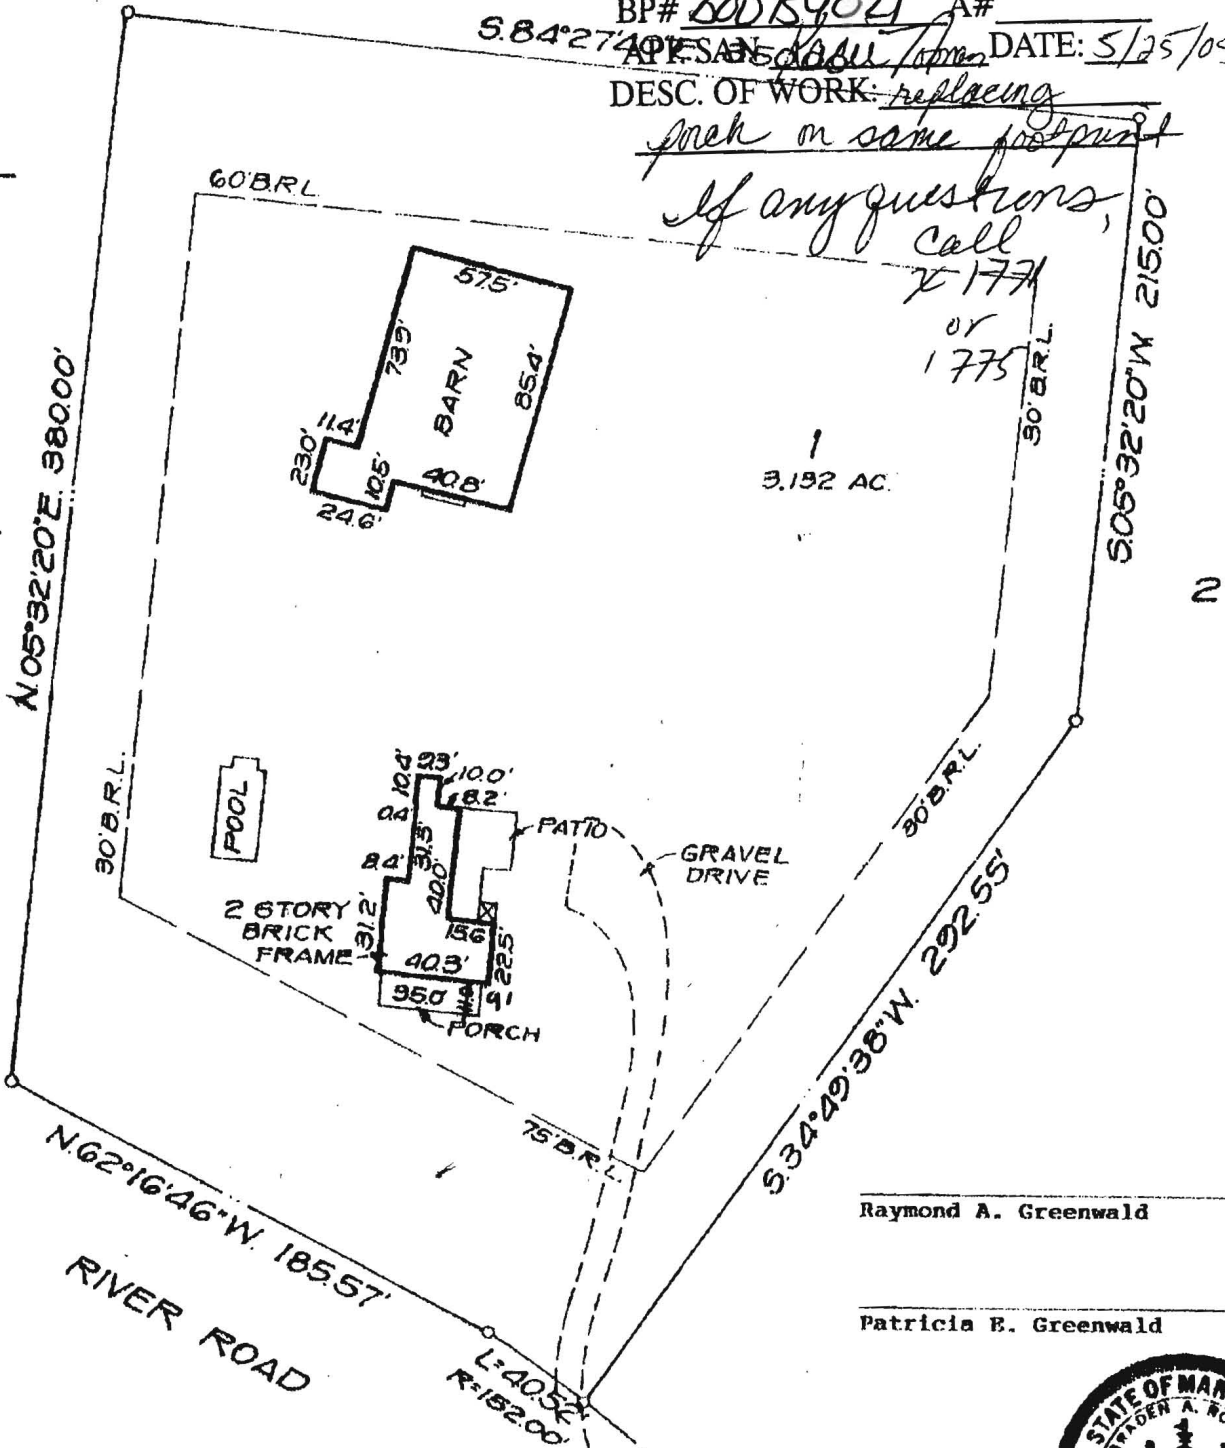

Raymond A. Greenwald

Patricia E. Greenwald

