

HOWARD COUNTY
PERMIT APPLICATION

PERMIT NUMBER

B00157462

Building Address 6602 SWING COURT
Clark 21029
Suite/Apt. #: _____ SDP/MWP/Petition #: _____
Census Tract 605102 Subdivision Clarkville R-28
Section _____ Area _____ Lot 9
Tax Map 35 Parcel 183 Grid 21
Zoning RR-DEP Map Coordinates 14111 Lot size 1.07 A

Existing Use SINGLE FAM. DWELLING
Proposed Use ADDITIONAL GARAGE 1 CAR
Estimated Construction Cost \$ 45,500.
Description of Work 11 1/2 FT. X 22 FT.
ADDITIONAL GARAGE

Occupant or Tenant _____
Contact Name _____
Address _____
City _____ State _____ Zip Code _____
Phone _____ Fax _____

Property Owner's Name PHILIP A. MALKUS
Address 6602 SWING COURT
City CLARKSVILLE State MD Zip Code 21029-105
Home Phone 410-531-5918 Work Phone NONE
Applicant's Name & Mailing Address, (if other than stated hereon):
Phone _____ Fax _____

Contractor Company RENOVATIONS+REMODELING, INC.
OWNER - MR. ROCKY MILLS
Contact Person MR. BARRY CORDELLI
Address 1108 HOODS MILL RD.
City WOODBINE State MD Zip Code _____
License No. 1120810
Phone 410-549-7703 Fax 1-442-867-5320

Engineer or Architect Company _____
Contact Person BARRY CORDELLI
Address _____
City _____ State _____ Zip Code _____
Phone _____ Fax _____

BUILDING DESCRIPTION - COMMERCIAL

Building Characteristics	Utilities
Height: _____	Water Supply: _____ Public _____ Private _____
No. of stories: _____	Sewage Disposal: _____ Public _____ Private _____
Gross area, sq. ft. per floor: _____	Electric Yes ☐ No ☐ Gas Yes ☐ No ☐
Use group: _____	Heating System: _____ Electric ☐ Oil ☐ Natural Gas ☐ Propane Gas ☐
Construction type: _____ Reinforced Concrete _____ Structural Steel _____ Masonry _____ Wood Frame _____ State Certified Modular _____	Sprinkler system: N/A ☐ Full _____ Partial _____ Other Suppression _____ # of Heads _____

BUILDING DESCRIPTION - RESIDENTIAL

Building Characteristics	Utilities
SF Dwelling ☐ SF Townhouse ☐ Depth _____ Width _____	Water Supply: _____ Public ☒ Private ☒
1st floor: _____	Sewage Disposal: _____ Public _____ Private ☒
2nd floor: _____	Electric Yes ☐ No ☐ Gas Yes ☐ No ☐
Basement: _____	Heating System: _____ Electric ☐ Oil ☐ Natural Gas ☐ Propane Gas ☐
Finished Basement ☐ Unfinished Basement ☐ Crawl space ☐ Slab on Grade ☐ No. of Bedrooms _____	Sprinkler system: N/A ☐ NFA #13D _____ NFA #13R _____ Other: _____
Height: _____	
Multi-family dwellings: _____	
No. of efficiency units: _____	
No. of 1 BR units: _____	
No. of 2 BR units: _____	
No. of 3 BR units: _____	
Other Structure: <u>1 CAR BRICK GARAGE</u> Dimensions: <u>11 1/2 FT. X 22 FT.</u> Footings: _____ Roof Height: _____	
State Certified Modular _____ Manufactured Home _____	

THE UNDERSIGNED HEREBY CERTIFIES AND AGREES AS FOLLOWS: (1) THAT HE/SHE IS AUTHORIZED TO MAKE THIS APPLICATION; (2) THAT THE INFORMATION IS CORRECT; (3) THAT HE/SHE WILL COMPLY WITH ALL REGULATIONS OF HOWARD COUNTY WHICH ARE APPLICABLE THERETO; (4) THAT HE/SHE WILL PERFORM NO WORK ON THE ABOVE REFERENCED PROPERTY NOT SPECIFICALLY DESCRIBED IN THIS APPLICATION; (5) THAT HE/SHE GRANTS COUNTY OFFICIALS THE RIGHT TO ENTER ONTO THIS PROPERTY FOR THE PURPOSE OF INSPECTING THE WORK PERMITTED AND POSTING NOTICES.

Philip A. Malkus
Applicant's Signature

PHILIP A. MALKUS
Print Name
12-22-05
Date

Title/Company

Checks payable to: **DIRECTOR OF FINANCE OF HOWARD COUNTY**
** PLEASE WRITE NEATLY AND LEGIBLY. **

FOR OFFICE USE ONLY

AGENCY	DATE	SIGNATURE APPROVAL
Land Development, DPZ		
State Highway		
Building Official		
Dev. Engineering, DPZ		
Health	<u>1/3/06</u>	<u>[Signature]</u>
Fire Protection		
Is Sediment Control approval required prior to issuance?		
YES ☐ NO ☐		

DPZ SETBACK INFORMATION	PROPERTY IDE
Front: _____	Filing fee \$ <u>25.00</u>
Rear: _____	Permit fee \$ _____
Side: _____	Excise tax \$ _____
Side St: _____	Add'l per. fee \$ _____
All minimum setbacks met?	TOTAL FEES \$ _____
YES ☐ NO ☐	Sub-total paid \$ _____
Is Entrance Permit required?	Balance due \$ _____
YES ☐ NO ☐	Check # <u>1741</u>
Historic District?	Validation # <u>103763</u>
YES ☐ NO ☐	
Lot Coverage for New Town Zone _____	
SDP/Red-line approval date _____	

Accepted by [Signature]

Distribution of Copies: White: Building Official Green: LDD, DPZ Yellow: DED, DPZ Pink: Health Gold: SHA
T:\forms\PERMIT.FRM


Rev. 11/4/04

NEW GARAGE
↓



ok as shown
1/3/06 (SF)

MD. STATE GRID MERIDIAN

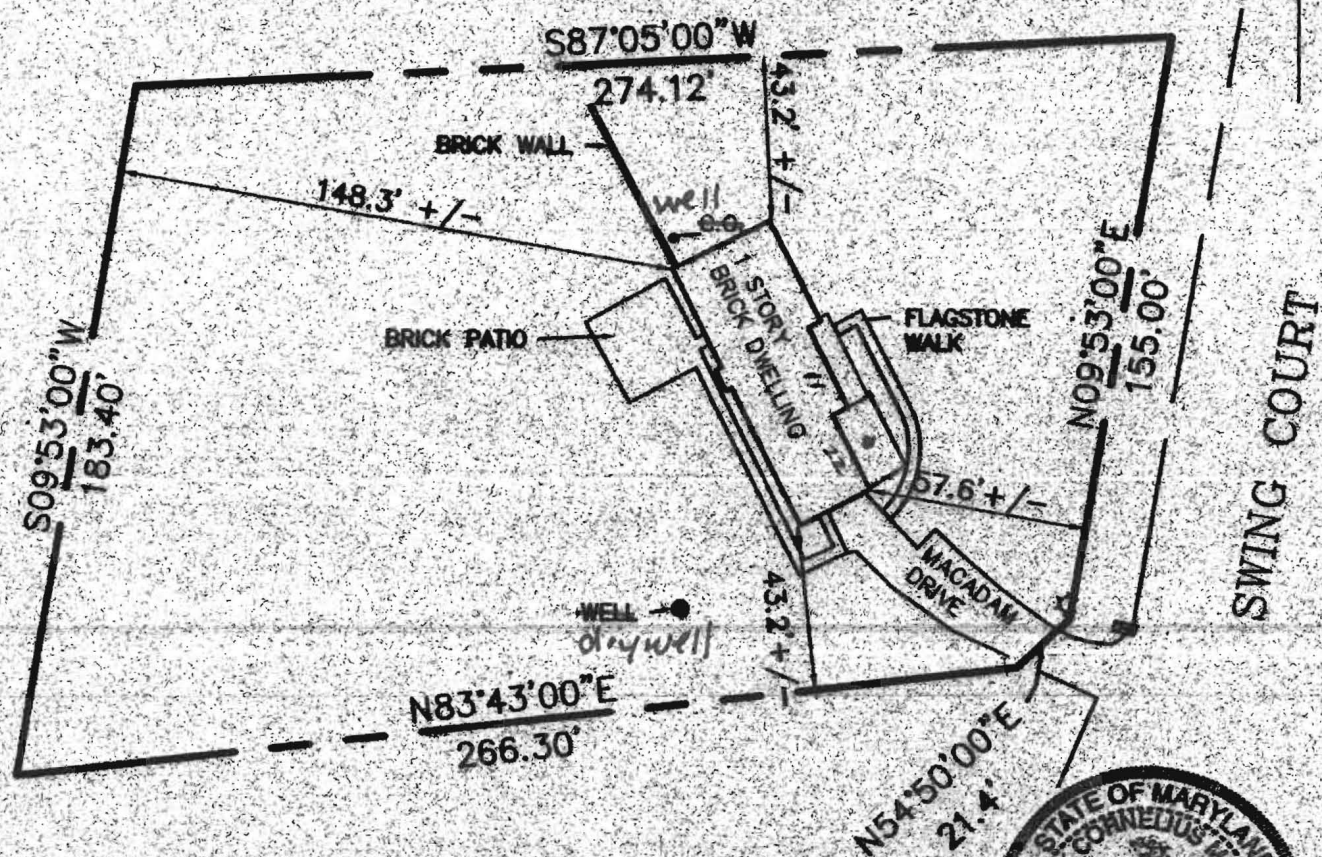

LOT 9, SEC. 1
CLARKSVILLE RIDGE



RECORD REFERENCES	LOCATION DRAWING	MARKS & ASSOCIATES L.L.C.
LIBER/FOLIO 3738/388	6602 SWING COURT	ENGINEERING - SURVEYING - LAND PLANNING 4531 COLLEGE AVENUE ELLICOTT CITY, MARYLAND TELEPHONE (410)747-8738 FAX (410)747-8739
PLAT BOOK	HOWARD COUNTY, MARYLAND	I HEREBY CERTIFY, THAT THE IMPROVEMENTS ARE LOCATED AS SHOWN HEREON AND TO THE BEST OF MY KNOWLEDGE AND BELIEF THERE ARE NO ENCROACHMENTS EXCEPT AS SHOWN.
PLAT NO./FOLIO		
SCALE 1"=50'		ERIK C. MARKS R.P.L.S. #607
DATE 8-21-2005		

Site inspection notes:

1/3/06 (SF)


NEW GARAGE



neighboring well 7'00'

MD STATE GRID MERIDIAN

SWING COURT

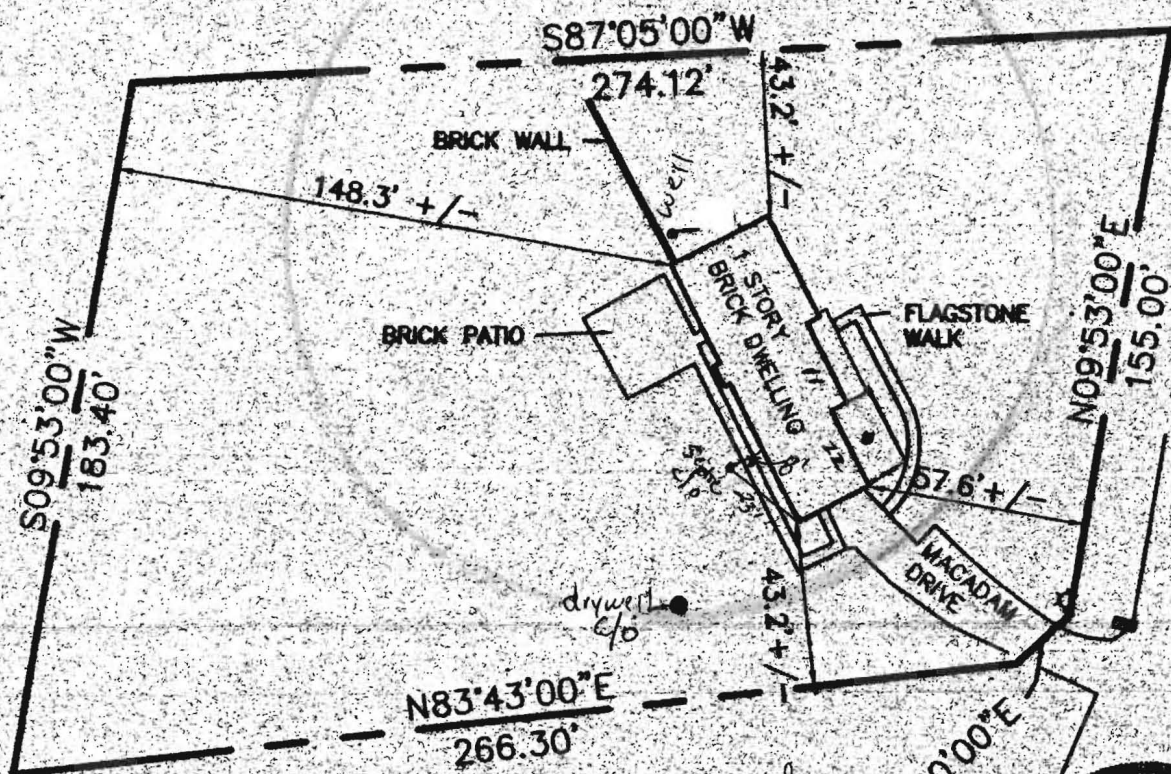

LOT 9, SEC. 1
CLARKSVILLE RIDGE

neighboring well 7'00'



RECORD REFERENCES

LIBER/FOLIO 3738/300

PLAT BOOK

PLAT NO./FOLIO

SCALE 1"=50'

DATE 8-21-2005

LOCATION DRAWING

6602 SWING COURT

HOWARD COUNTY, MARYLAND

MARKS & ASSOCIATES L.L.C.

ENGINEERING - SURVEYING - LAND PLANNING
4531 COLLEGE AVENUE ELLICOTT CITY, MARYLAND
TELEPHONE (410)747-8738 FAX (410)747-8739

I HEREBY CERTIFY, THAT THE IMPROVEMENTS ARE LOCATED AS SHOWN HEREON AND TO THE BEST OF MY KNOWLEDGE AND BELIEF THERE ARE NO ENCROACHMENTS EXCEPT AS SHOWN.

Erik C. Marks

ERIK C. MARKS R.P.L.S. #607

SITE INSPECTION SHEET

OWNER: _____ PHONE #: _____

ADDRESS: 6602 Swing Crt CONTRACTOR: _____

WELL TAG #: _____


SUBDIVISION: _____ LOT: _____ COUNTY #: _____

PROPOSAL: verify garage addition location and status of septic system.

LOCATION DIAGRAM

See attached site inspection
on 1/3/06 (SF)

Dry well:

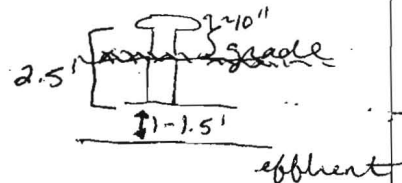

COMMENTS: New garage location okay, not an area for septic due to proximity to house. Dry well functioning okay, effluent levels are 1-1.5' below c/p. No appearance of failing system. 1/3/05 (SF)

DATE: _____