

LAYOUT \_\_\_\_\_ INSP 4 \_\_\_\_\_  
INSP 2 \_\_\_\_\_ INSP 5 \_\_\_\_\_  
INSP 3 \_\_\_\_\_ INSP 6 \_\_\_\_\_

ISSUE DATE: \_\_\_\_\_

APPROVAL DATE: \_\_\_\_\_

**PERMIT**

INDEXED

TAX ID # 02-237385

**ON-SITE SEWAGE DISPOSAL SYSTEM  
HOWARD COUNTY HEALTH DEPARTMENT  
BUREAU OF ENVIRONMENTAL HEALTH**

P \_\_\_\_\_

A 525572

\_\_\_\_\_ IS PERMITTED TO INSTALL ☒ ALTER ☐

ADDRESS: \_\_\_\_\_ PHONE NUMBER: \_\_\_\_\_

SUBDIVISION: \_\_\_\_\_ LOT NUMBER: \_\_\_\_\_

ADDRESS: 4606 Westhill Road PROPERTY OWNER: Bonnie Trey

SEPTIC TANK CAPACITY (GALLONS): \_\_\_\_\_ OUTLET BAFFLE FILTER REQUIRED ☐

PUMP CHAMBER CAPACITY (GALLONS): \_\_\_\_\_ COMPARTMENTED TANK REQUIRED ☐

NUMBER OF BEDROOMS: \_\_\_\_\_

SQUARE FEET PER BEDROOM: \_\_\_\_\_

\* PUBLIC WATER \*

LINEAR FEET OF TRENCH REQUIRED: \_\_\_\_\_

TRENCHES:	Trench to be _____ feet wide. Inlet _____ feet below original grade. Bottom maximum depth _____ feet below original grade. Effective area begins at _____ feet below original grade. _____ feet of stone below distribution pipe.	
LOCATION:	<b>BUILDING PERMIT SIGNED AND RETURNED</b>	
NOTES:	9/14/06 806003403 Shed	

PLANS APPROVED: \_\_\_\_\_ DATE: \_\_\_\_\_

NOTE: PERMIT VOID AFTER 2 YEARS

NOTE: CONTRACTOR RESPONSIBLE FOR SCHEDULING A PRE-CONSTRUCTION INSPECTION FOR ALL INSTALLATIONS

NOTE: WATERTIGHT SEPTIC TANKS REQUIRED

NOTE: ALL PARTS OF SEPTIC SYSTEM SHALL BE 100 FEET FROM ANY WATER WELL

NOTE: MANHOLE RISERS REQUIRED ON ALL SEPTIC TANKS AND PUMP CHAMBERS UNLESS SPECIFICALLY AUTHORIZED

**NEITHER THE HOWARD COUNTY COUNCIL NOR THE HEALTH DEPARTMENT IS  
RESPONSIBLE FOR THE SUCCESSFUL OPERATION OF ANY SYSTEM  
PERMITTEE RESPONSIBLE FOR OBTAINING FINAL APPROVAL ON THIS PERMIT  
CALL 410-313-2640 FOR INSPECTION OF SEPTIC SYSTEM**


Sept. 14, 2006

SITE INSPECTION SHEET


OWNER: Bonnie Marie Trey PHONE #: \_\_\_\_\_  
ADDRESS: 4606 Westhill Rd. CONTRACTOR: \_\_\_\_\_  
Ellicott City 21043 WELL TAG #: \_\_\_\_\_  
SUBDIVISION: \_\_\_\_\_ LOT: \_\_\_\_\_ COUNTY #: \_\_\_\_\_  
PROPOSAL: Build shed (12'x20') in back yard


LOCATION DIAGRAM

Not To Scale

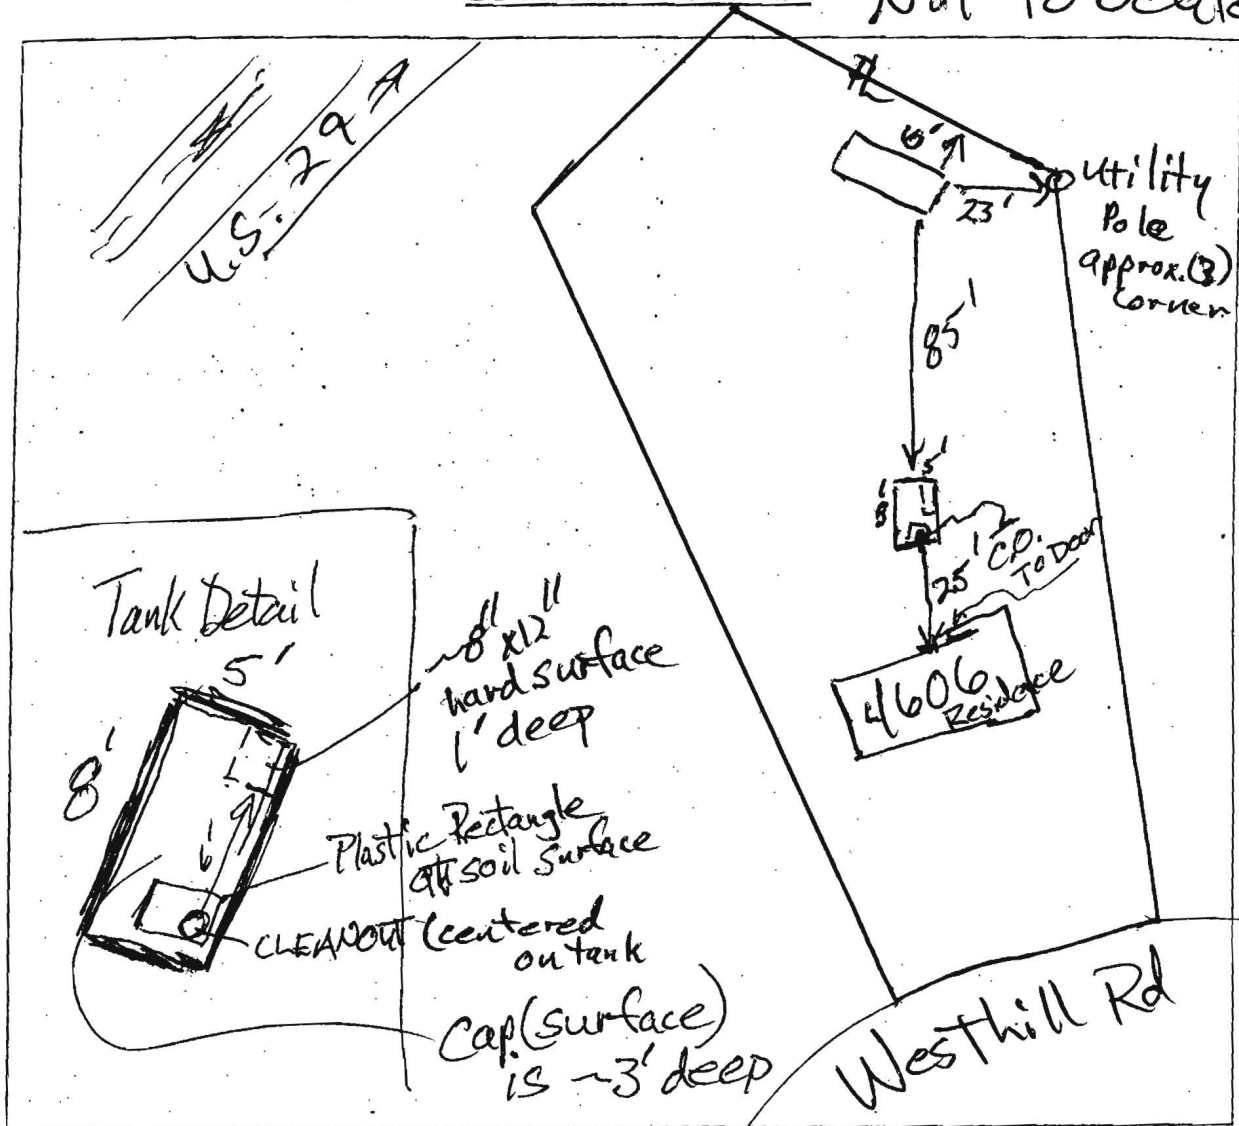

COMMENTS: Shed in Place (re: already built), re: No foundation, but slab.  
House constructed 1958; tank 5' x 8' found. No other septic  
components located; no records of installation/repair.  
Tank is ~85' from shed, septic trench within 10' is unlikely.

SAVING & EXCEPTING PARCELS - Cross hatched  Acquired by SHA For Highway Widening, LIBER 482, FOLIO 404 & LIBER 1364, FOLIO 313, PLATS 27514, 35071, 40716

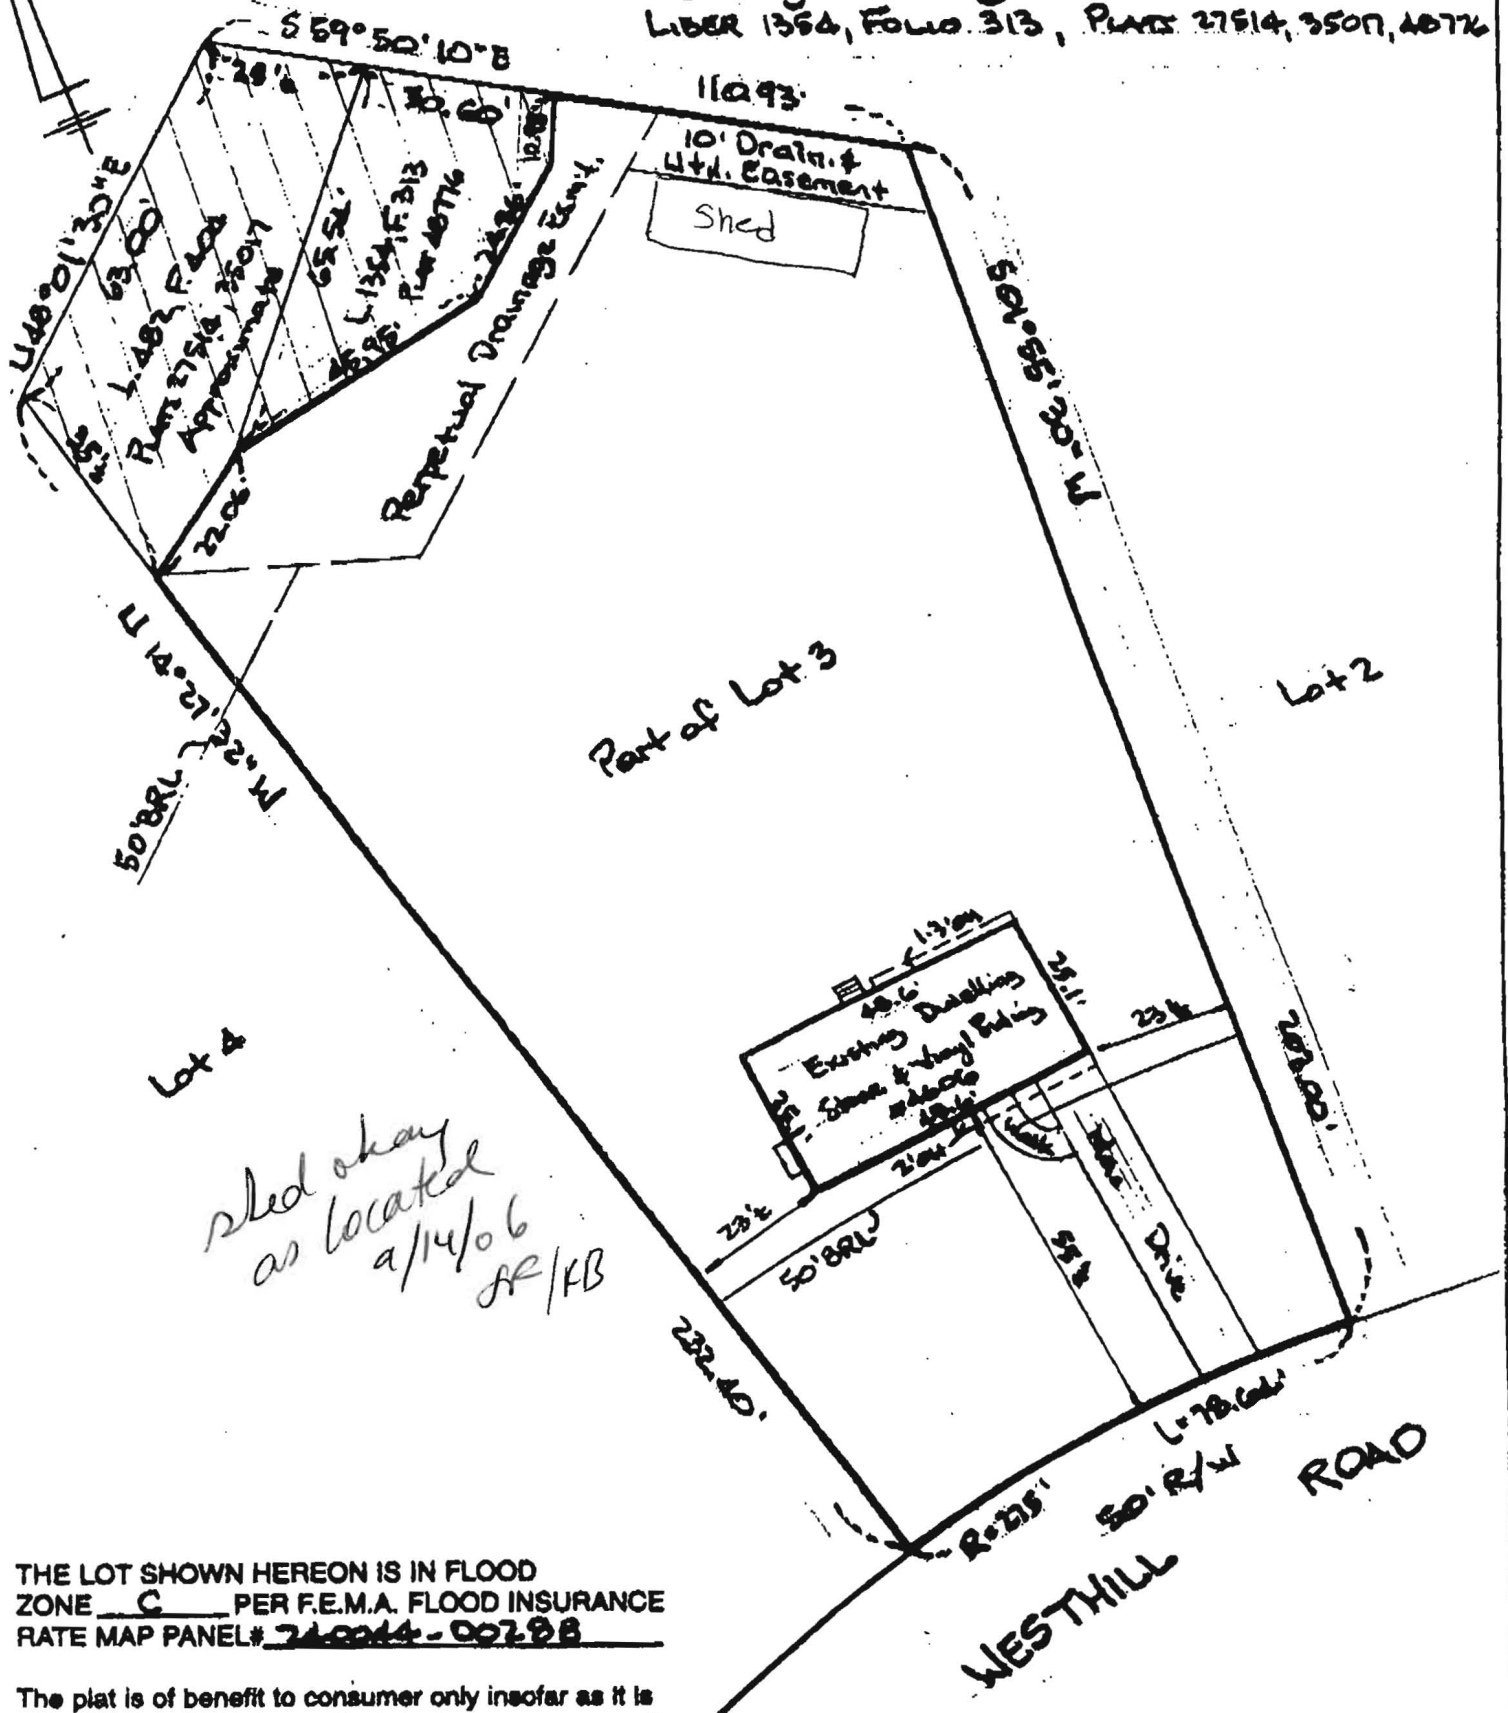

THE LOT SHOWN HEREON IS IN FLOOD ZONE C PER F.E.M.A. FLOOD INSURANCE RATE MAP PANEL# 240044-00208

The plat is of benefit to consumer only insofar as it is required by a lender or a title insurance company or its agent in connection with contemplated transfer, financing, or refinancing. The plat is not to be relied upon for the establishment or location of fences, garages, buildings, or other existing or future improvements. The plat does not provide for the accurate identification of property boundary lines, but such identification may not be required for the transfer of title or securing financing or refinancing. The plat contains a tolerance of accuracy of two feet, more or less.

### Ertel Associates, Inc.

8425 Hallmark Circle  
Baltimore, Maryland 21234  
Phone: 410-882-0989 • Fax: 410-882-0842

### LOCATION Drawing

#4606 Westhill Road, Part of Lot 3  
"SECT. ONE, COLUMBIA HILLS" HOMES Co., MD.  
PAT 6/2 SAVING & EXCEPT 1364/313, 482/404

DATE:

7/10/05

SCALE:

1"=30'

FILE:

05-0658-09 DRA