

DEPARTMENT OF INSPECTIONS, LICENSES AND PERMITS
3430 COURT HOUSE DRIVE
ELLICOTT CITY, MD 21043
PERMITS (410)313-2455 INSPECTIONS (410)313-1810
AUTOMATED INFORMATION (410) 313-3800

HOWARD COUNTY
PERMIT APPLICATION

PERMIT NUMBER
1300134023

Building Address 114498 Philadelphia Mill Rd
Suite/Apt. #: SDP/WP/Petition #:
Census Tract 605101 Subdivision
Section Area Lot
Tax Map 27 Parcel 139 Grid 17
Zoning RR Map Coordinates Lot size
Existing Use Single Family Dwelling
Proposed Use POLE BARN
Estimated Construction Cost \$ 2000
Description of Work Building a Pole Barn
30x40 ONE STORY SURFACE
TRACTOR HOUSES
Occupant or Tenant SAME
Contact Name
Address
City State Zip Code
Phone Fax

Property Owner's Name John Hanlon
Address
City State Zip Code
Home Phone 301-917-9435 Work Phone
Applicant's Name & Mailing Address (if other than stated hereon):
Prop. O Jake Hanlon
Phone Fax
Contractor Company
Contact Person
Address
City State Zip Code
License No.
Phone Fax
Engineer or Architect Company
Contact Person
Address
City State Zip Code
Phone Fax

BUILDING DESCRIPTION - COMMERCIAL

Building Characteristics

Utilities

BUILDING DESCRIPTION - RESIDENTIAL

Building Characteristics

Utilities

THE UNDERSIGNED HEREBY CERTIFIES AND AGREES AS FOLLOWS: (1) THAT HE/SHE IS AUTHORIZED TO MAKE THIS APPLICATION; (2) THAT THE INFORMATION IS CORRECT; (3) THAT HE/SHE WILL COMPLY WITH ALL REGULATIONS OF HOWARD COUNTY WHICH ARE APPLICABLE THERETO; (4) THAT HE/SHE WILL PERFORM NO WORK ON THE ABOVE REFERENCED PROPERTY NOT SPECIFICALLY DESCRIBED IN THIS APPLICATION; (5) THAT HE/SHE GRANTS COUNTY OFFICIALS THE RIGHT TO ENTER ONTO THIS PROPERTY FOR THE PURPOSE OF INSPECTING THE WORK PERMITTED AND POSTING NOTICES.

Applicant's Signature
Date

Print Name
Date

Checks payable to: DIRECTOR OF FINANCE OF HOWARD COUNTY
** PLEASE WRITE NEATLY AND LEGIBLY. **
FOR OFFICE USE ONLY

AGENCY
and Development, DPZ
State Highways
Building Official
Dev. Engineering, DPZ
Health
Fire Protection
Is Sediment Control approval required prior to issuance?
YES ☐ NO ☐
CONTINGENCY CONSTRUCTION START: ☐
ONE STOP SHOP: ☐

DATE
1/24/02
SIGNATURE APPROVAL
Karin Goodly

DPZ SETBACK INFORMATION
Front:
Rear:
Side:
Side St.:
All minimum setbacks met?
YES ☐ NO ☐
Is Entrance Permit required?
YES ☐ NO ☐
Historic District?
YES ☐ NO ☐
Lot Coverage for New Town Zone
SDP/Red-line approval date

PROPERTY ID#
Filing fee \$
Permit fee \$
Excise tax \$
Add'l per. fee \$
TOTAL FEES \$
Sub-total paid \$
Balance due \$
Check #
Validation #
Accepted by

APPROVED

WALK-THRU BUILDING PERMIT

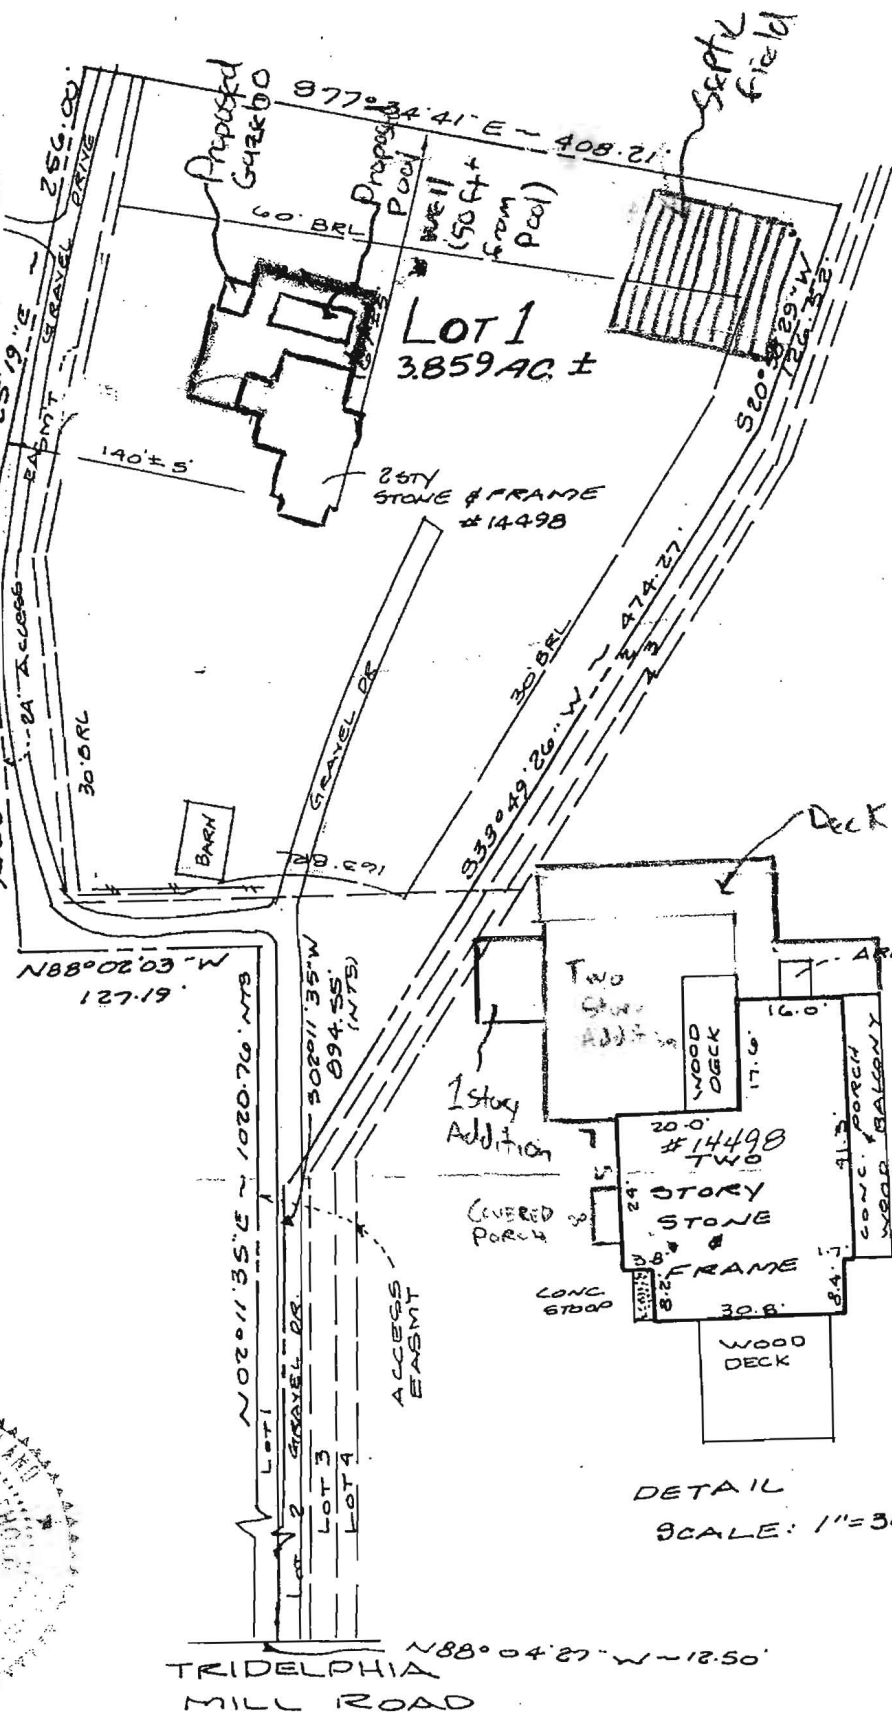
BP# 08001272 A# 49475

APP. SAN HS

DATE: 4-30-08

DESC. OF WORK: 18' x 44' inground pool and gazebo

MD. ST. PLANE (NAD83)



*** - Fence & Retaining Wall

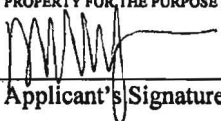
--- - Fence

DETAIL
SCALE: 1"=30'

o evidence of property corners was found. Apparent occupation is shown.

Date: 06-21-99 Scale: 1"=100' Drn: SJW
Plat Book:

Surveyor's Certification

DEPT. OF INSPECTIONS, LICENSES AND PERMITS 3430 COURT HOUSE DRIVE ELLICOTT CITY, MD 21043 PERMITS (410) 313-2455 INSPECTIONS (410) 313-1810 AUTOMATED INFORMATION (410) 313-3800		HOWARD COUNTY PERMIT APPLICATION	B08001272 PERMIT NUMBER
* Building Address <u>14498 Triadelphia Mill Rd</u> <u>Dayton MD 21030</u>		Property Owner's Name <u>John Hanlon</u> Address <u>14498 Triadelphia</u> City <u>Dayton</u> State <u>MD</u> Zip Code <u>21030</u> Phone <u>3017794555</u> Phone <u>410 531 6069</u> Applicant's Name & Mailing Address, (if other than stated herein): <u>Same</u>	
Suite/Apt. #: _____ SDP/WP/Petition #: _____		Phone _____ Fax <u>202 244 0808</u>	
Census Tract _____ Subdivision _____		Contractor Company <u>Hanlon Design Building, Inc</u>	
Section _____ Area _____ Lot _____		Contact Person <u>John Hanlon</u>	
Tax Map _____ Parcel _____ Grid _____		Address <u>4927 Eskridge Terrace</u>	
Zoning _____ Map Coordinates _____ Lot Size _____		City <u>Washington</u> State <u>DC</u> Zip Code <u>20016</u>	
Existing Use <u>SSD</u>		License No. <u>3683444</u> <u>120906</u>	
Proposed Use <u>SSD with pool and gazebo</u>		Phone <u>202 244 2942</u> Fax <u>202 244 0808</u>	
Estimated Construction Cost \$ <u>40K</u>		Engineer or Architect Company <u>Hanlon Design Build, Inc</u>	
Description of Work <u>16x44 in ground</u> <u>pool & gazebo</u>		Contact Person <u>John Hanlon</u>	
Occupant or Tenant _____		Address <u>4927 Eskridge Terrace</u>	
Contact Name _____		City <u>Washington</u> State <u>DC</u> Zip Code <u>20016</u>	
Address _____		Phone <u>202 244 2942</u> Fax <u>202 244 0808</u>	
City _____ State _____ Zip Code _____		2942	
Phone _____ Fax _____			
BUILDING DESCRIPTION - COMMERCIAL		BUILDING DESCRIPTION - RESIDENTIAL	
Building Characteristics Height: _____ No. of stories: _____ Gross area, sq. ft. per floor: _____ Use group: _____ Construction type: ____ Reinforced Concrete ____ Structural Steel ____ Masonry ____ Wood Frame ____ State Certified Modular	Utilities Water Supply: ____ Public ____ Private Sewage Disposal: ____ Public ____ Private Electric Yes ☐ No ☐ Gas Yes ☐ No ☐ Heating System: Electric ☐ Oil ☐ Natural Gas ☐ Propane Gas ☐ Sprinkler system: N/A ☐ ____ Full ____ Partial ____ Other Suppression ____ # of Heads	Building Characteristics SF Dwelling ☐ SF Townhouse ☐ Depth _____ Width _____ 1 st floor: _____ 2 nd floor: _____ Basement: _____ Finished Basement ☐ Unfinished Basement ☐ Crawl space ☐ Slab on Grade ☐ No. of Bedrooms <u>2</u> Multi-family dwellings: No. of efficiency units: _____ No. of 1 BR units: _____ No. of 2 BR units: _____ No. of 3 BR units: _____ Other Structure: _____ Dimensions: _____ Footings: _____ Roof Height: _____ ____ State Certified Modular ____ Manufactured Home	Utilities Water Supply: ☒ Public ☒ Private Sewage Disposal: ____ Public ☒ Private Electric Yes ☐ No ☐ Gas Yes ☐ No ☐ Heating System: Electric ☐ Oil ☐ Natural Gas ☐ Propane Gas ☐ Sprinkler system: N/A ☐ ____ NFPA #13D ____ NFPA #13R ____ Other:
THE UNDERSIGNED HEREBY CERTIFIES AND AGREES AS FOLLOWS: (1) THAT HE/SHE IS AUTHORIZED TO MAKE THIS APPLICATION; (2) THAT THE INFORMATION IS CORRECT; (3) THAT HE/SHE WILL COMPLY WITH ALL REGULATIONS OF HOWARD COUNTY WHICH ARE APPLICABLE THERETO; (4) THAT HE/SHE WILL PERFORM NO WORK ON THE ABOVE REFERENCED PROPERTY NOT SPECIFICALLY DESCRIBED IN THIS APPLICATION; (5) THAT HE/SHE GRANTS COUNTY OFFICIALS THE RIGHT TO ENTER ONTO THIS PROPERTY FOR THE PURPOSE OF INSPECTING THE WORK PERMITTED AND POSTING NOTICES.			
 Applicant's Signature		<u>John Hanlon (Vicki Hanlon)</u> Print Name	
_____ Title/Company		_____ Date	
Checks payable to: DIRECTOR OF FINANCE OF HOWARD COUNTY **PLEASE WRITE NEATLY AND LEGIBLY.** - FOR OFFICE USE ONLY -			

RECEIVED

DATE

TIME

BY

OFFICE

HOWARD COUNTY
PERMIT APPLICATION

PERMIT NUMBER

30054883

Building Address 14498 Tridelphia Mill Rd
Dayton MD 21036
Suite/Apt. #: N/A SDP/WP/Petition #: _____
Census Tract 605101 Subdivision _____
Section _____ Area _____ Lot 1
Tax Map 27 Parcel 46 139 Grid 17
Zoning RRDPD Map Coordinates 1303 Lot size _____

Property Owner's Name John T. Hunton
Address 14498 Tridelphia Mill Rd
City Dayton State MD Zip Code 21036
Home Phone (410) 531-2190 Work Phone (202) 711-7412
Applicant's Name & Mailing Address, (if other than stated herein):
Phone (301) 717-4135 Fax (301) 774-0635

Existing Use Single Residential Home
Proposed Use Residential Home
Estimated Construction Cost \$ 100K
Description of Work 2nd Floor Deck & Porch
Family Room / Master 2FP
Wheel Bay & Dream Suite Addition
2 Bathrooms

Contractor Company Self
Contact Person Same
Address _____
City _____ State _____ Zip Code _____
License No. _____ Phone _____ Fax _____

Occupant or Tenant John Hunton
Contact Name John Hunton
Address 14498 Tridelphia Mill Rd
City Dayton State MD Zip Code 21036
Phone (301) 717-4135 Fax (301) 774-0635

Engineer or Architect Company Self
Contact Person Same
Address _____
City _____ State _____ Zip Code _____
Phone _____ Fax _____

BUILDING DESCRIPTION - COMMERCIAL

BUILDING DESCRIPTION - RESIDENTIAL

Building Characteristics	Utilities
Height: _____	Water Supply: _____ Public _____ Private _____
No. of stories: _____	Sewage Disposal: _____ Public _____ Private _____
Gross area, sq. ft. per floor: _____	Electric Yes ☐ No ☐ Gas Yes ☐ No ☐
Use group: _____	Heating System: _____ Electric ☐ Oil ☐ Natural Gas ☐ Propane Gas ☐
Construction type: _____ Reinforced Concrete _____ Structural Steel _____ Masonry _____ Wood Frame _____ State Certified Modular _____	Sprinkler system: <u>N/A</u> ☐ Full _____ Partial _____ Other Suppression _____ # of Heads _____

Building Characteristics	Utilities
SF Dwelling ☒ SF Townhouse ☐ Depth _____ Width _____	Water Supply: _____ Public _____ Private _____
1st floor: <u>27' x 12'</u>	Sewage Disposal: _____ Public _____ Private _____
2nd floor: <u>27' x 12'</u>	Electric Yes ☒ No ☐ Gas Yes ☒ No ☐
Basement: <u>finished space</u>	Heating System: _____ Electric ☒ Oil ☐ Natural Gas ☐ Propane Gas ☐
Finished Basement ☐ Unfinished Basement ☐ Crawl space ☒ Slab on Grade ☐	Sprinkler system: <u>N/A</u> ☐ NFPA #13D _____ NFPA #13R _____ Other: _____
No. of Bedrooms <u>4</u>	
Height: <u>35 feet</u>	
Multi-family dwellings: _____ No. of efficiency units: _____ No. of 1 BR units: _____ No. of 2 BR units: _____ No. of 3 BR units: _____	
Other Structure: <u>Deck</u>	
Dimensions: <u>10x37, 10x16</u>	
Footings: _____	
Roof Height: _____	
State Certified Modular _____ Manufactured Home _____	

THE UNDERSIGNED HEREBY CERTIFIES AND AGREES AS FOLLOWS: (1) THAT HE/SHE IS AUTHORIZED TO MAKE THIS APPLICATION; (2) THAT THE INFORMATION IS CORRECT; (3) THAT HE/SHE WILL COMPLY WITH ALL REGULATIONS OF HOWARD COUNTY WHICH ARE APPLICABLE THERETO; (4) THAT HE/SHE WILL PERFORM NO WORK ON THE ABOVE REFERENCED PROPERTY NOT SPECIFICALLY DESCRIBED IN THIS APPLICATION; (5) THAT HE/SHE GRANTS COUNTY OFFICIALS THE RIGHT TO ENTER ONTO THIS PROPERTY FOR THE PURPOSE OF INSPECTING THE WORK PERMITTED AND POSTING NOTICES.

Applicant's Signature John T. Hunton
Title/Company Property Owner

Print Name John T. Hunton
Date 7/12/05

Checks payable to: DIRECTOR OF FINANCE OF HOWARD COUNTY
** PLEASE WRITE NEATLY AND LEGIBLY. **

AGENCY	DATE	SIGNATURE	APPROVAL	DPZ SETBACK INFORMATION	PROPERTY FEE
Planning & Zoning				Front: _____	Filing fee \$ _____
Public Works				Rear: _____	Permit fee \$ _____
Building Official				Side: _____	Excise tax \$ _____
Dev. Engineering DPZ				Side St: _____	Add'l per. fee \$ _____
Health				All minimum setbacks met? YES ☐ NO ☐	TOTAL FEES \$ _____
Fire Protection				Is Eminent Permit required? YES ☐ NO ☐	Sub-total paid \$ _____
Is Sediment Control approval required prior to issuance?				Historic District? YES ☐ NO ☐	Balance due \$ _____
YES ☐ NO ☐				List Coverage for New Town Zone _____	Check \$ _____
CONTINGENCY CONSTRUCTION START: ☐				SDP/Red-line approval date _____	Validation \$ _____
ONE STOP SHOP: ☐				Accepted by: _____	
Distribution of Copies: _____					
White: Building Official					
Green: LDD, DPZ					
Yellow: CED, DPZ					
Pink: Health					
Gold: SHA					

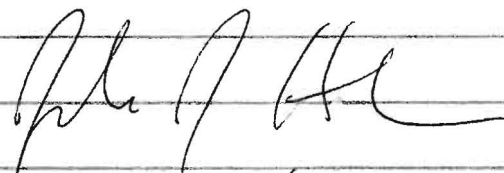
LOT 1, HARTMAN PROPERTY
14498 Triadelphia Mill Rd

605101
issued
4/1/03
PR

60825-revised
60825 dated
CA# 3-31-03
3/31/03
KN

ATTN: HOWARD COUNTY PERMITS

I REQUEST A SITE PLAN ADJUSTMENT
ON BUILDING PERMIT # B00134023-A
I WOULD LIKE TO MOVE THE
LOCATION OF THE PROPOSED POLE
BARN FROM LOCATION STATED
ON PREVIOUS PERMIT TO THE
NEW LOCATION INDICATED ON
THE SITE PLAN. THANKS


John Hannon
301-717-9435

Note - grant after
RASAD - Han-Lyn
ce: DPZ
Health Dept

4/3/03
No location
issues for
Pole Barn
KN

B00134023 (REVISED)

