

1/7/75 - *final approval S.S.*
2 *oo*

PERMIT

SEWAGE DISPOSAL SYSTEM

MARYLAND STATE DEPARTMENT OF HEALTH

HOWARD COUNTY

P 21071

A _____

ELLCOTT CITY

DISTRICT 5th

DATE 1/6/75

INDEXED

Jack Fyock IS PERMITTED TO INSTALL _____ ALTER X

ADDRESS Ten Oaks Road, Glenelg, Maryland PHONE 286-2939

A SEWAGE DISPOSAL SYSTEM LOCATED AT _____

SUBDIVISION _____ ROAD 14498 Triadelphia Mill Rd.

PROPERTY OWNER Mr. Harold Hartman (Triadelphia Mill Road at Ten Oaks Nursery - 1st into Triadelphia Road - approx. 2 miles on right)

ADDRESS 14498 Triadelphia Mill Road, Dayton, Md.

SPECIFICATIONS

DRAIN FIELD _____ DEPTH _____ FEET. BOTTOM AREA _____ SQ. FT.

SEEPAGE PITS _____ ABSORBENT SIDE-WALL AREA _____ SQ. FT.

SEPTIC TANK CAPACITY _____ GALLONS

FOR GARBAGE GRINDER, INCREASE DISPOSAL AREA 22% & TANK CAPACITY 50%.

OTHER REPAIR - Call for inspection when ground is opened up and Sanitarian will recommend repair system.


PLANS APPROVED BY Palmer F. Wine DATE 1/6/75

FILL SEPTIC TANK AND DISTRIBUTION BOX WITH WATER BEFORE CALLING FOR AN INSPECTION. COVER NO WORK UNTIL INSPECTED AND APPROVED.

NEITHER THE HOWARD COUNTY COMMISSIONERS NOR THE HEALTH DEPARTMENT IS RESPONSIBLE FOR THE SUCCESSFUL OPERATION OF ANY SYSTEM.

21071

21071

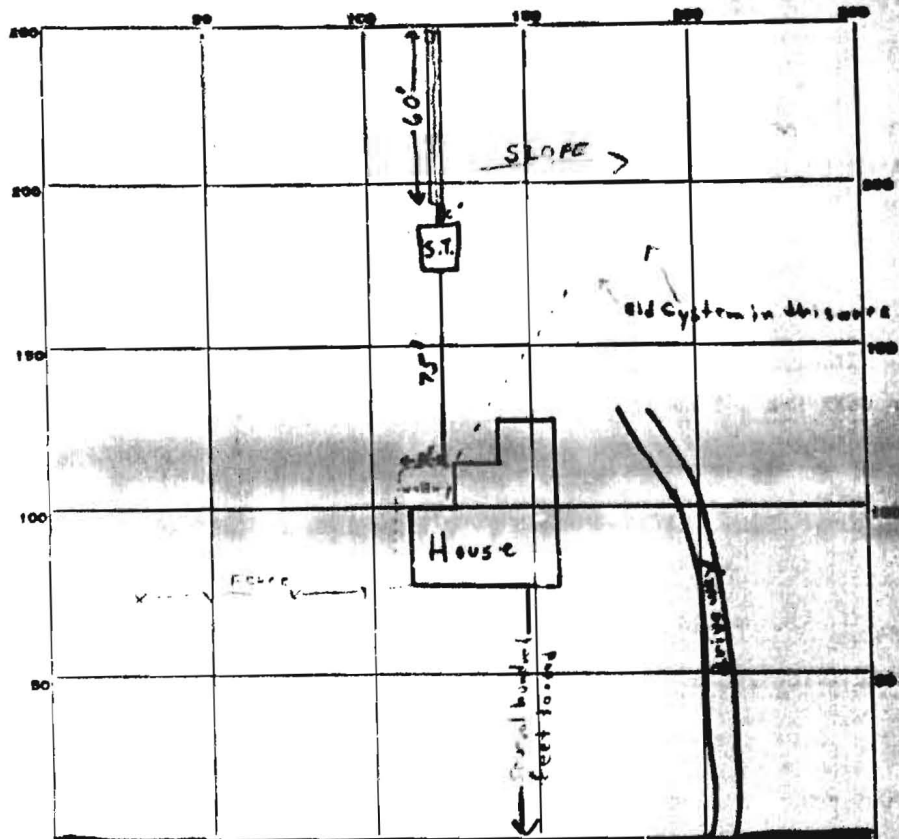

INDICATE NORTH. - NAME ADJOINING ROADWAY AS BASE LINE.

Triadelphia Mill Road

PERMIT CARD ☒ *Sign and cover all work*

SEPTIC TANK, LEVEL ☒ *1000 gal.*

CLEANOUTS ☒ *S.T.*

DISTRIBUTION BOX, LEVEL _____

Trench TILE FIELD, DEPTH 11 FT. TRENCH WIDTH 2 FT.

GRAVEL DEPTH 7 FT. TOTAL LENGTH 60 FT.

NUMBER OF TRENCHES 1 *1/2 Sidewall* TOTAL BOTTOM AREA 420 SQ. FT.

SEEPAGE PITS, INSIDE DIAMETER _____ FT. DEPTH BELOW INLET 7 FT.

ABSORBENT AREA 420 SQ. FT.

REMARKS 1/7/75 Trench 11 ft deep; Inlet at 4 ft below grade; Soil type is
sandy loam S.S.

DATE SYSTEM APPROVED 1/7/75

INSPECTOR F. Skinner