

CLARKSVILLE
OVERLOOK
Δ 6192

LOT 2

S 18° E

(300.30 - 32.00) = 268.30'

TEN OAKS ROAD
300.30'

518.7
33.8
552.5
MATCH
LINE

17 N 91 1/2° W

313.50'

1252/177

APPROVED
WALK-THRU BUILDING PERMIT

BP# 60053288 #
APP SAN 194
DATE: 4/21/05
DESC. OF WORK
Deck

596/370
(DESCRIBED IN
172/378)

OLD TITLE LINE IN 78/358

N 79° 16' E

2ND - 238.06'

596/370
(DESCRIBED AS FIRST
PARCEL IN 67/176)

TITLE LINE IN
172/378

TRAILER ON
CONC. FOUNDATION
(POSSIBLE ENCROACHMENT)

240'
1STY. BLOCK
FRAME
Dwg. 3/01/05

18'0" IF 60'
1STY. W
FRAME
Dwg. 3/01/05

CONC. PORCH
Dwg. 3/01/05

S 5° E

190.04' = (178.82' + 11.18')

ERROR IN
DEED 67/176
33.2'

80/470
OLD SAINT LOUIS
CHURCH

SAVING
&
EXCEPTING
78/359

AREA OF OCCUPATION
IE: MACADAM DRIVES
GRAVEL PARKING, SHELS
ALSO USED AS INGRESS
& EGRESSTO TEN OAKS
ROAD
(POSSIBLE ENCROACH-
MENT)

* NOTE: RIGHT OF WAY FOR
INGRESS AND EGRESSTO A
PUBLIC ROAD RECORDED IN
L. 91 F. 136, BUT IS NOT BEING
USED.

Robert J. Wilson
ROBERT J. WILSON

FLOOD CERTIFICATION

ANNE J. WILSON

SUBJECT PROPERTY IS SHOWN IN ZONE C AS SHOWN ON
COMMUNITY PANEL 240044 0032 EFFECTIVE DATE DEC 4, 1986

THIS PLAT IS NOT INTENDED TO BE USED FOR THE PURPOSE
OF ESTABLISHING PROPERTY LINES OR POINTS AND WAS
PREPARED WITHOUT THE BENEFIT OF A TITLE REPORT




TEN OAKS ROAD

TAX ID 05-372569
SITE INSPECTION SHEET

OWNER: Debbie Wilson PHONE #: 301-854-2320
ADDRESS: 5924 TEN OAKS RD CONTRACTOR: _____
WELL TAG #: _____
SUBDIVISION: _____ LOT: _____ COUNTY #: _____
PROPOSAL: Deck BUD 153288

LOCATION DIAGRAM

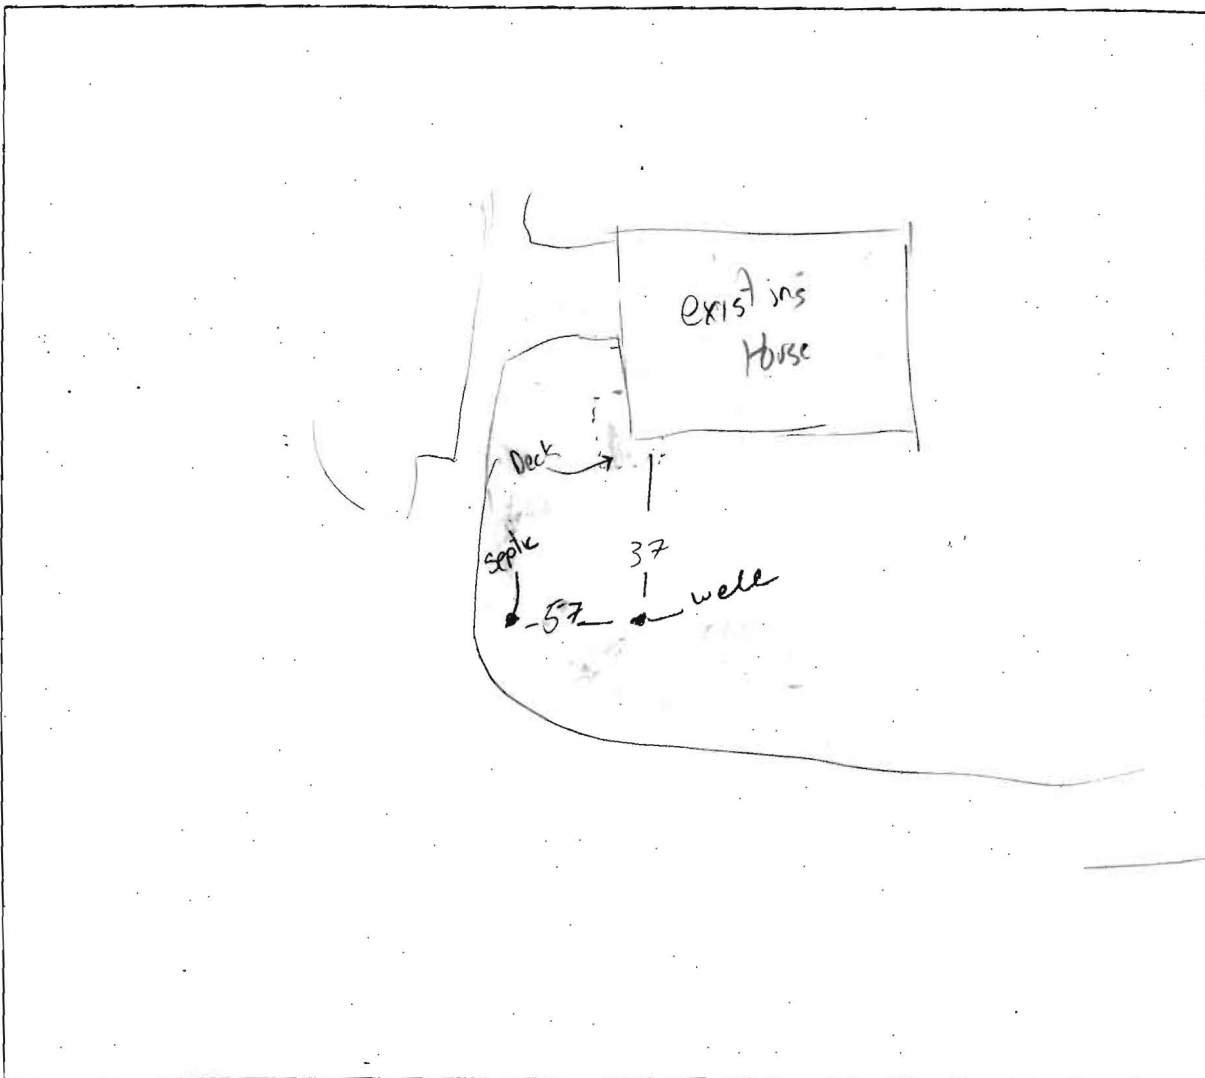

COMMENTS: Proposed Deck will not affect well or Septic

DATE: 4/21/05 INSPECTOR: KTB